


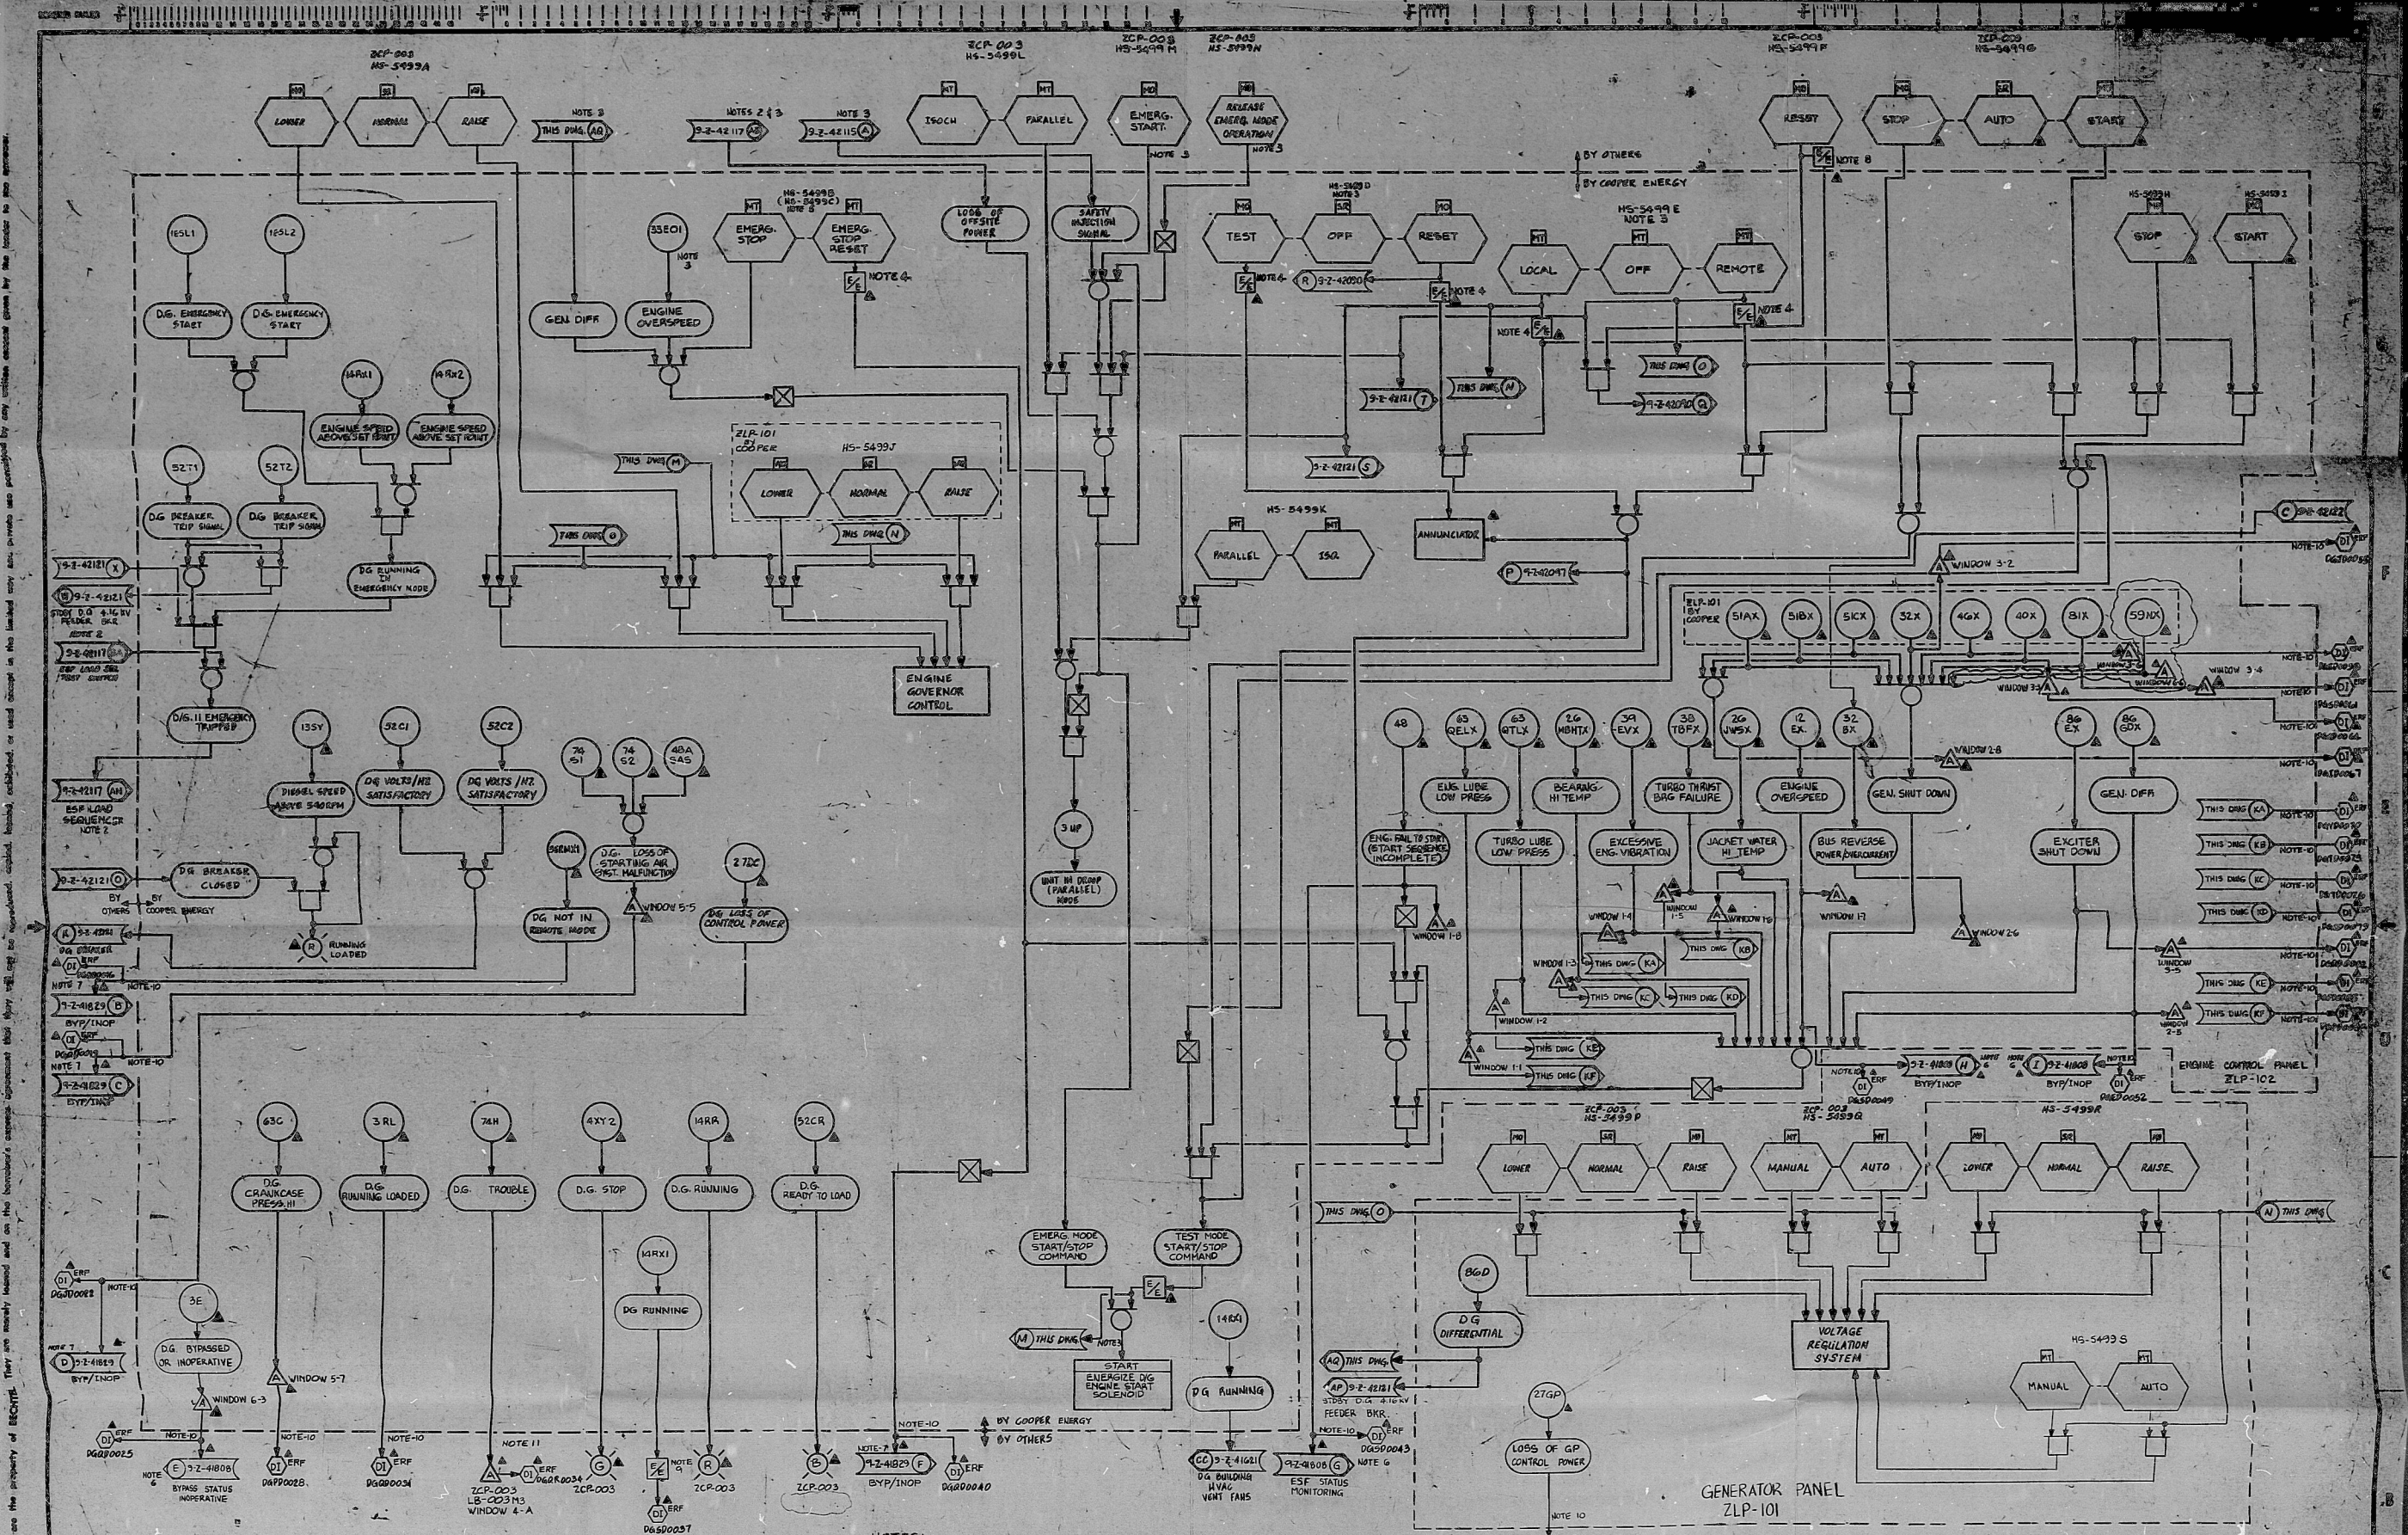

GENERAL NOTE:
THIS DRAWING REPRESENTS FUNCTIONAL REQUIREMENTS ONLY.

NOTES:
1. VIA CAB. #ZLP-699
11. VIA CAB. #ZLP-691

NOTES:
1. THIS LOGIC IS APPLICABLE TO THE FOLLOWING
2. SEE DWG. 9-Z-4211B FOR TRAIN B AND 9-Z-4211C FOR TRAIN C.
3. THIS SIGNAL MUST BE DUPLICATED BECAUSE EMERGENCY MODE IS A DUAL CIRCUIT AND THIS LOGIC REPRESENTS A SINGLE CIRCUIT.
4. THIS ISOLATION IS A PHYSICAL BARRIER ON THE CONTROL SWITCH.
5. HE-5491C FOR REDUNDANT ENGINE START SOLENOID CIRCUIT
6. SEE DWG. 9-Z-4185C FOR TRAIN B AND 9-Z-4187C FOR TRAIN C.
7. SEE DWG. 9-Z-4185D FOR TRAIN B AND 9-Z-4186C FOR TRAIN C.
8. ISOLATION THROUGH RELAY
9. TRAINS A, B, & C ISOLATION DEVICES LOCATED ON ZLP-053, 600, & 601 RESPECTIVELY.

SERVICE NO.	COMPUTER POINTS
DG 11	D600016 D600019 D600022 D604999

PDR RID^s

8701160381

