


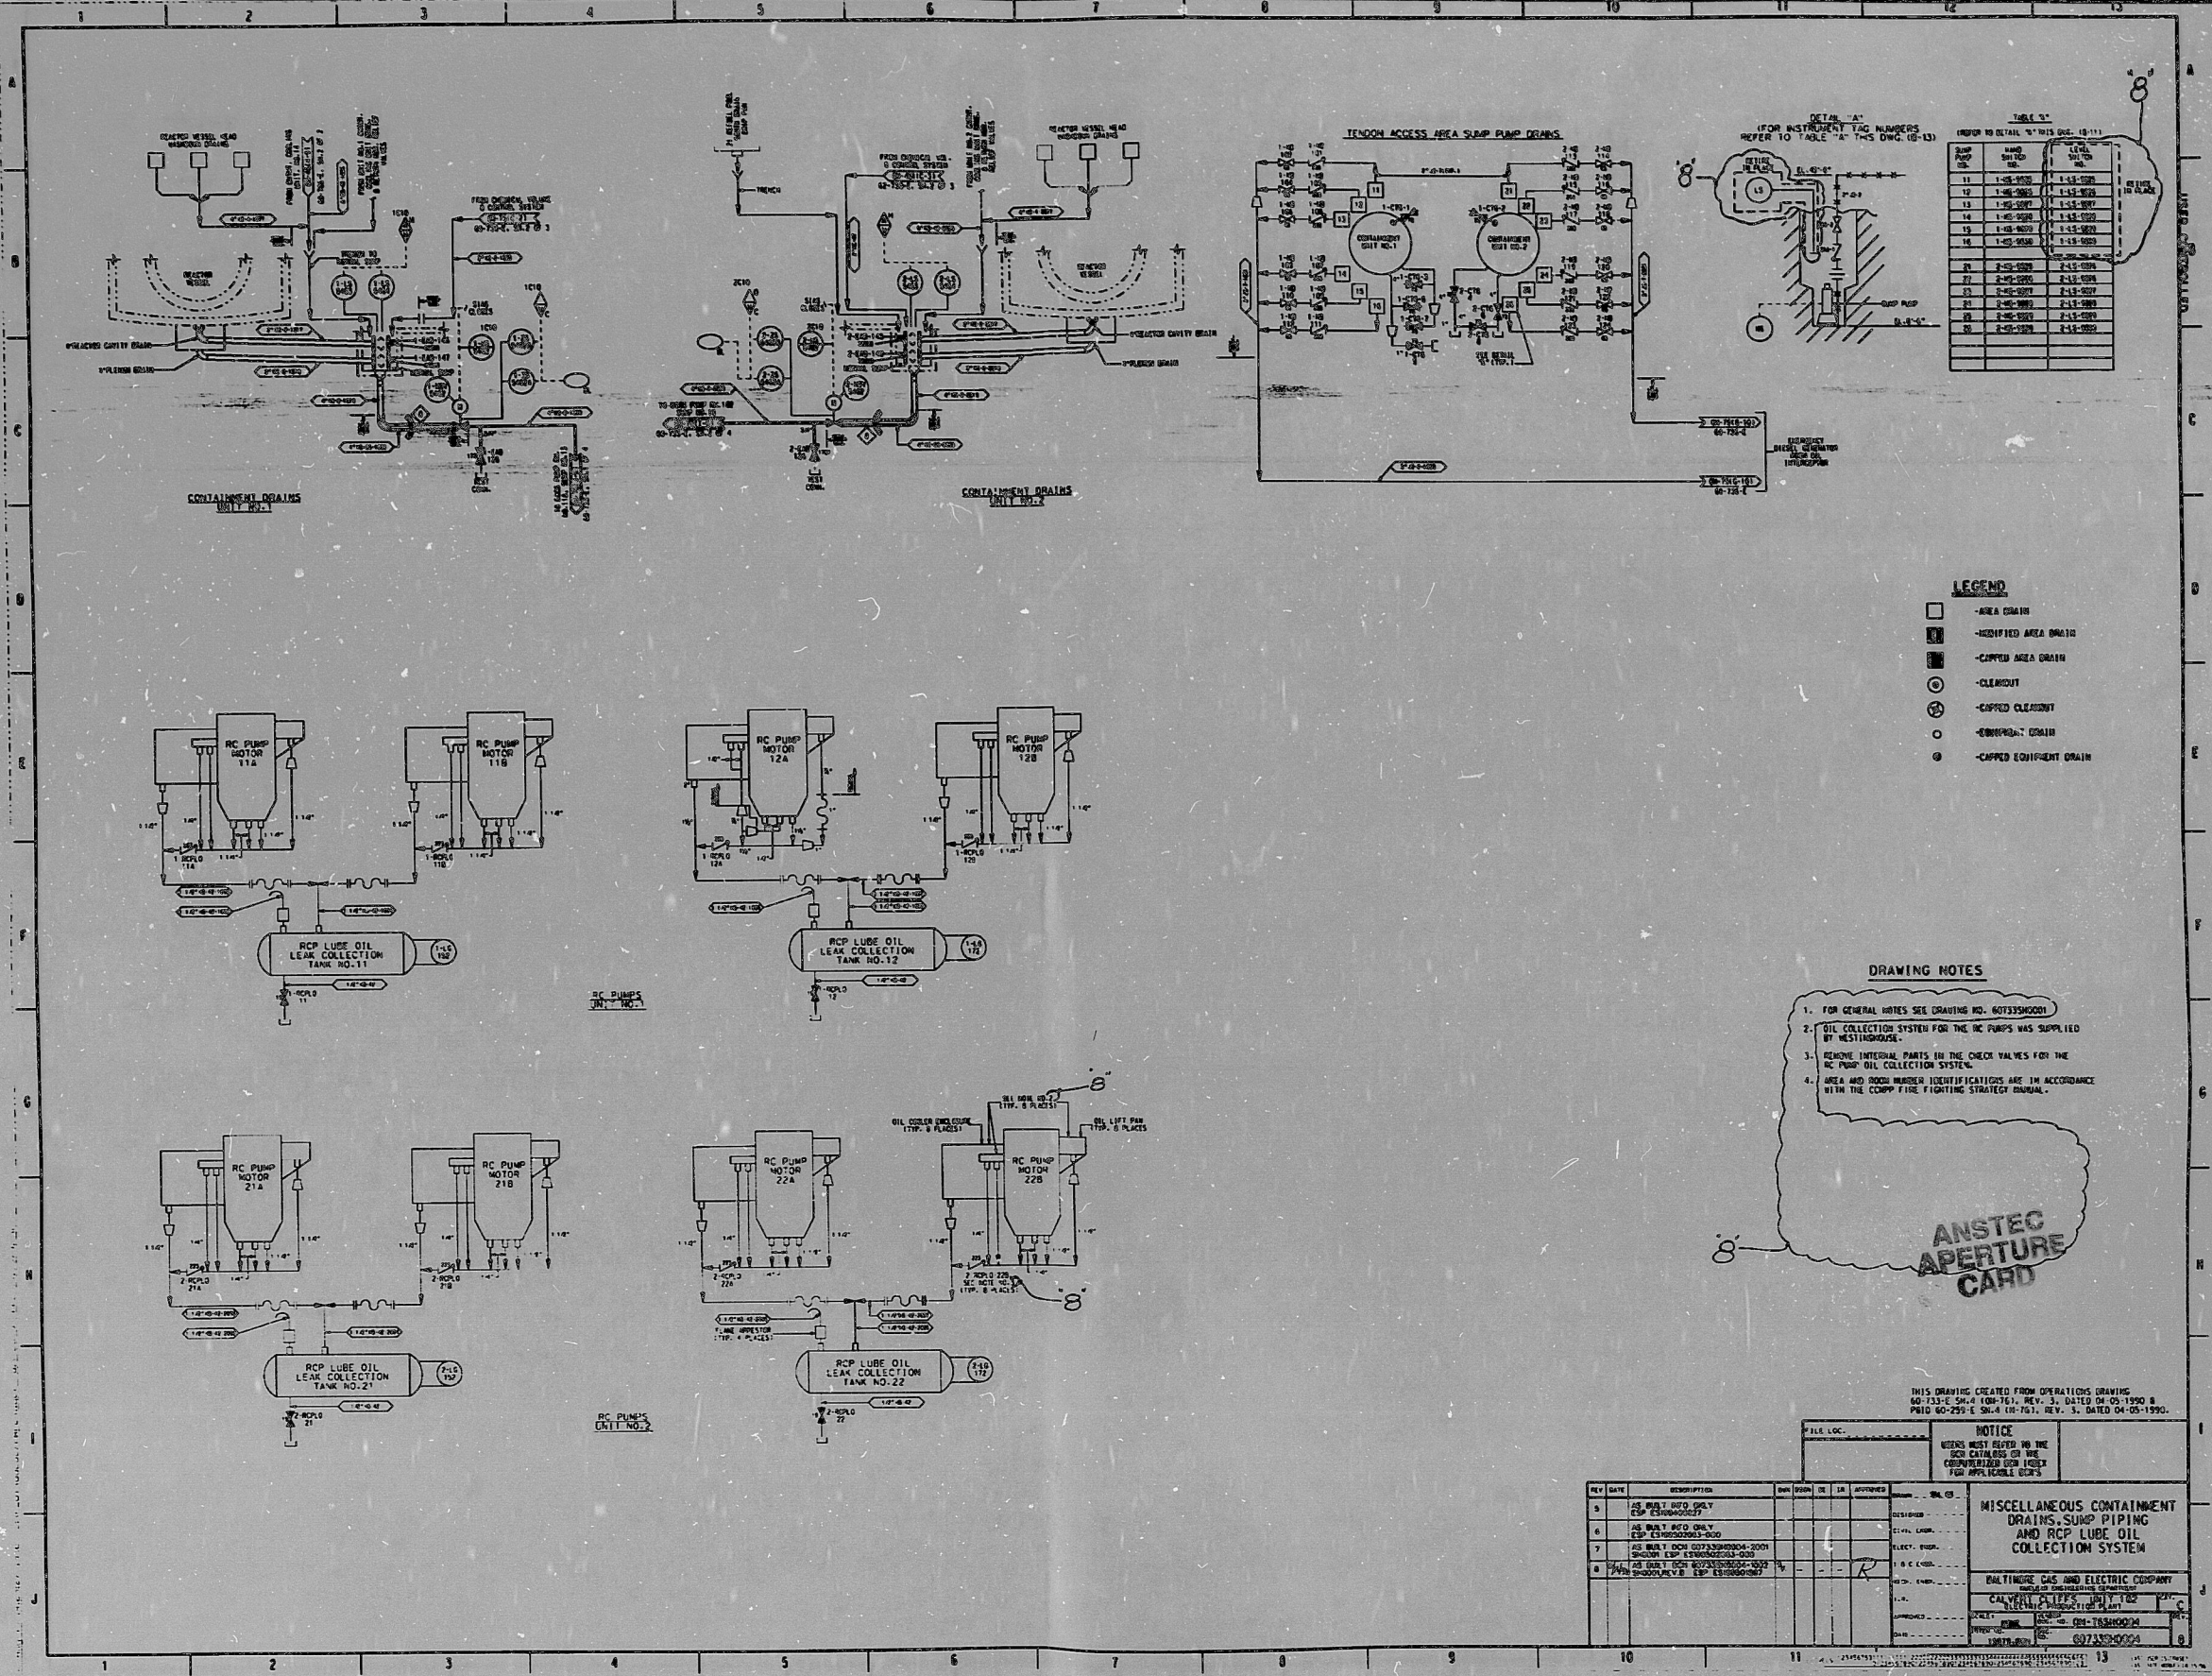

9705140267

PDR RIDS

9705140267

