


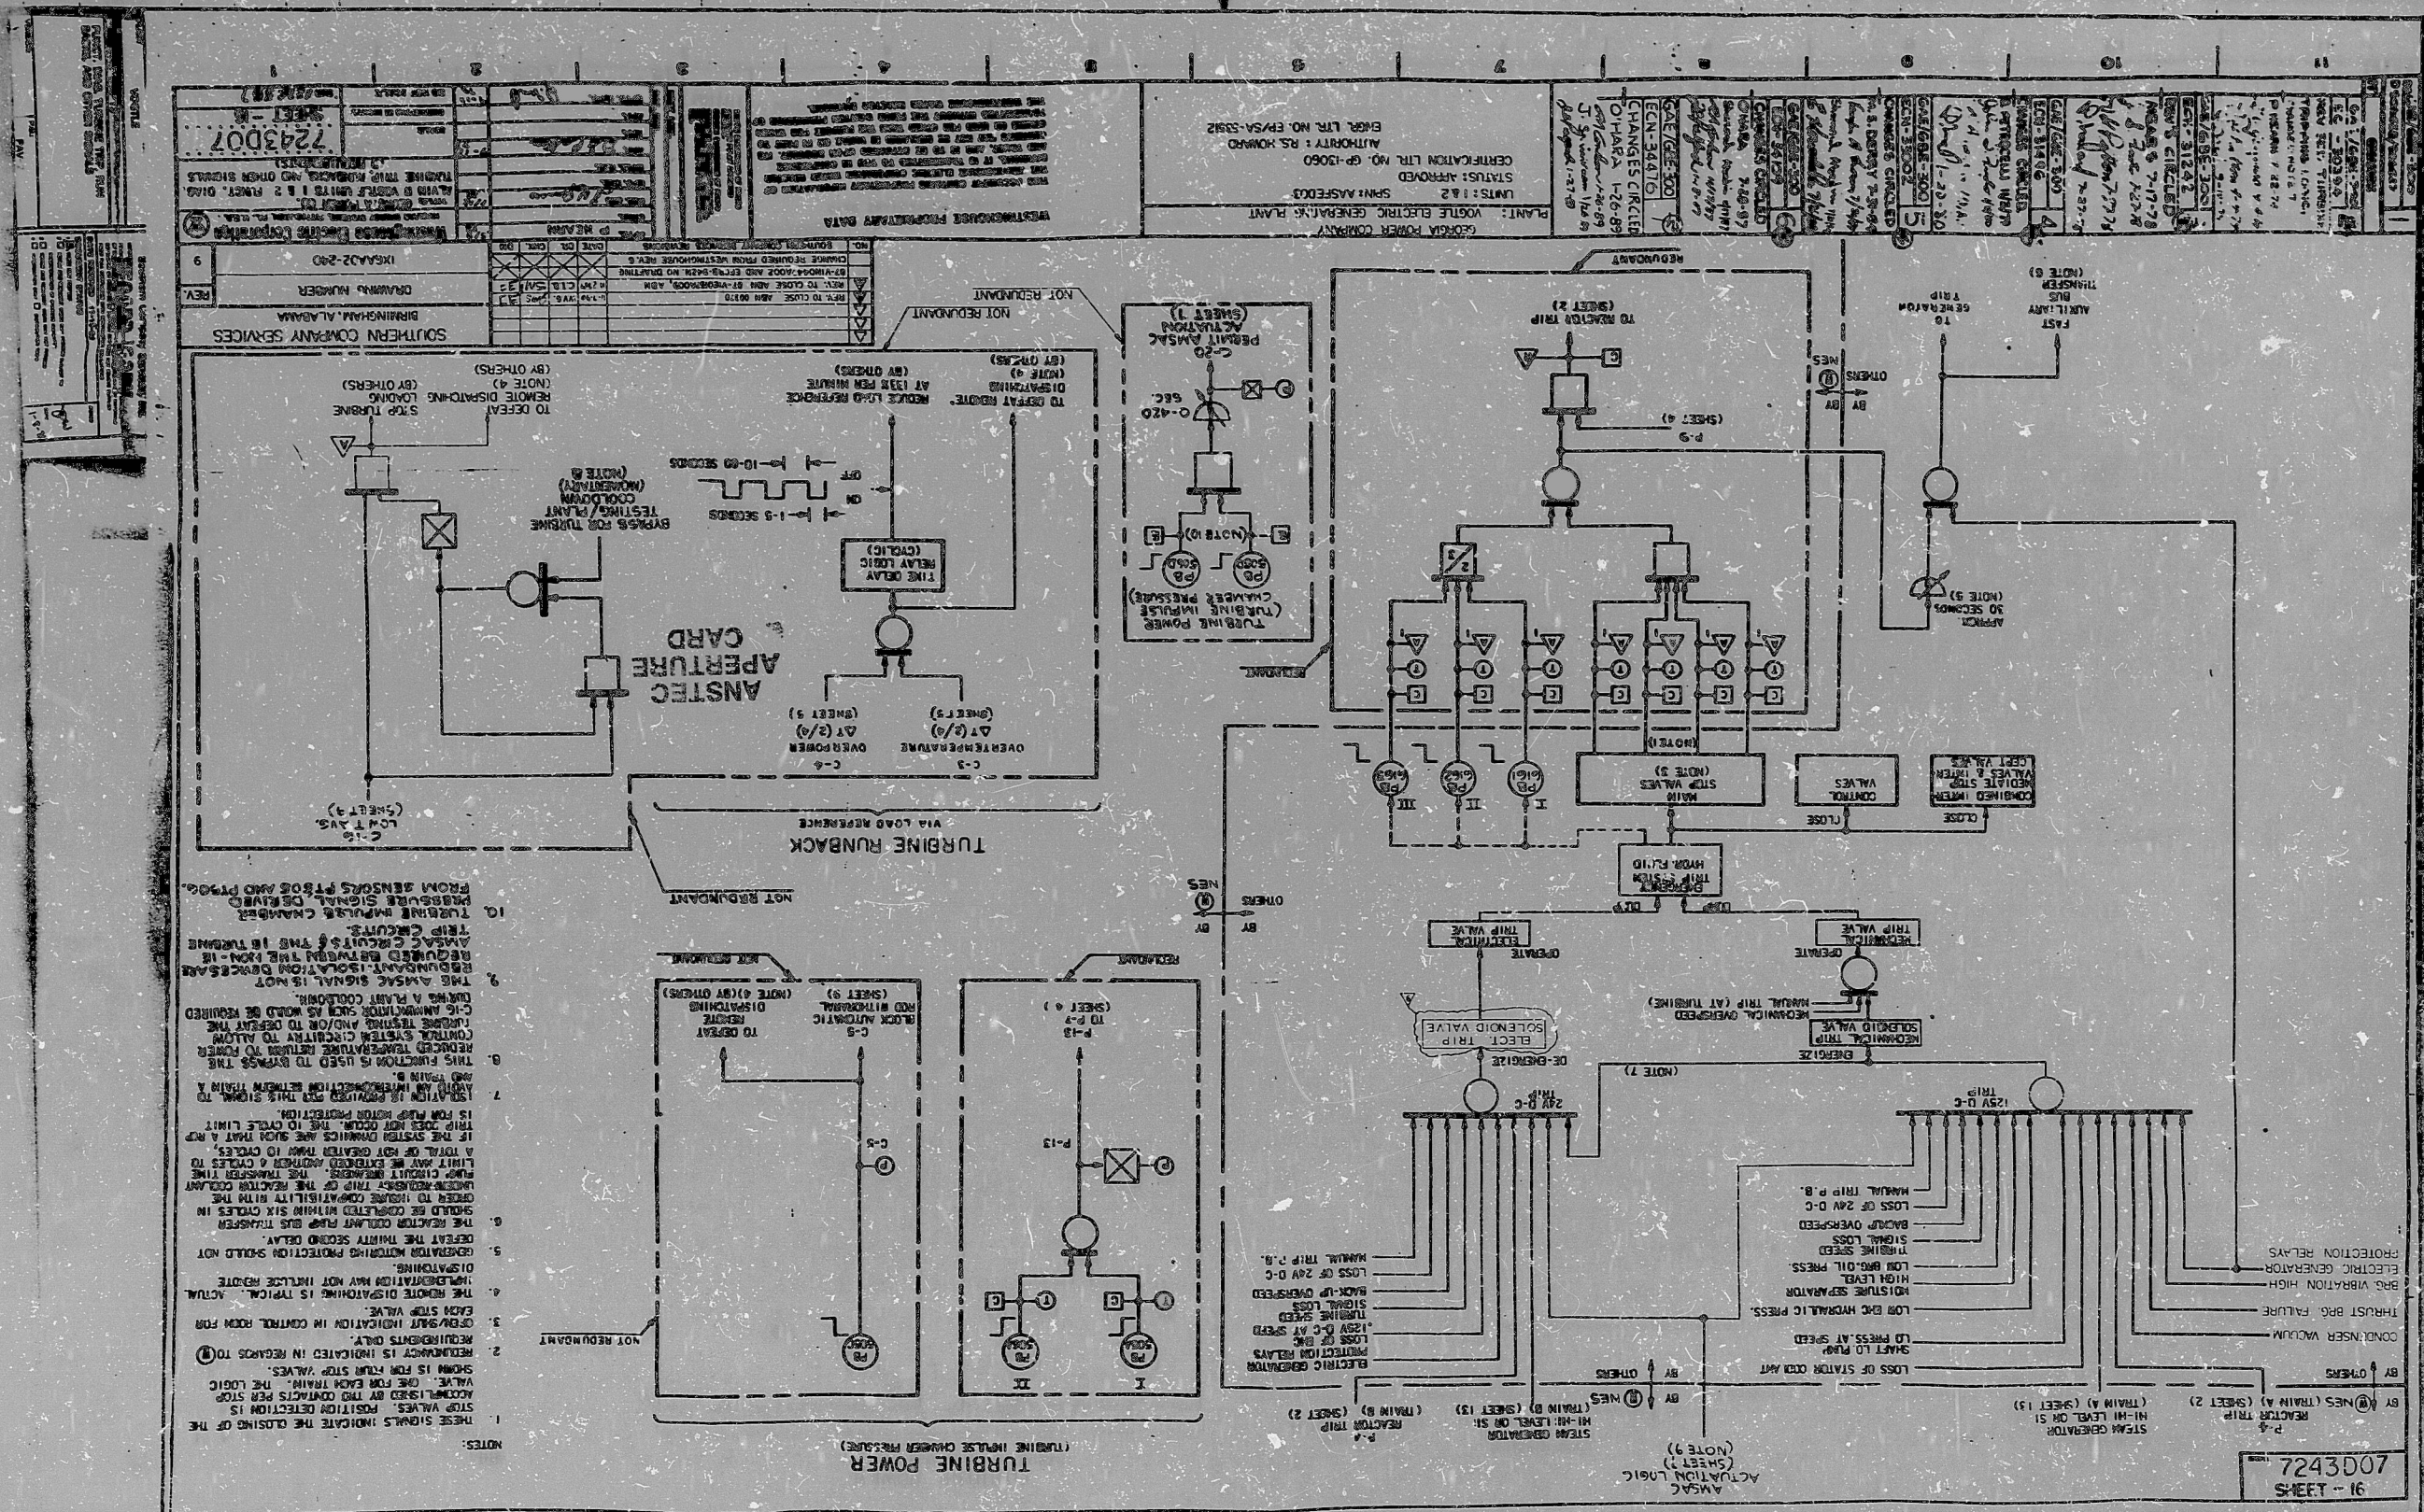



PDR RIDS

9512220297

