


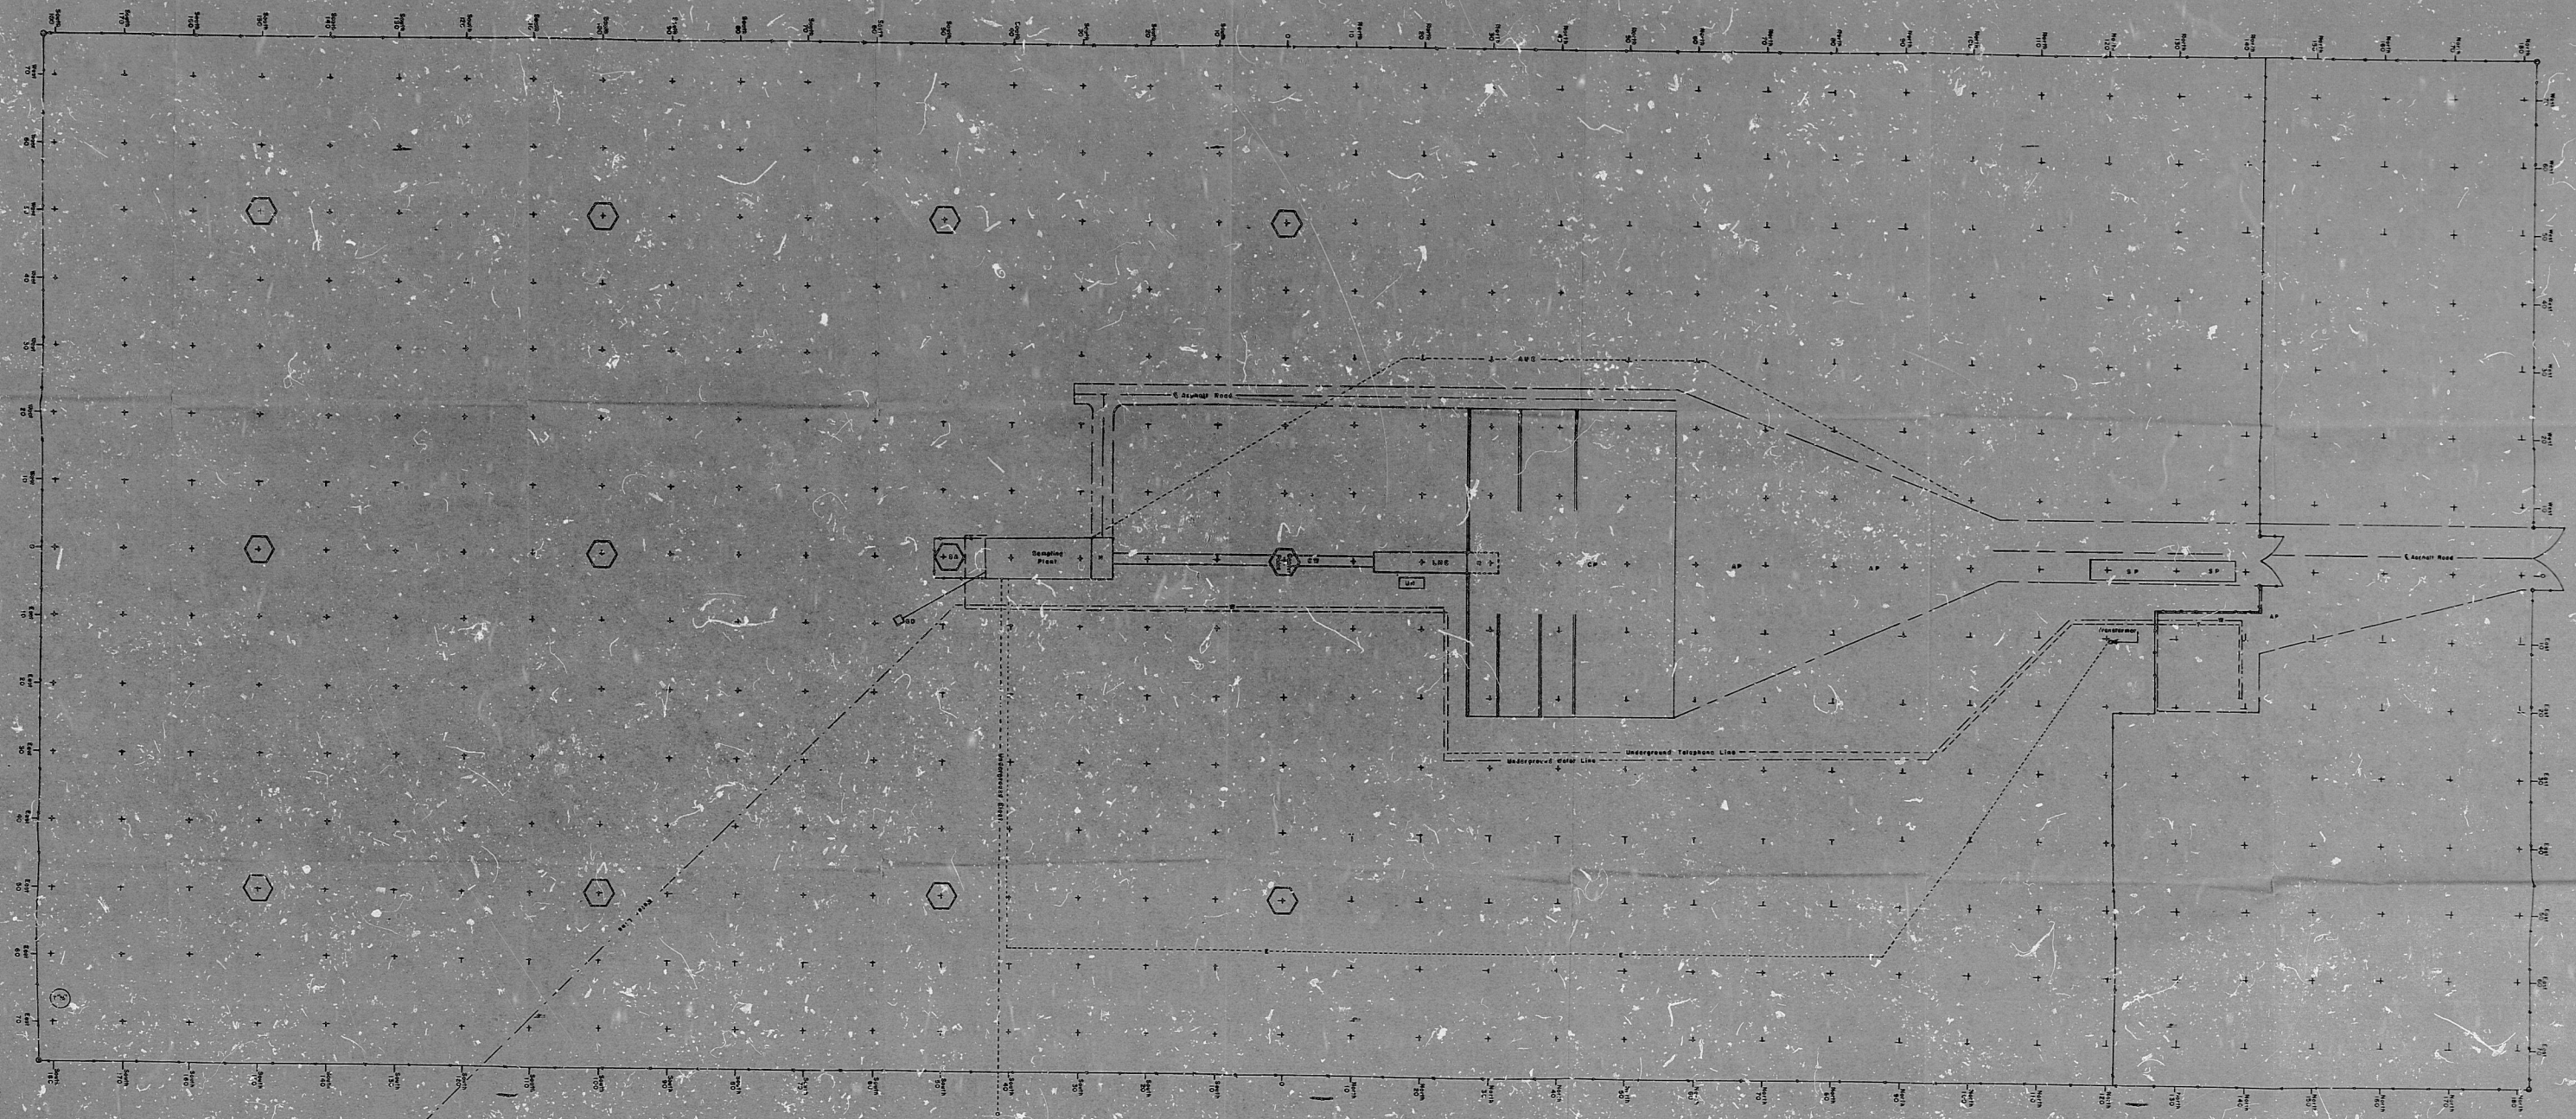

22
APERTURE
CARD

SYMBOL	CODE	NOTES
⬡	Surface Soil Sample	The location of the building, power lines and other facilities on this map are approximate. Date of plotting is from the map "Union Pacific Survey, Western Utah, Rio Piedra, August 28, 1977".
		Elect. power to H-Val air sampler not shown.
		Force is 1' chain link.
		Survey Date: May 15, 1980.
		Tool: S.C. Hammer

8512200259
Map No 6

PLATEAU RESOURCES LIMITED		Priority	Date
BLANKING ORE			
BUYING STATION			
RESTRICTED AREA			
10X10 METER GRID			
Final Surface Soil Sampling Locations			
Scale: 1" = 250'	Checked by: [Signature]	Drawn by: [Signature]	Plotting Date: 10/29/84
Drawn by: [Signature]	Checked by: [Signature]	Drawn by: [Signature]	Plotting Date: 10/29/84
		OBS-ID	

PDR

8512200259

