


LR-1001-604B

253-122 D	253-123 D	253-123 D-1	253-123 D-1
263-121 B	263-121 D	263-123 B	263-123 D
263-123 B-1	263-123 D-1	263-123 D-1	263-123 D-1

DATE	BY	CHK	APP
10/15/77

6698	6697	6699	905
------	------	------	-----


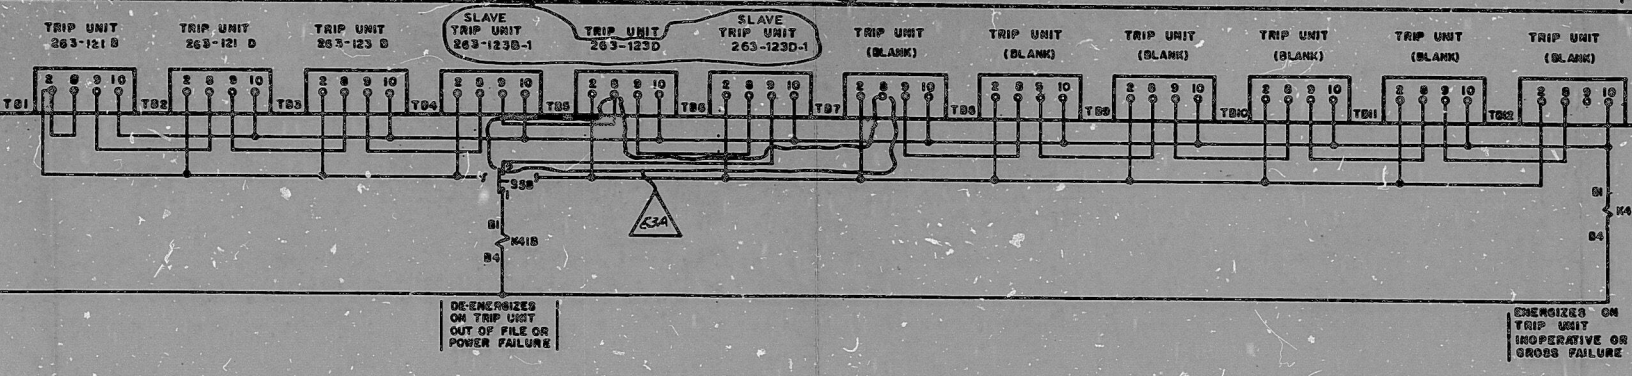

FOR INFORMATION ONLY
 8805030479

TI
 APERTURE
 CARD

 PRINTED IN U.S.A.

NO.	DATE	REVISIONS	BY	CHK	APP	NO.	DATE	REVISIONS	BY	CHK	APP	NO.	DATE	REVISIONS	BY	CHK	APP	NO.	DATE	REVISIONS	BY	CHK	APP	

UNIT NO. 1
 BOSTON EDISON COMPANY
 ELEMENTARY DIAGRAM
 ATWS SYSTEM SH 7
 MIY7
 E3

ACCEPTED HMG
 4/15/77

PDR CARDS

8805030479

