

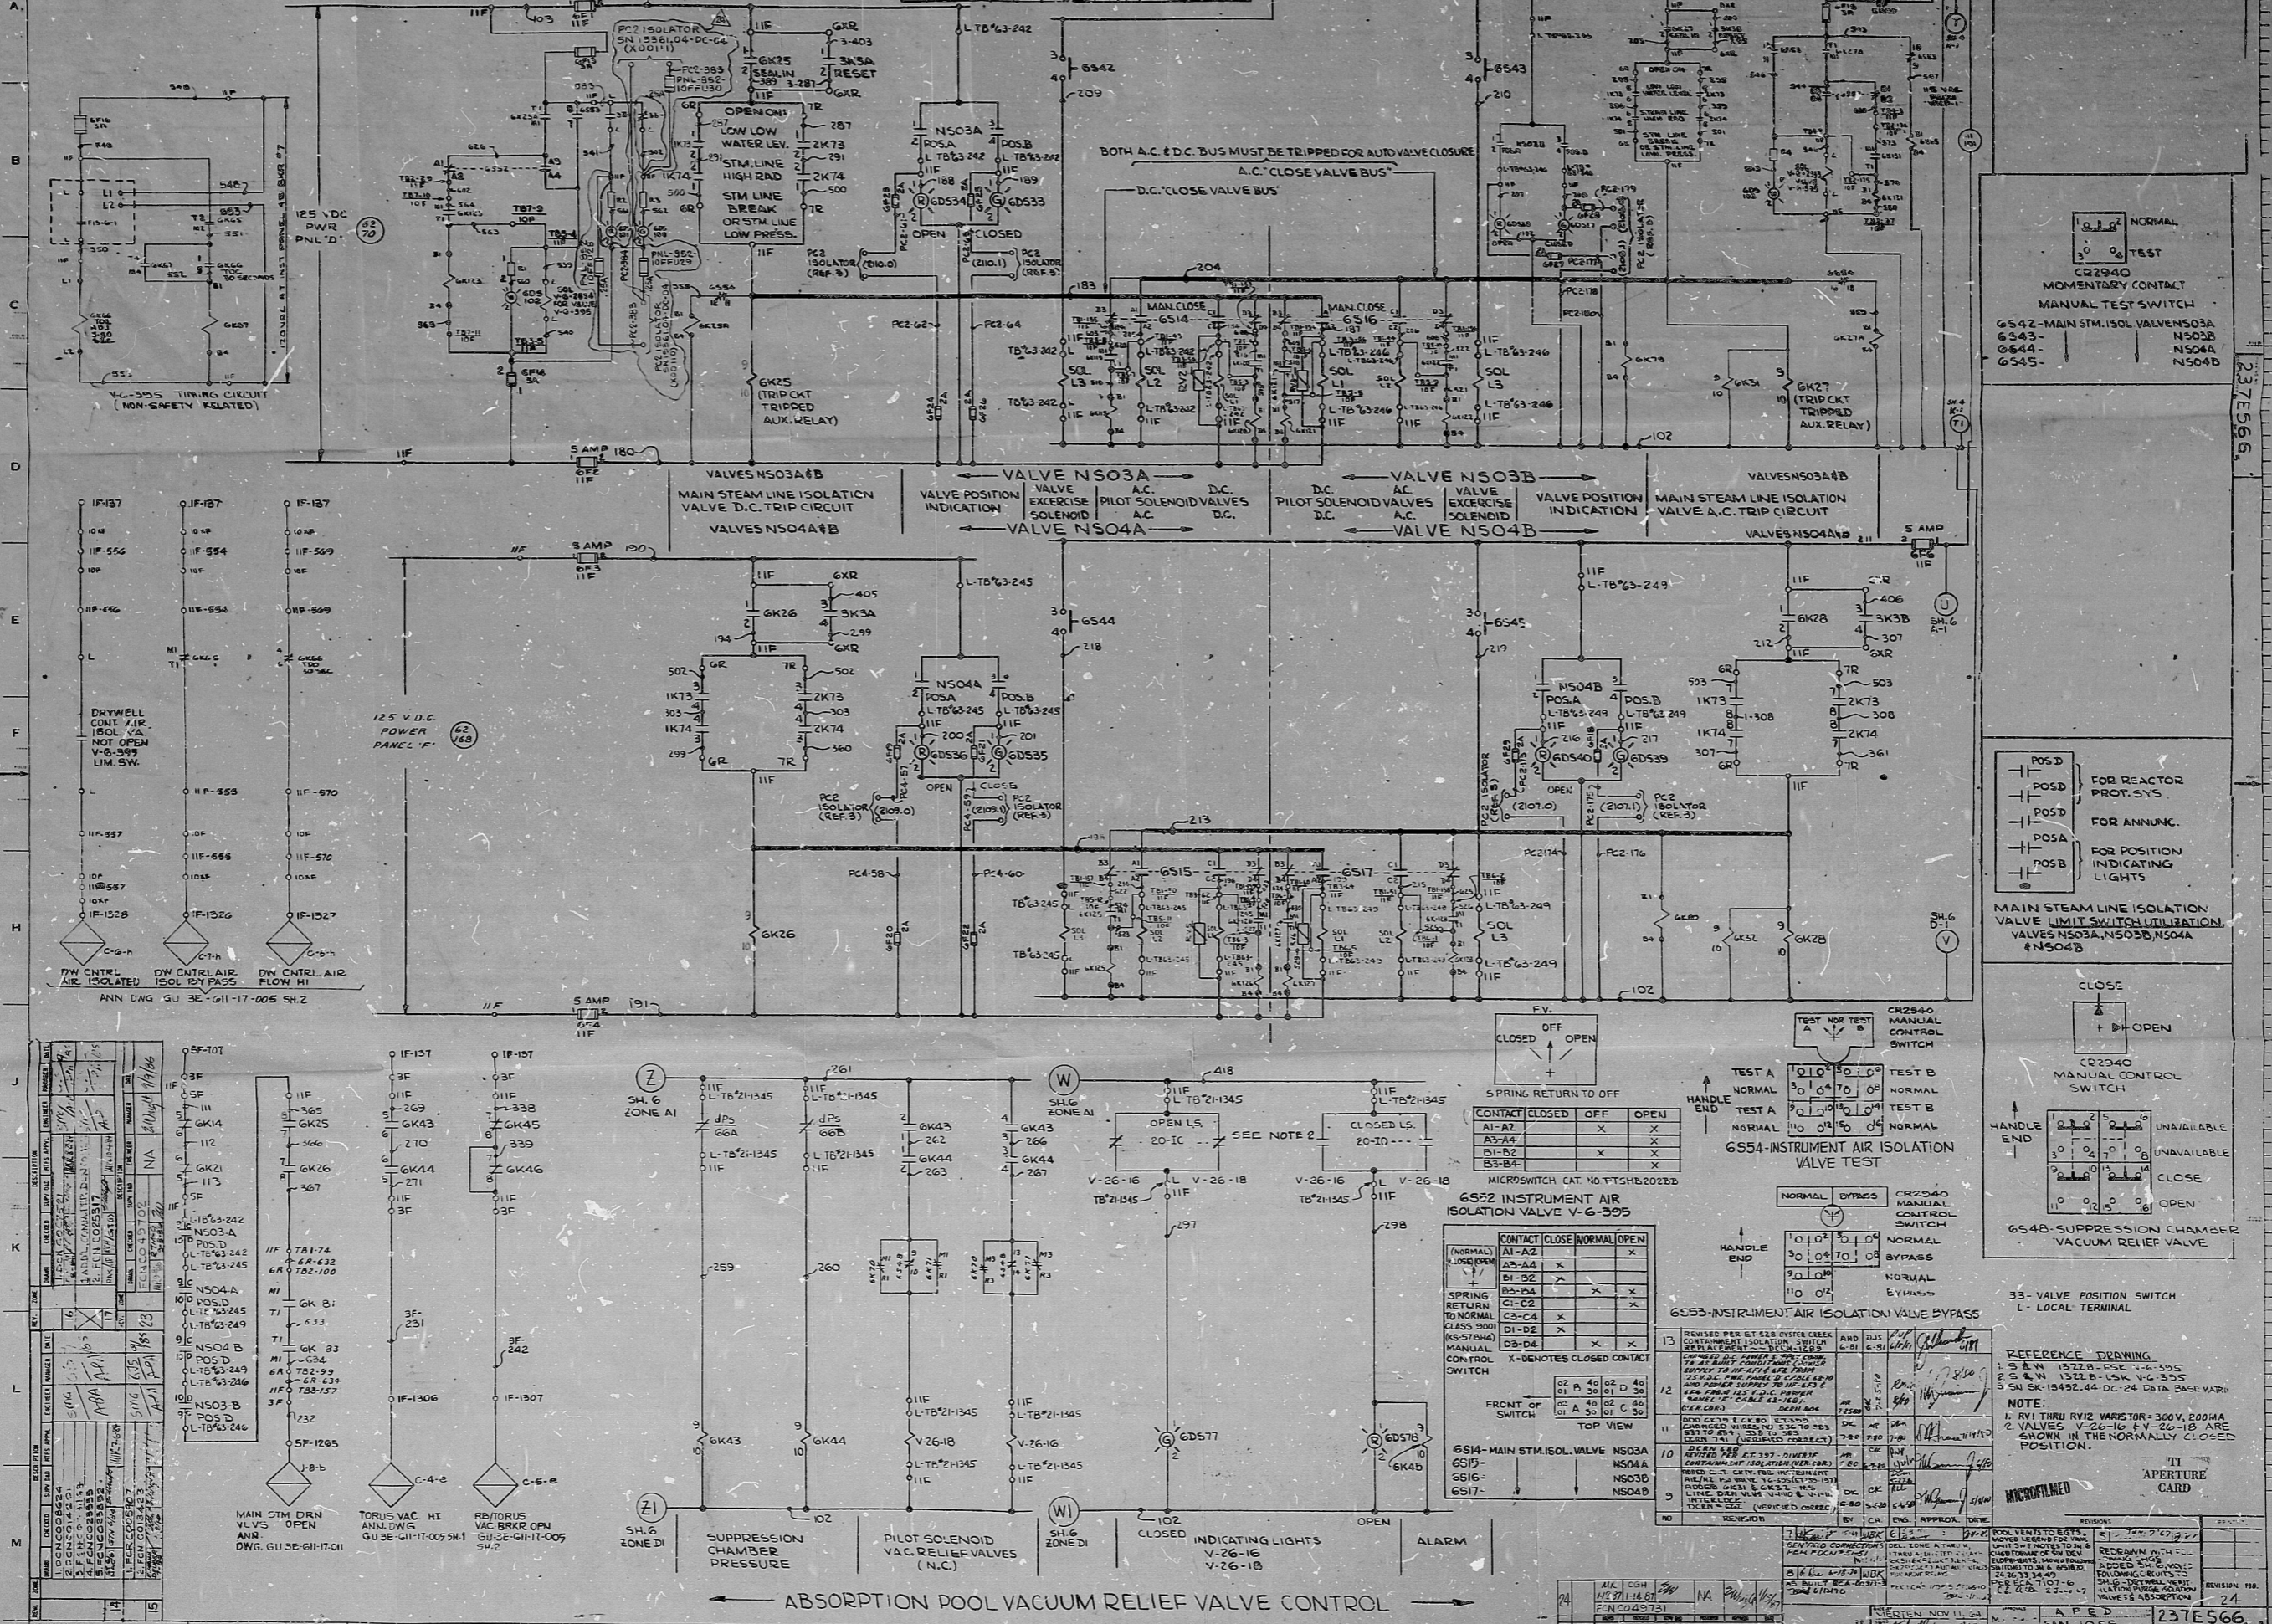
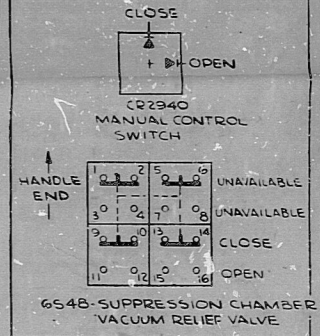


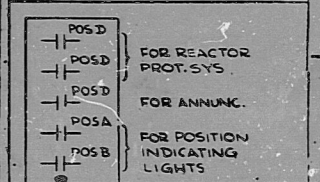

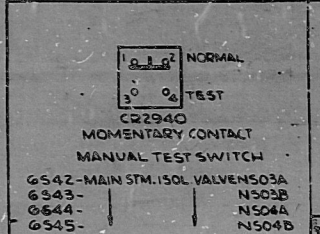

REFERENCE DRAWING  
 1. S & W 1312B-ESE 1-6-39E  
 2. S & W 1312B-LSK 1-6-39E  
 3. S & W 13492.44 DC-24 DATA BAGG MATH

NOTE:  
 1. RV1 THRU RV12 VARISTOR 300V, 200MA  
 2. VALVES V-26-16 & V-26-18 ARE SHOWN IN THE NORMALLY CLOSED POSITION.

TI APERTURE GARD

REVISION NO. 24

DATE 11/23/66



PDR RIDS

8805060141

