


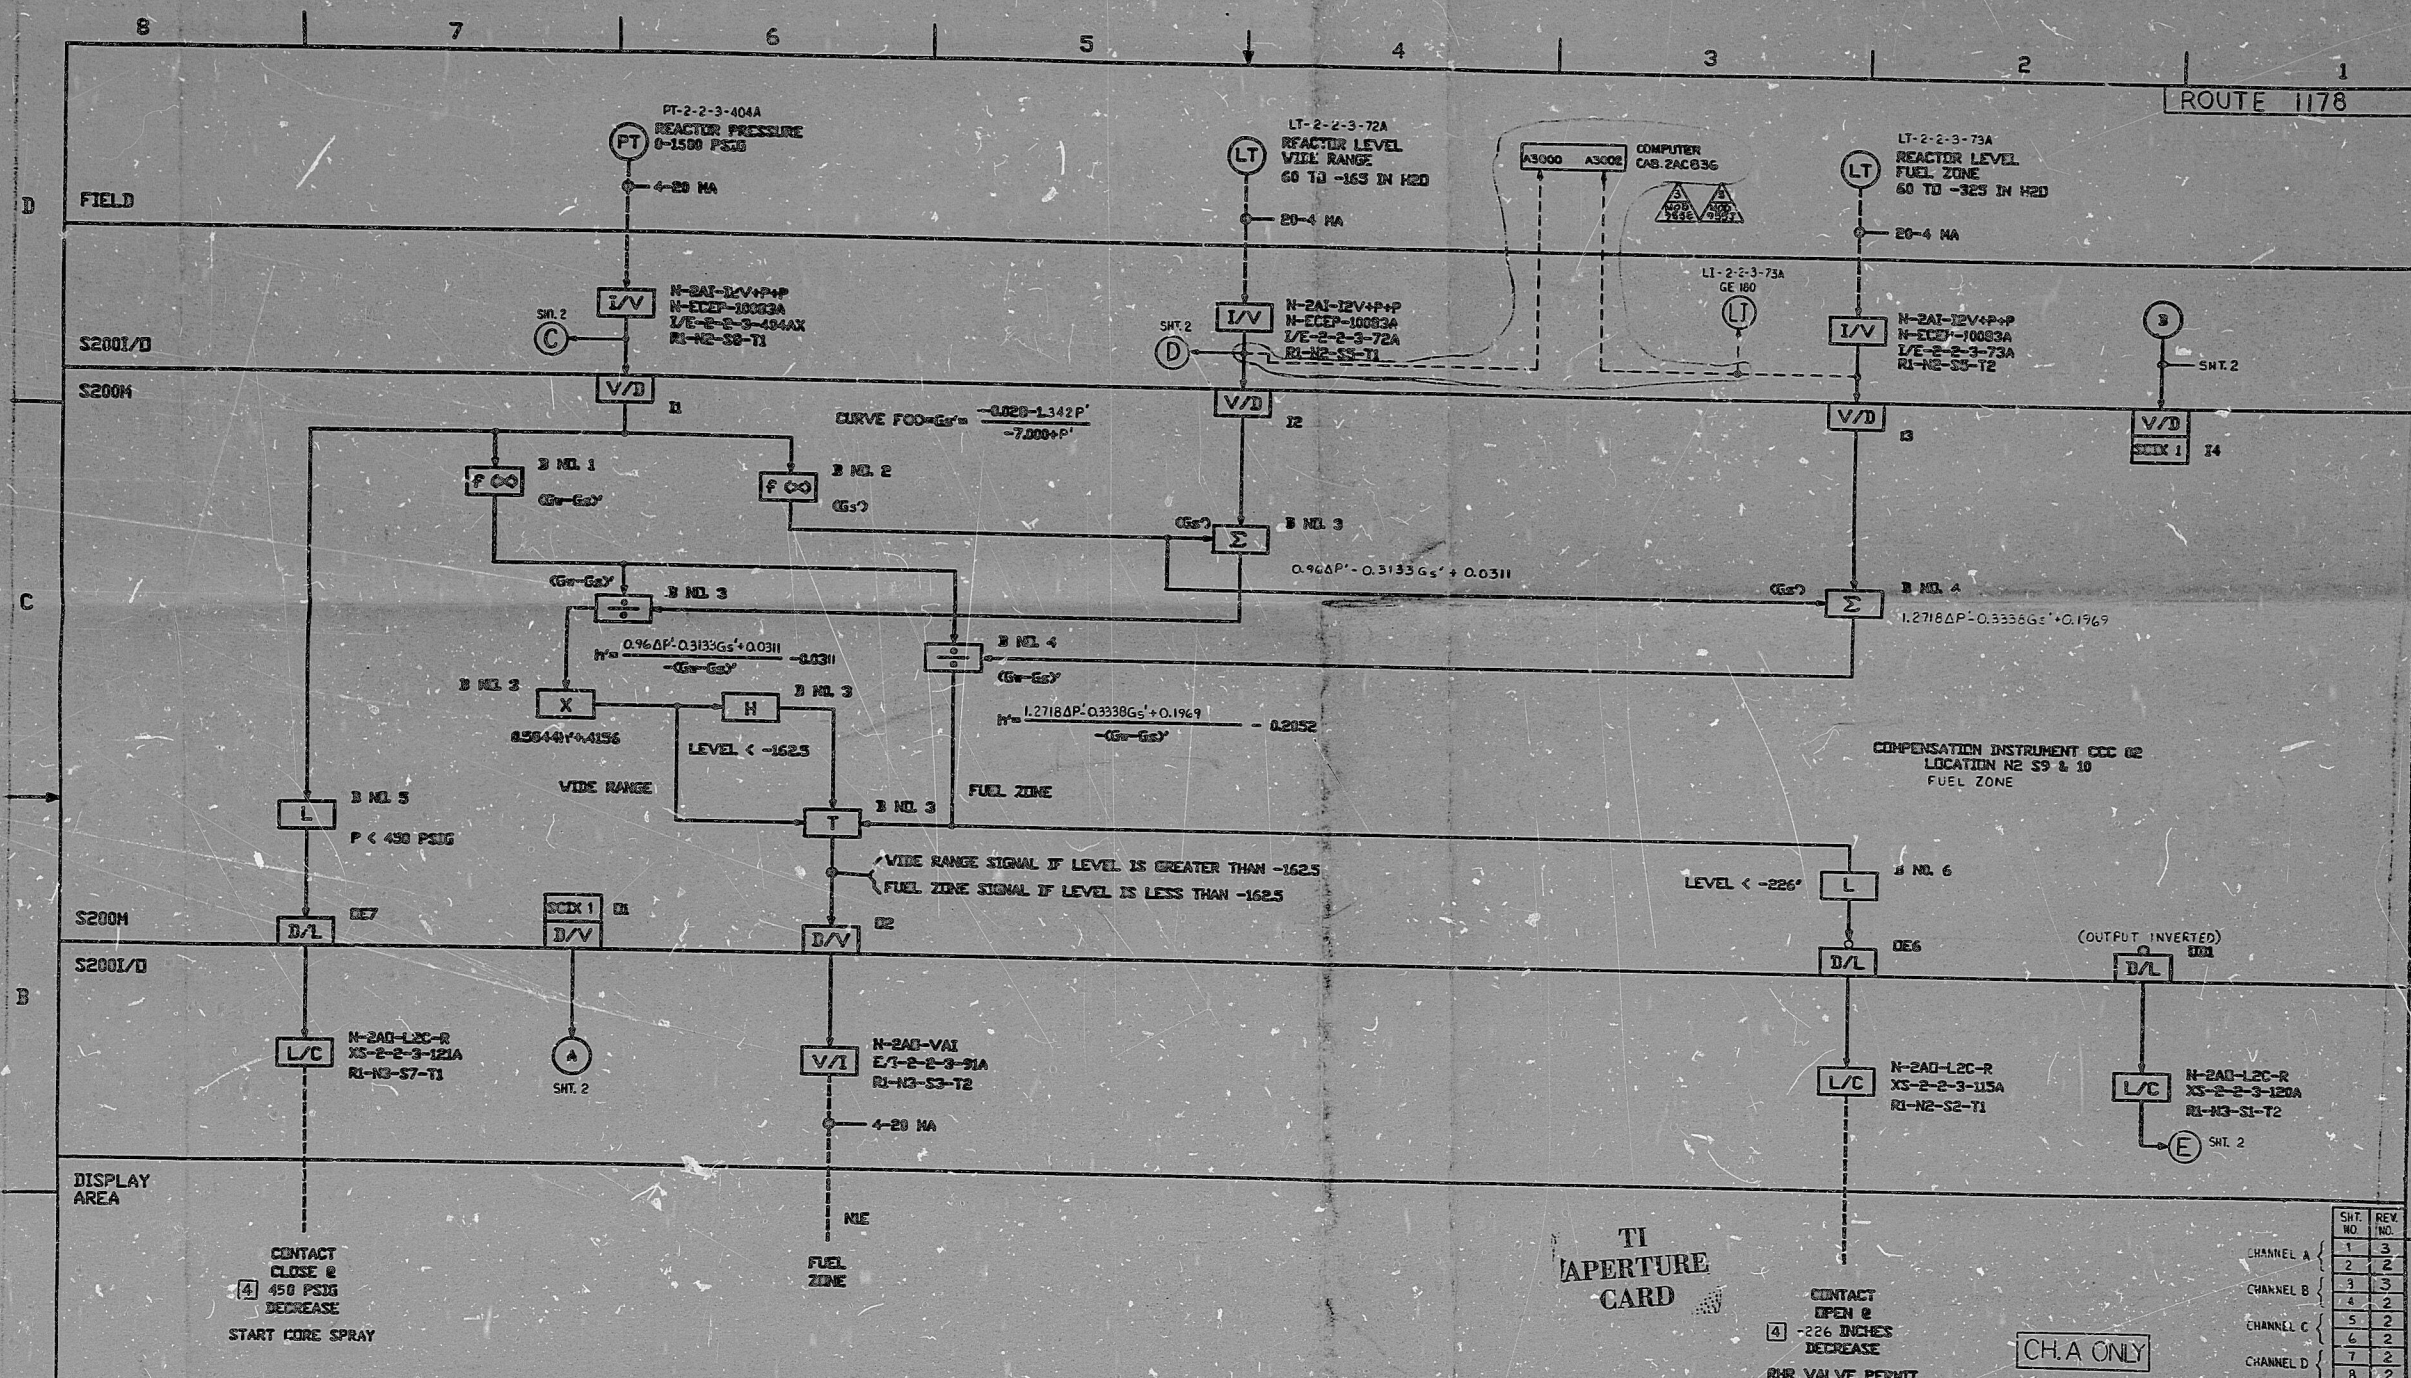

NO		DATE	DESCRIPTION	BY	CHK	APPD
1	8/1	8/1	W.D. 40952B-B133 MOD. 457 REACTOR SHEETS 3-8 FOR CHANNELS E.C.T.D. RESPECTIVELY. CHANGED THIS SK TO CH A ONLY. REVISED SK 2 NOTE: THIS REV. SUPERSEDES 6280- M-1-EE-461-3			

8605060315

PDR RIDS

