


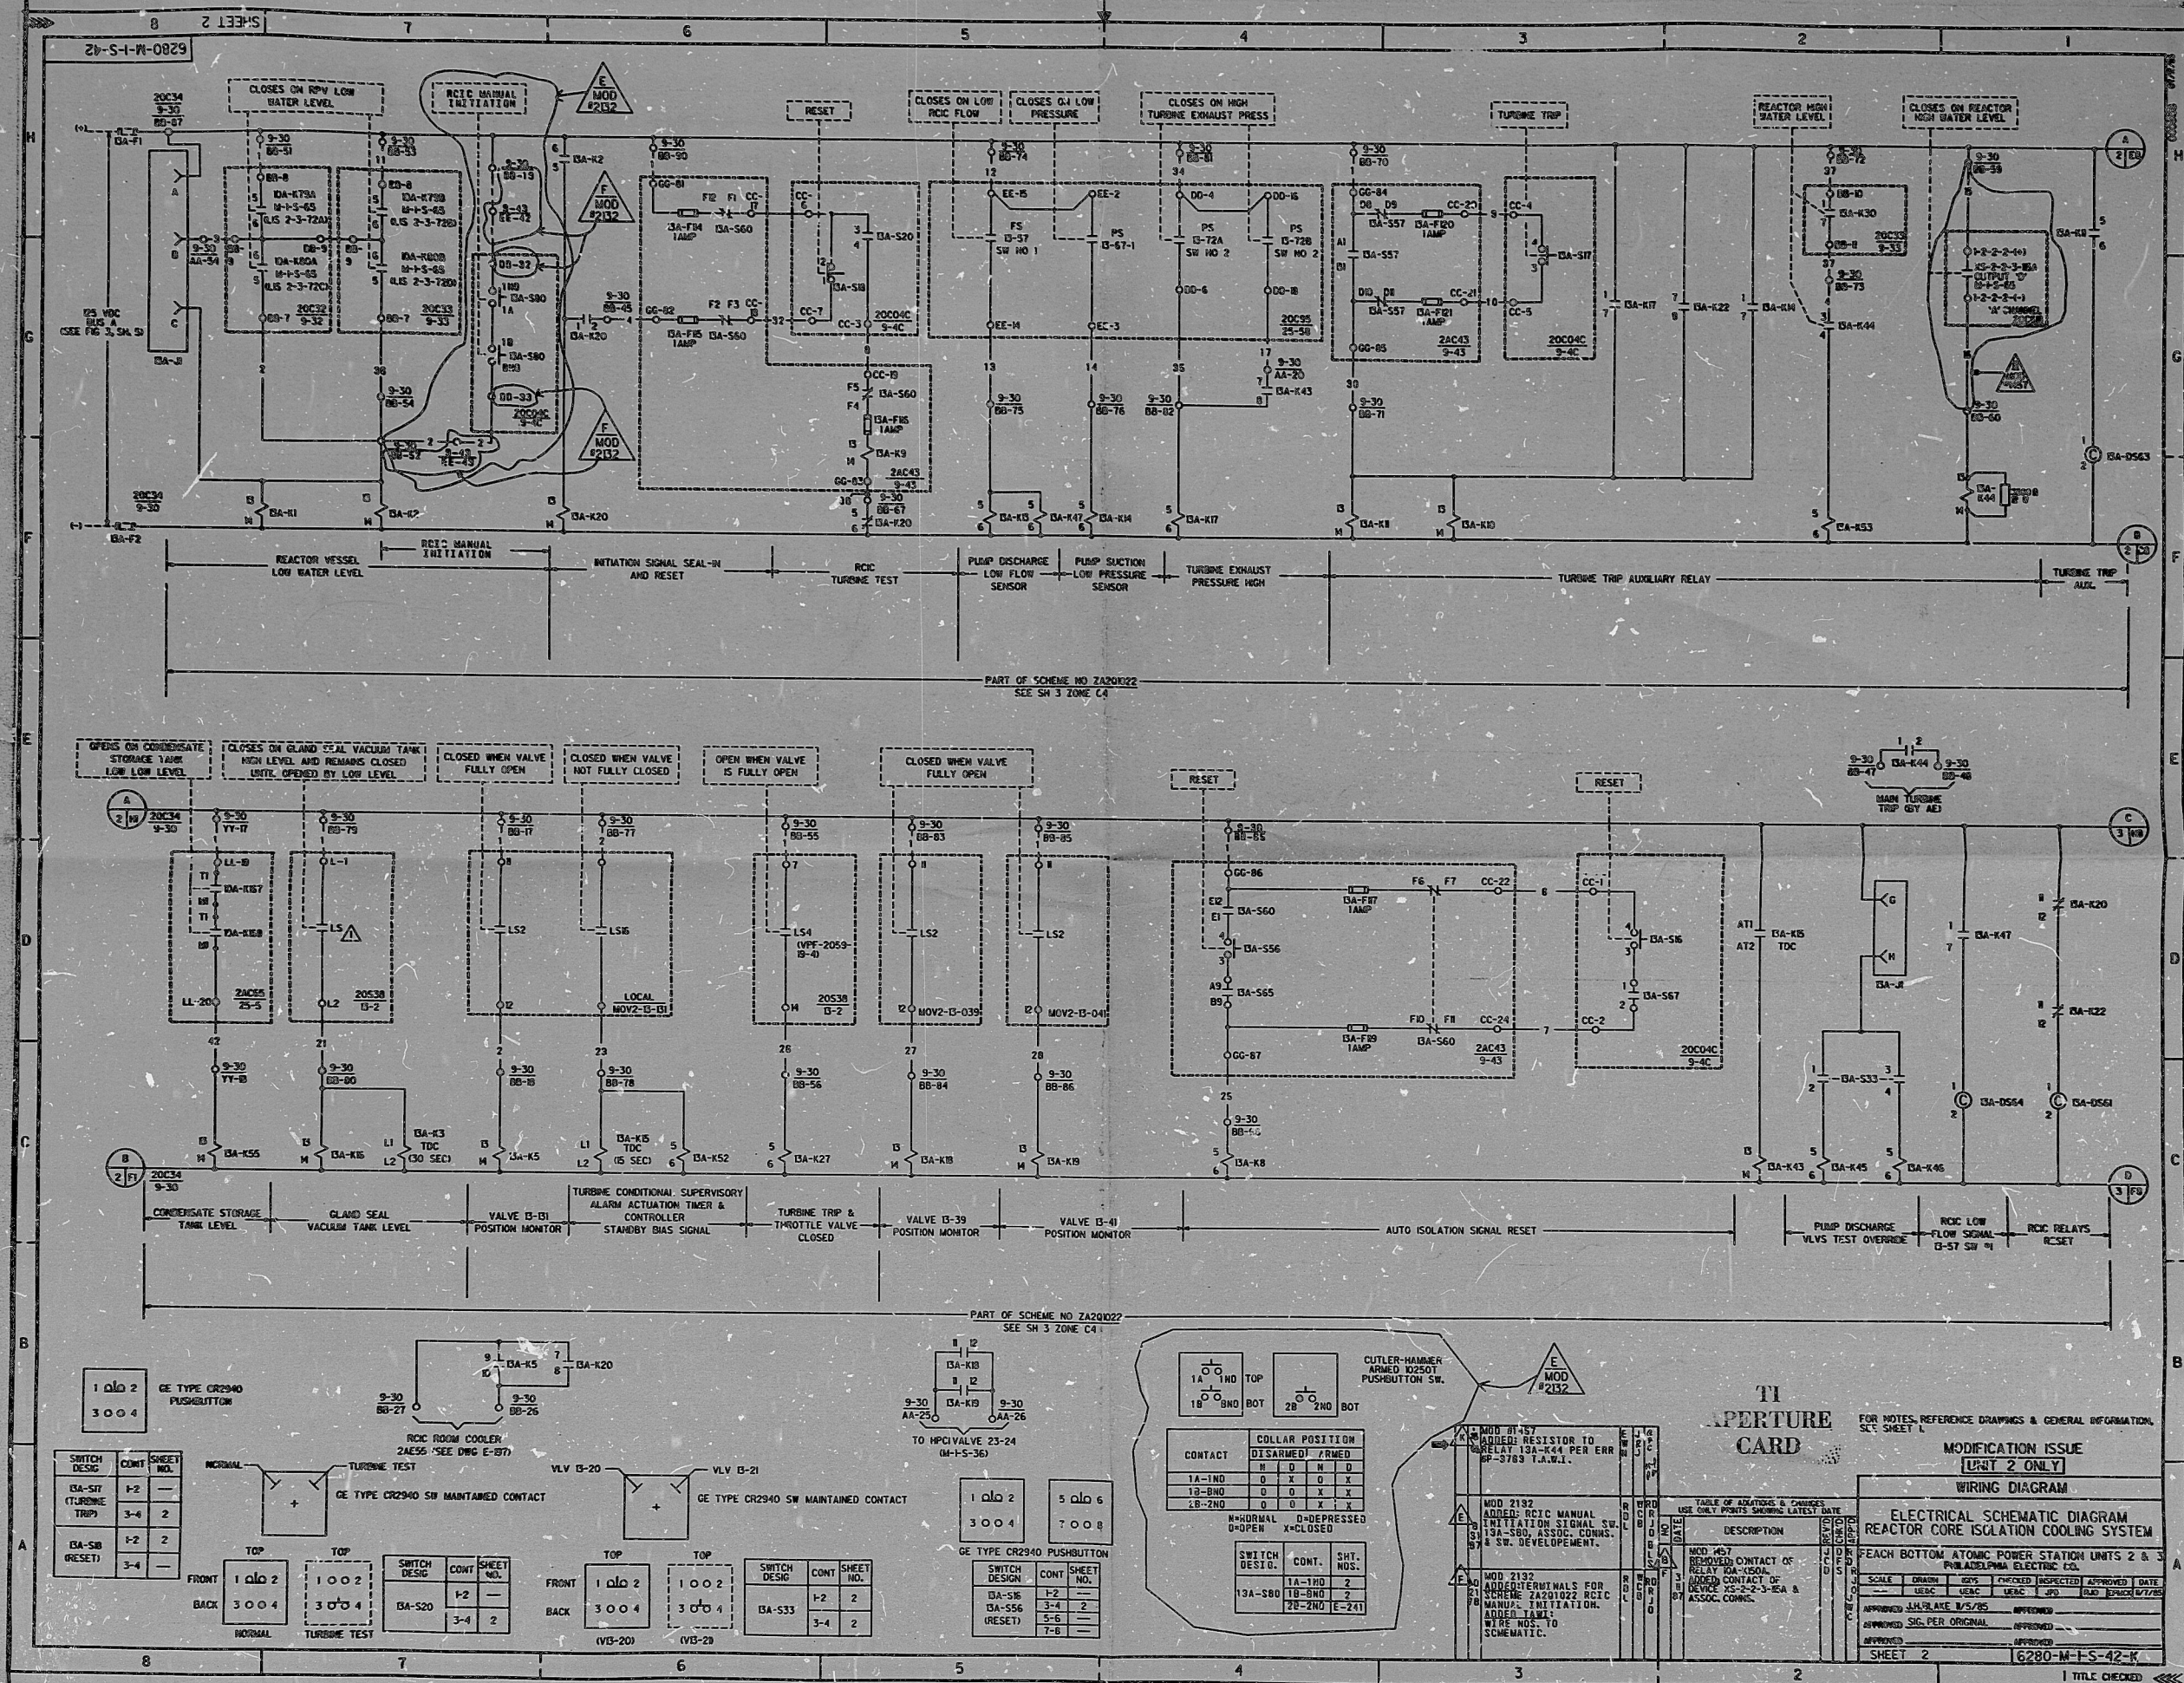

8805090143

PDR RIDS

