


CRITICAL DRAWING  
M-116  
SHEET 3

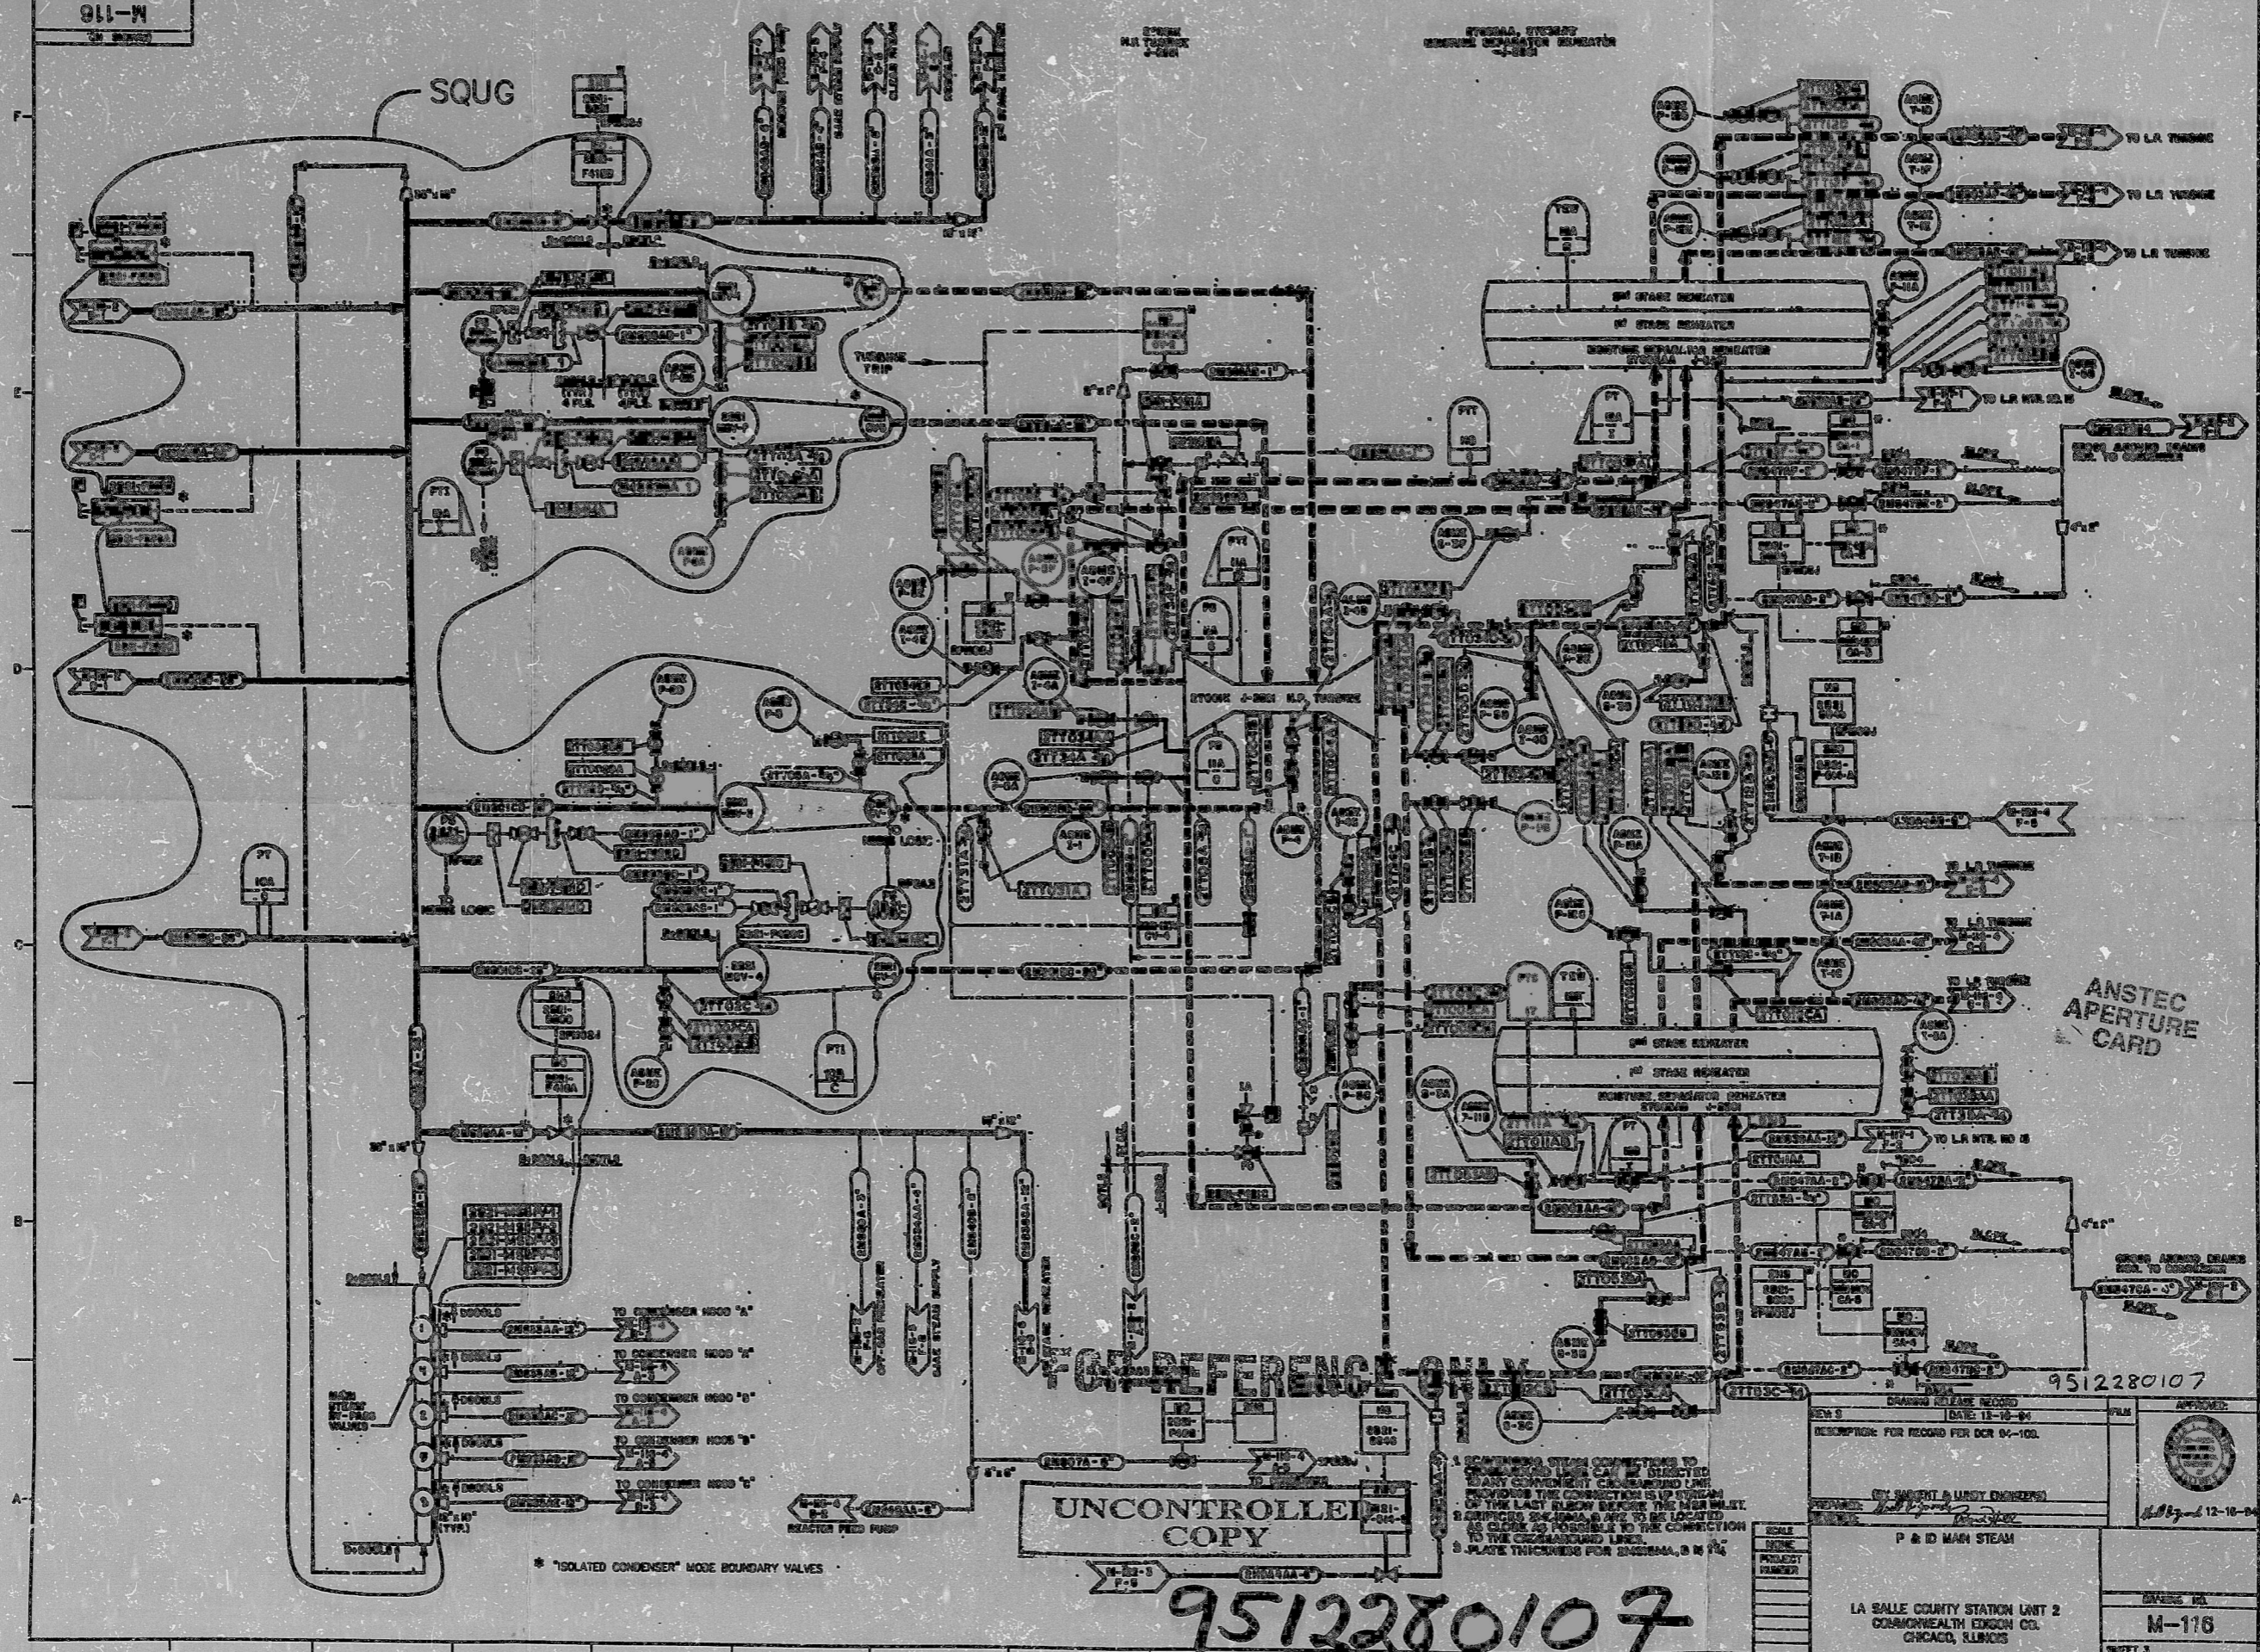

FOR REFERENCE ONLY

UNCONTROLLED COPY

9512280107

\* "ISOLATED CONDENSER" MODE BOUNDARY VALVES


DRAWING RELEASE RECORD		9512280107
REV'S	DATE 12-10-84	FILM
DESCRIPTION: FOR RECORD PER DCR 04-100.		
BY SAFFERT & LINDY ENGINEERS		
P & ID MAN STEAM		
LA SALLE COUNTY STATION UNIT 2 COMMONWEALTH EDISON CO. CHICAGO, ILLINOIS		
SHEET 3		M-116

ANSTEC APERTURE CARD

CRITICAL DRAWING

PDR RIDS

9512280107

