


CRITICAL DRAWING

M-55

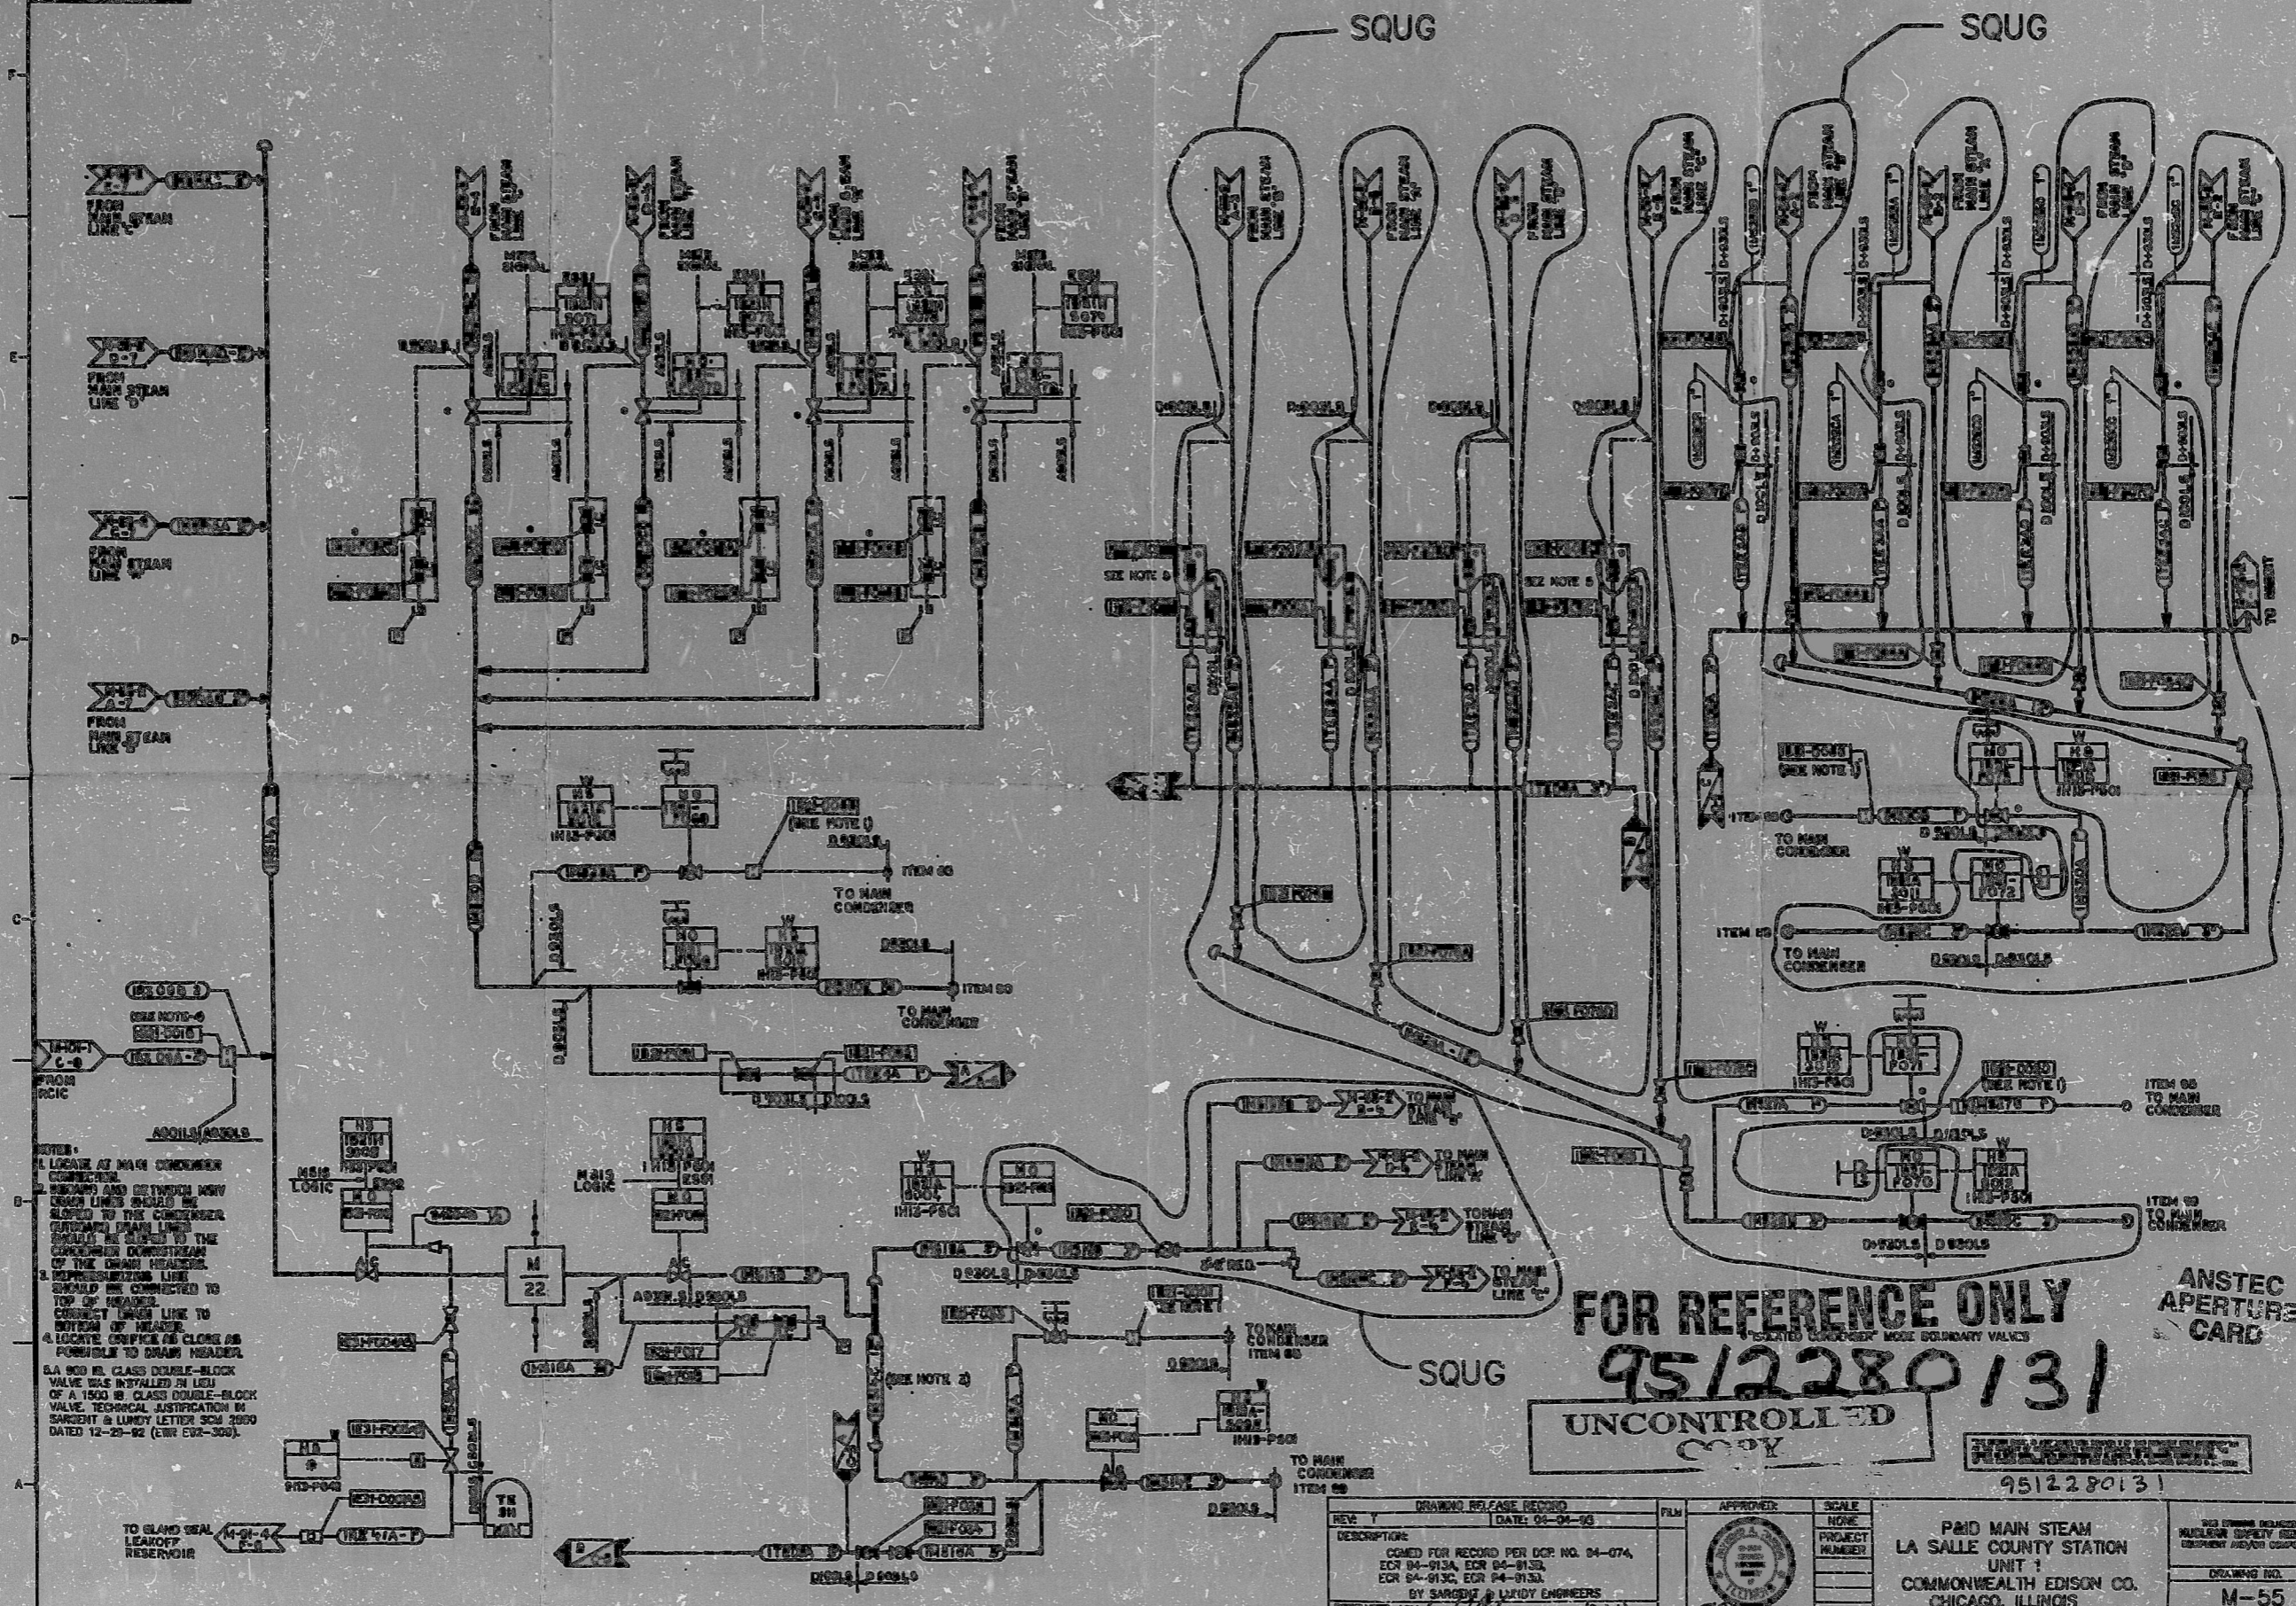

NOTES:

2. REPRESENTATION LINE SHOULD BE CONNECTED TO TOP OF HEADS. CORRECT LINE TO BOTTOM OF HEADS.
4. A 900 LB. CLASS DOUBLE-BLOCK VALVE WAS INSTALLED IN LIEU OF A 1500 LB. CLASS DOUBLE-BLOCK VALVE. TECHNICAL JUSTIFICATION BY SARSENZ & LUNDY LETTER SCM 2000 DATED 12-29-92 (LW E2-300).

FOR REFERENCE ONLY  
 9512280131  
 UNCONTROLLED COPY

ANSTEC APERTURE CARD

REV 1	DRAWING RELEASE RECORD	FILM	APPROVED	SCALE	PMD MAIN STEAM LA SALLE COUNTY STATION UNIT 1 COMMONWEALTH EDISON CO. CHICAGO, ILLINOIS	SHEET 7 M-55
DESCRIPTION:	DATE: 01-04-90			NONE		
COPIED FOR RECORD PER DCR NO. 04-074, ECR 04-013A, ECR 04-013B, ECR 04-013C, ECR 04-013D. BY SARSENZ & LUNDY ENGINEERS						
PREPARED: ASM	REVIEWED: HFB					

"CRITICAL DRAWING"

PDR RIDS

9512280131

