


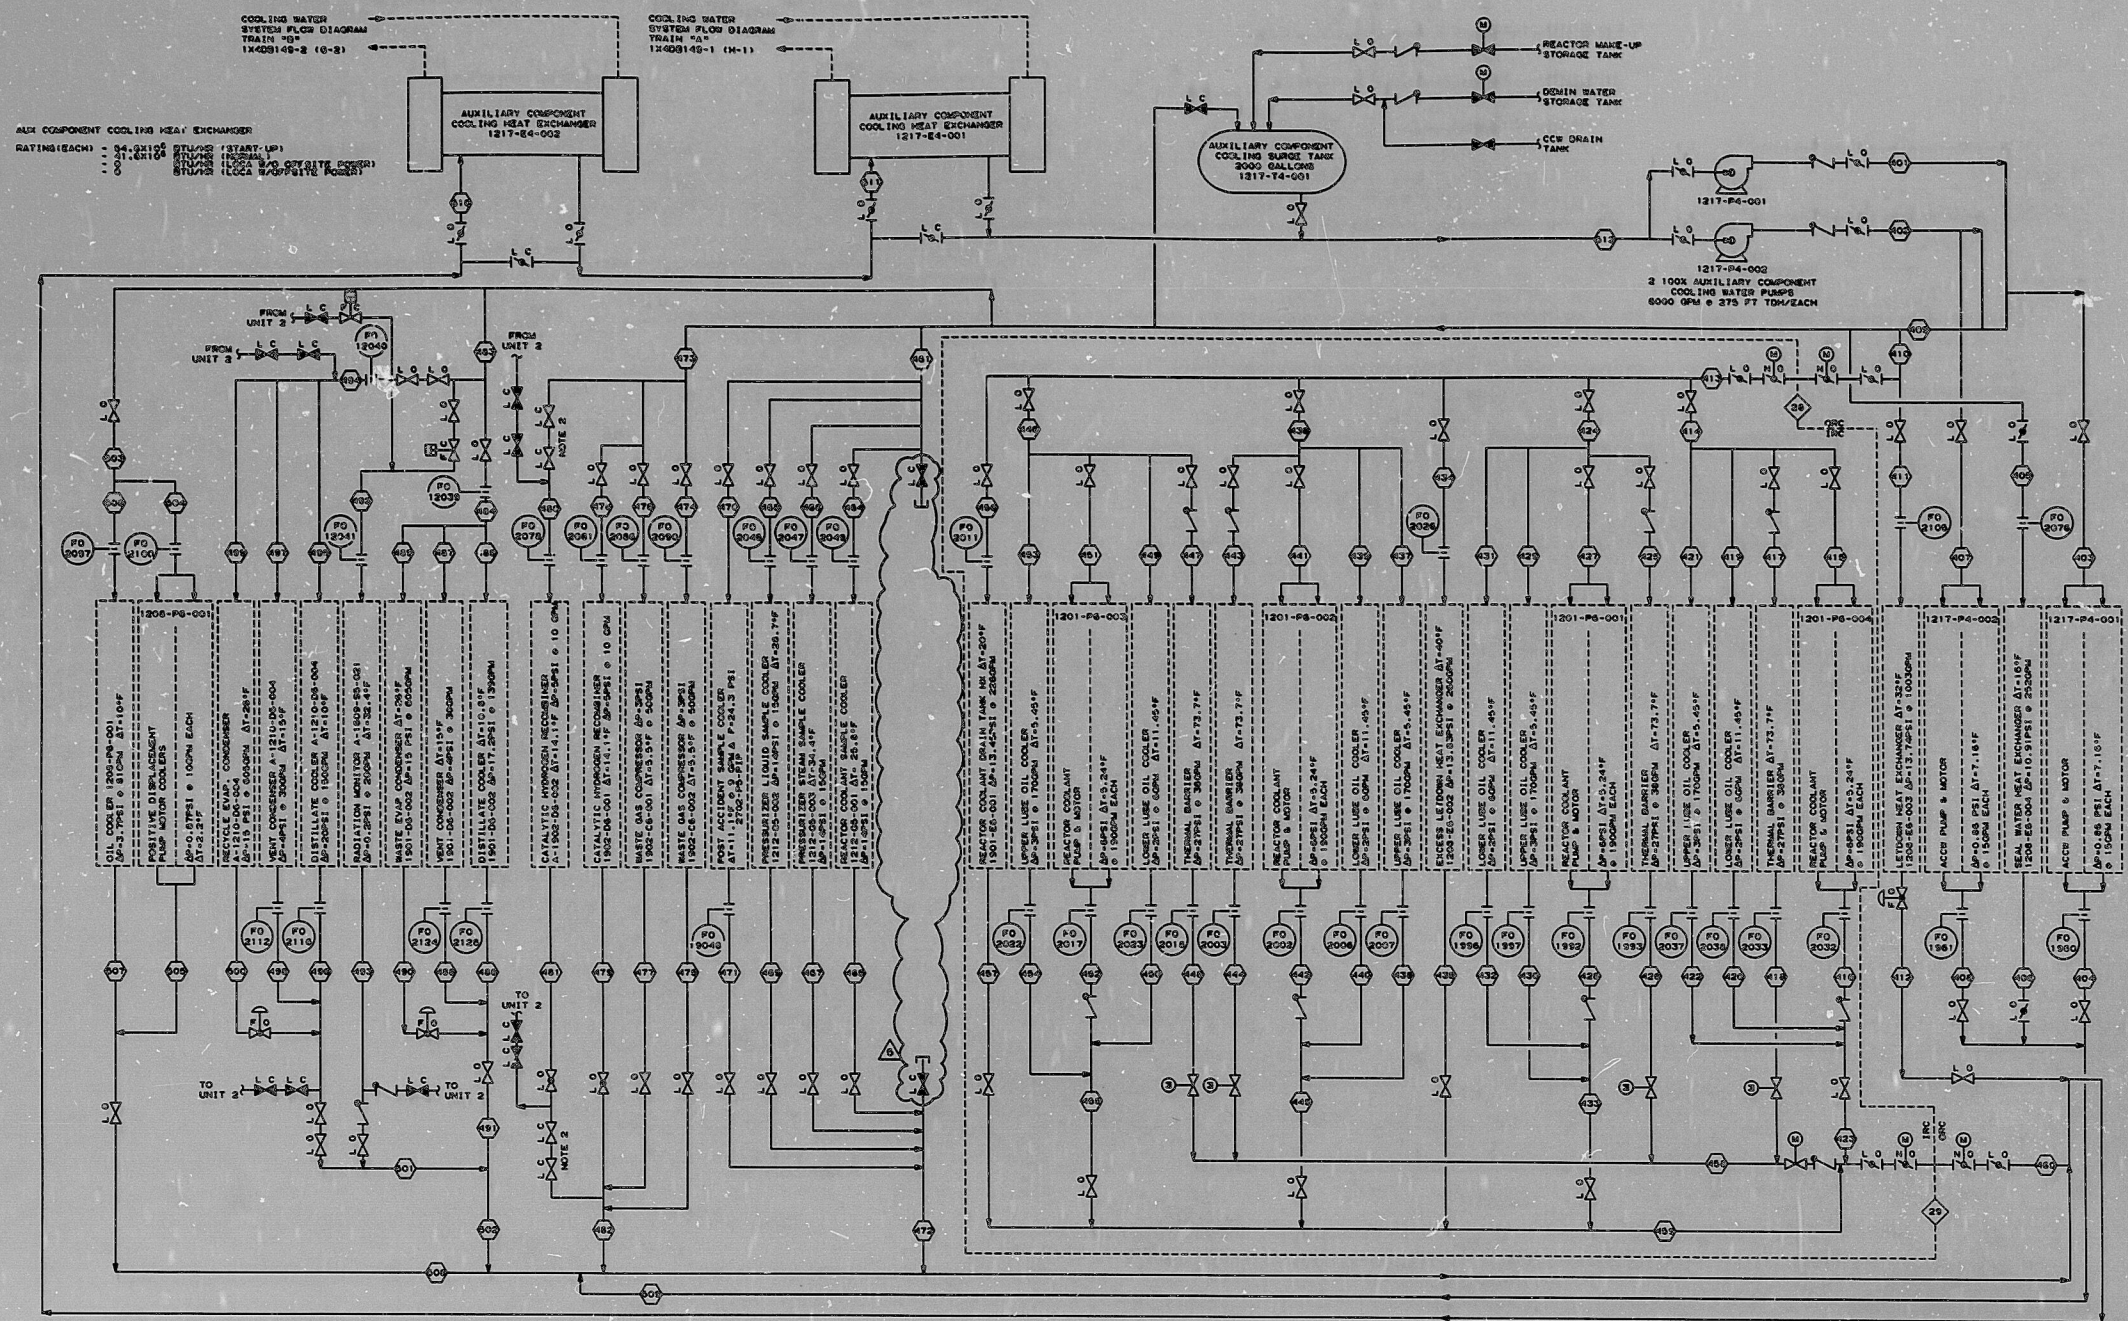

AUXILIARY COMPONENT COOLING WATER SYSTEM

- NOTE:
1. THE DATA SHOWN ON THIS FLOW DIAGRAM ARE FOR INFORMATION PURPOSES ONLY, AND WHILE USEFUL AS GUIDES IN OPERATION, DO NOT REPRESENT EXACT OR GUARANTEED OPERATING CONDITIONS.
 2. THESE VALVES WILL BE LOCKED CLOSED WHEN COOLING WATER IS SUPPLIED FROM UNIT 2.

ANSTEC
APERTURE
CARD

SOUTHERN COMPANY SERVICES, INC.
BIRMINGHAM, ALABAMA
GEORGIA POWER COMPANY
ALVIN W. VOGTLE NUCLEAR PLANT

FLOW DIAGRAM
COOLING WATER SYSTEM
SYSTEMS 1202, 1203, 1217

THIS DOCUMENT CONTAINS PROPRIETARY, CONFIDENTIAL, AND/OR TRADE SECRET INFORMATION OF THE SUBSIDIARIES OF THE SOUTHERN COMPANY OR OF THIRD PARTIES. IT IS INTENDED FOR USE ONLY BY EMPLOYEES OF, OR AUTHORIZED CONTRACTORS OF, THE SOUTHERN COMPANY. UNAUTHORIZED POSSESSION, USE, DISTRIBUTION, COPYING, DISSEMINATION, OR DISCLOSURE OF ANY PORTION HEREOF IS PROHIBITED.	INCORPORATED PER DCP 09-250003	DATE	CHK	APPV	DTL
ISSUED FOR CONSTRUCTION	DATE	CHK	APPV	DTL	
REVISIONS	DATE	CHK	APPV	DTL	
NO.	DATE	CHK	APPV	DTL	

SCALE: NONE	DRAWING NO. 1X408149-3	REV. 5
JOB NO. 10004		
SIZE E 30x44		
CAD NAME 10001493		

9705230039

PDR RIDS

9705230039

