


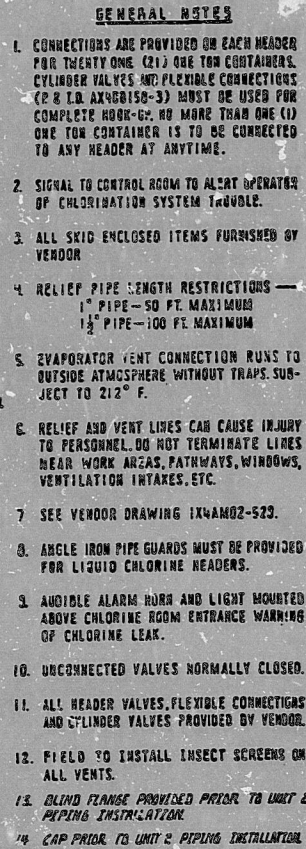

PDR RIDE

9512280157

