



ELEVATION

TI APERTURE CARD

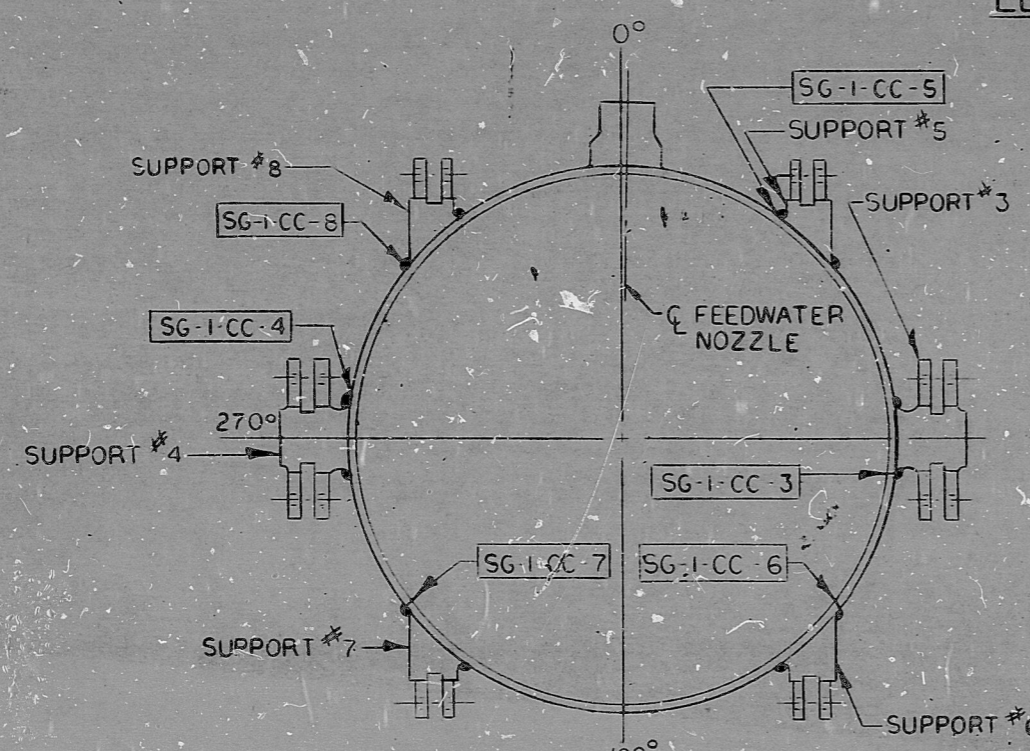

SECTION A-A

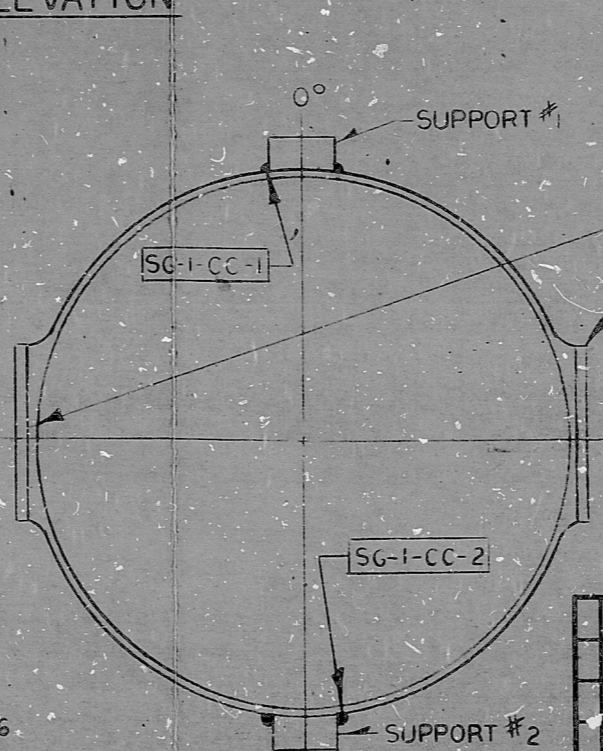

SECTION B-B

RELEASED FROM GFR CONTROL

REVISIONS DURING CONSTRUCTION		P.A. NO.

8805230119  
 QA

ZONE 2-1

REVISIONS		BY	CHK	APP	DATE	REASON
N/A	3					AS-BUILT PER DCR-M2-S-474-BB
N/A	2					AS-BUILT PER DCR-M2-S-463-BB
84-034	1					AS-BUILT PER DCR-M2-S-866-M

NORTH EAST UTILITIES SERVICE CO.  
 MILLSTONE UNIT 2  
 TITLE: STEAM GENERATOR No 1  
 INSERVICE INSPECTION PROGRAM  
 DATE: 12/15/75  
 P.A. NO. 25203-20163

SERV. CK. MECH. CK. ELEC. CK. CONC. CK. STRUC. CK. HYDR. CK. 

PDR RID'S

8805230119

