


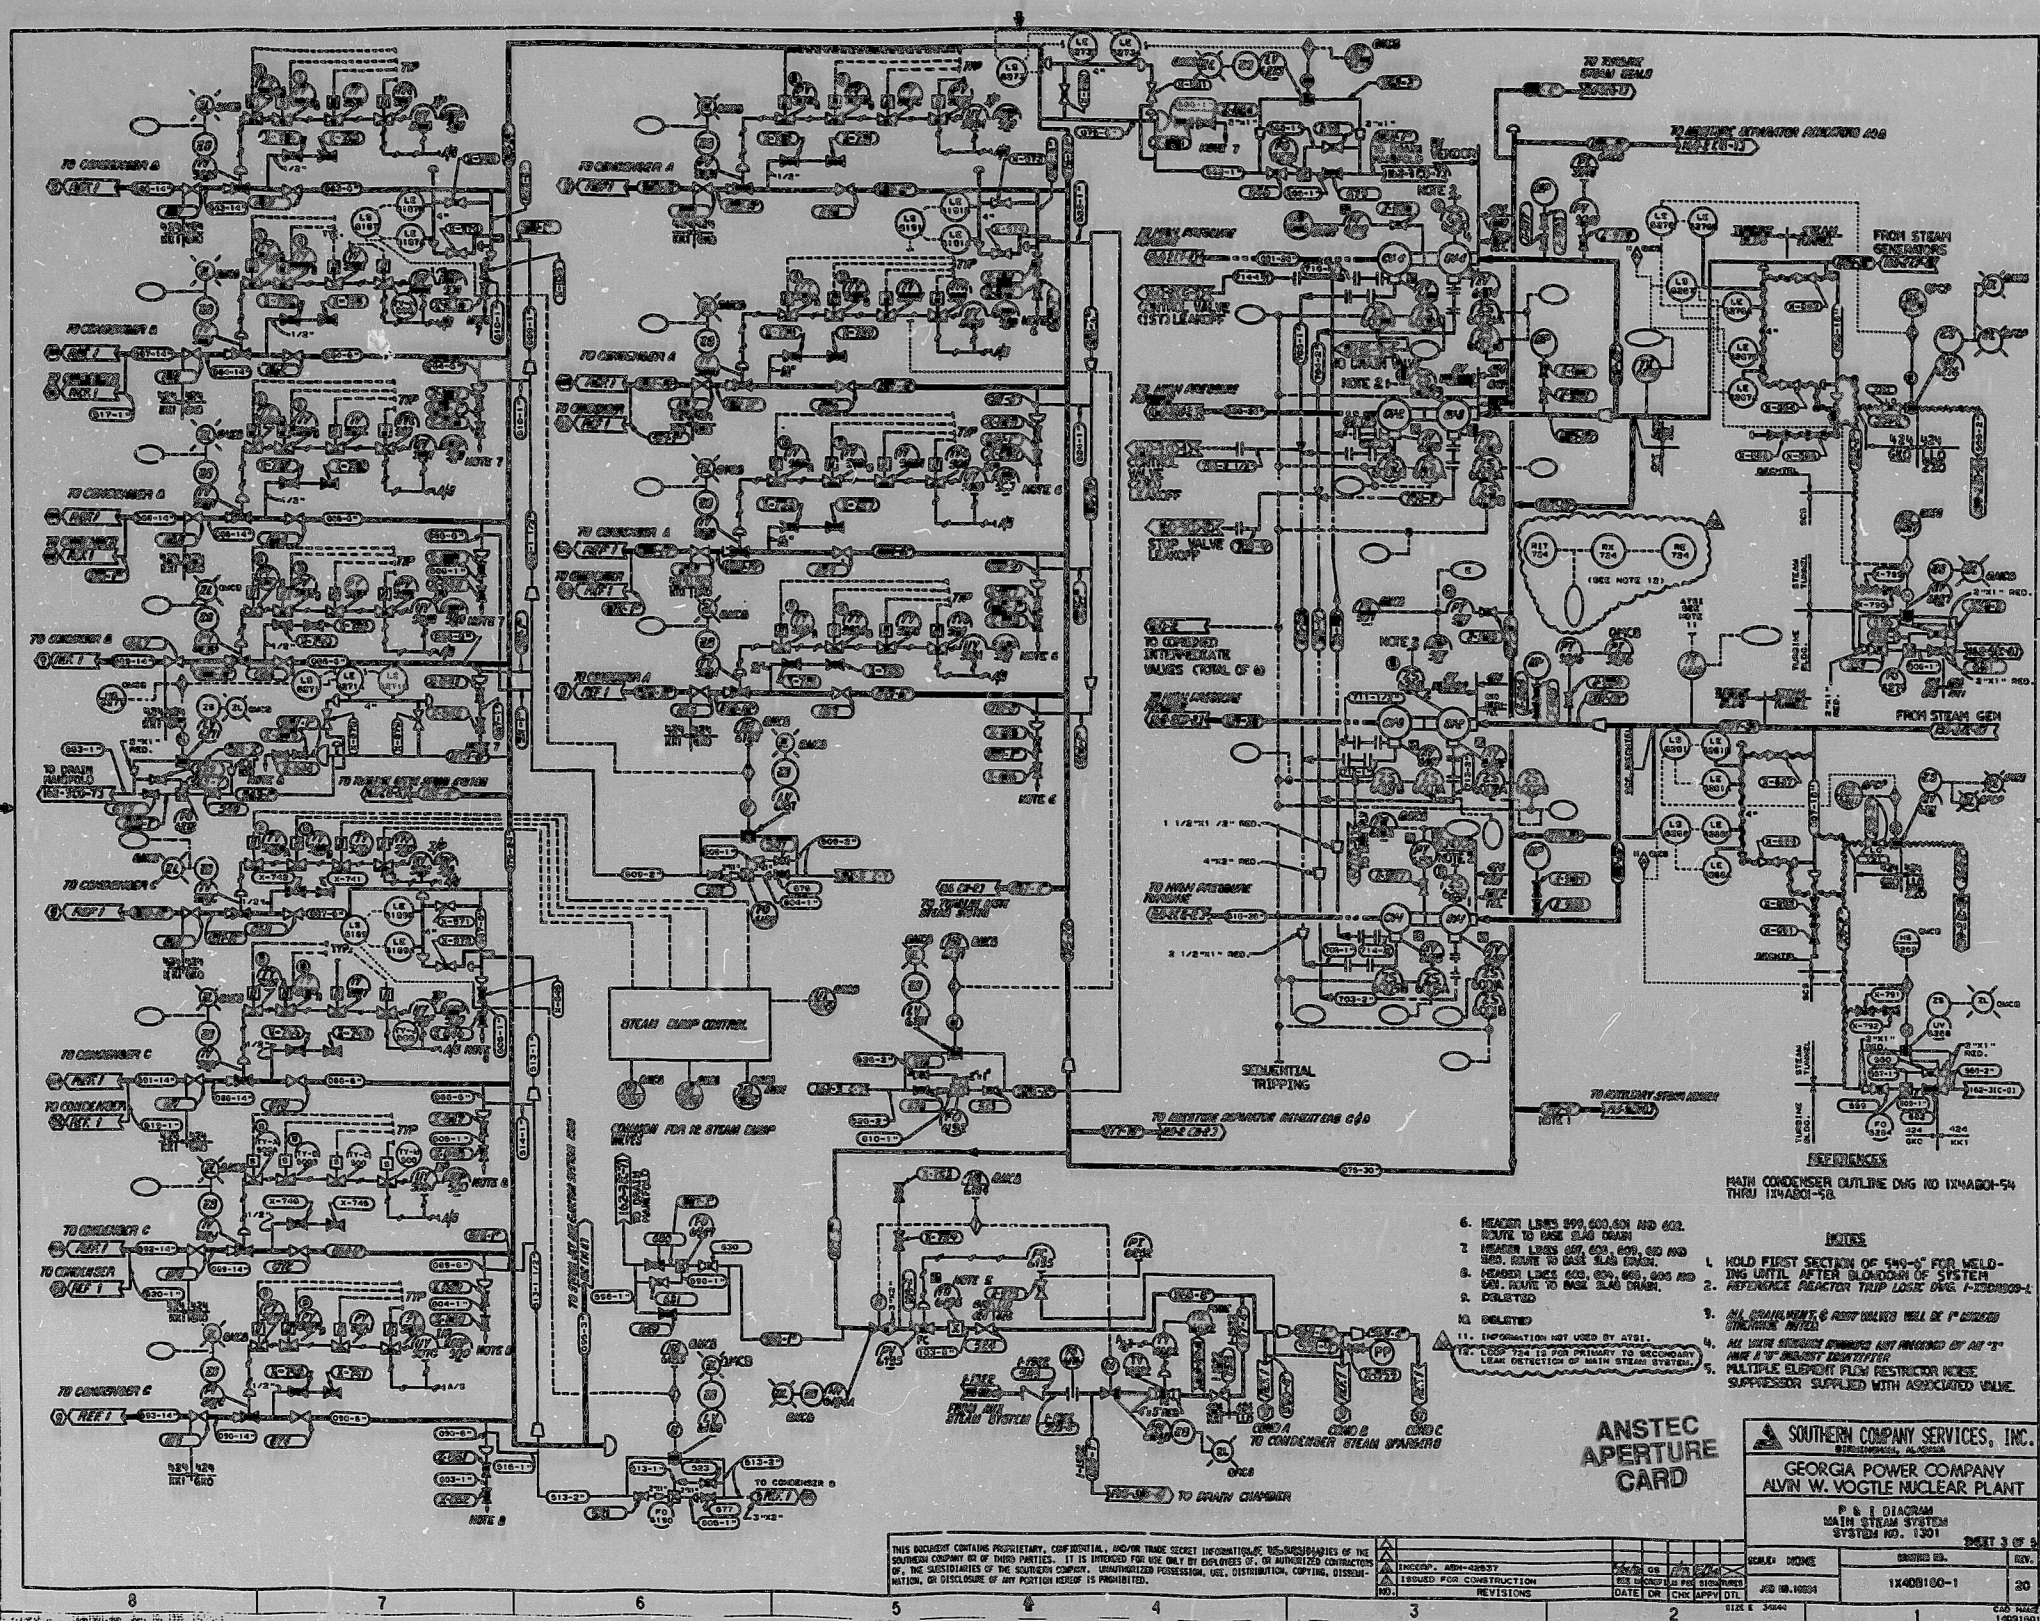

9705230125

PDR RIDS

9705230125

