


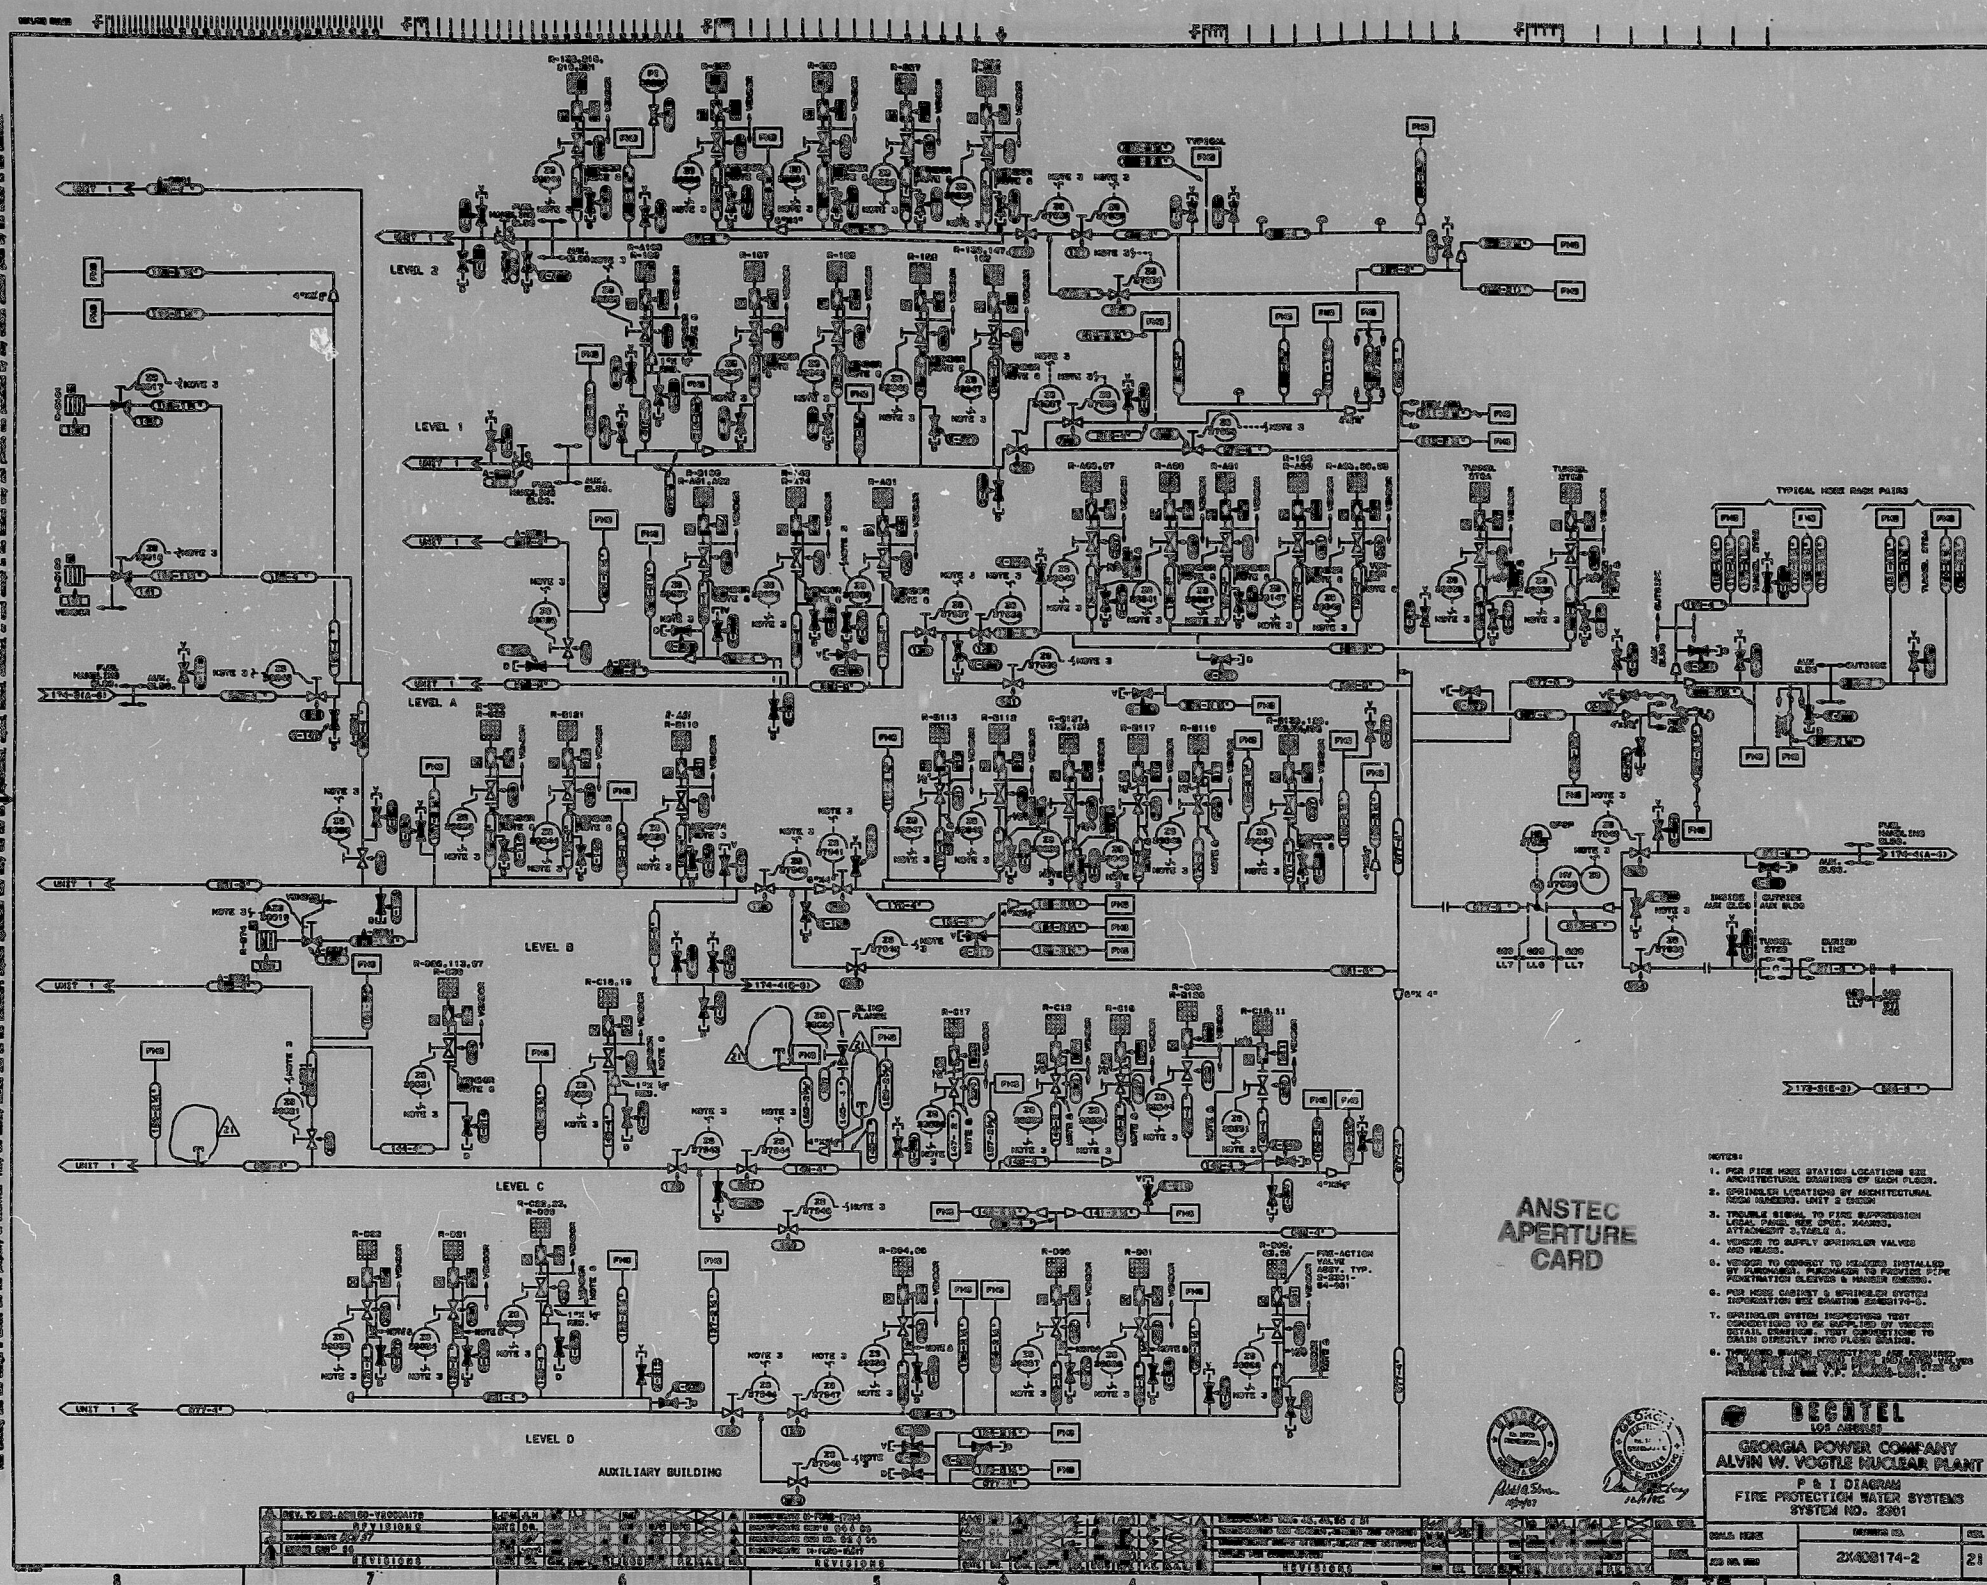



9705230152

PDR RIDS

9705230152

