


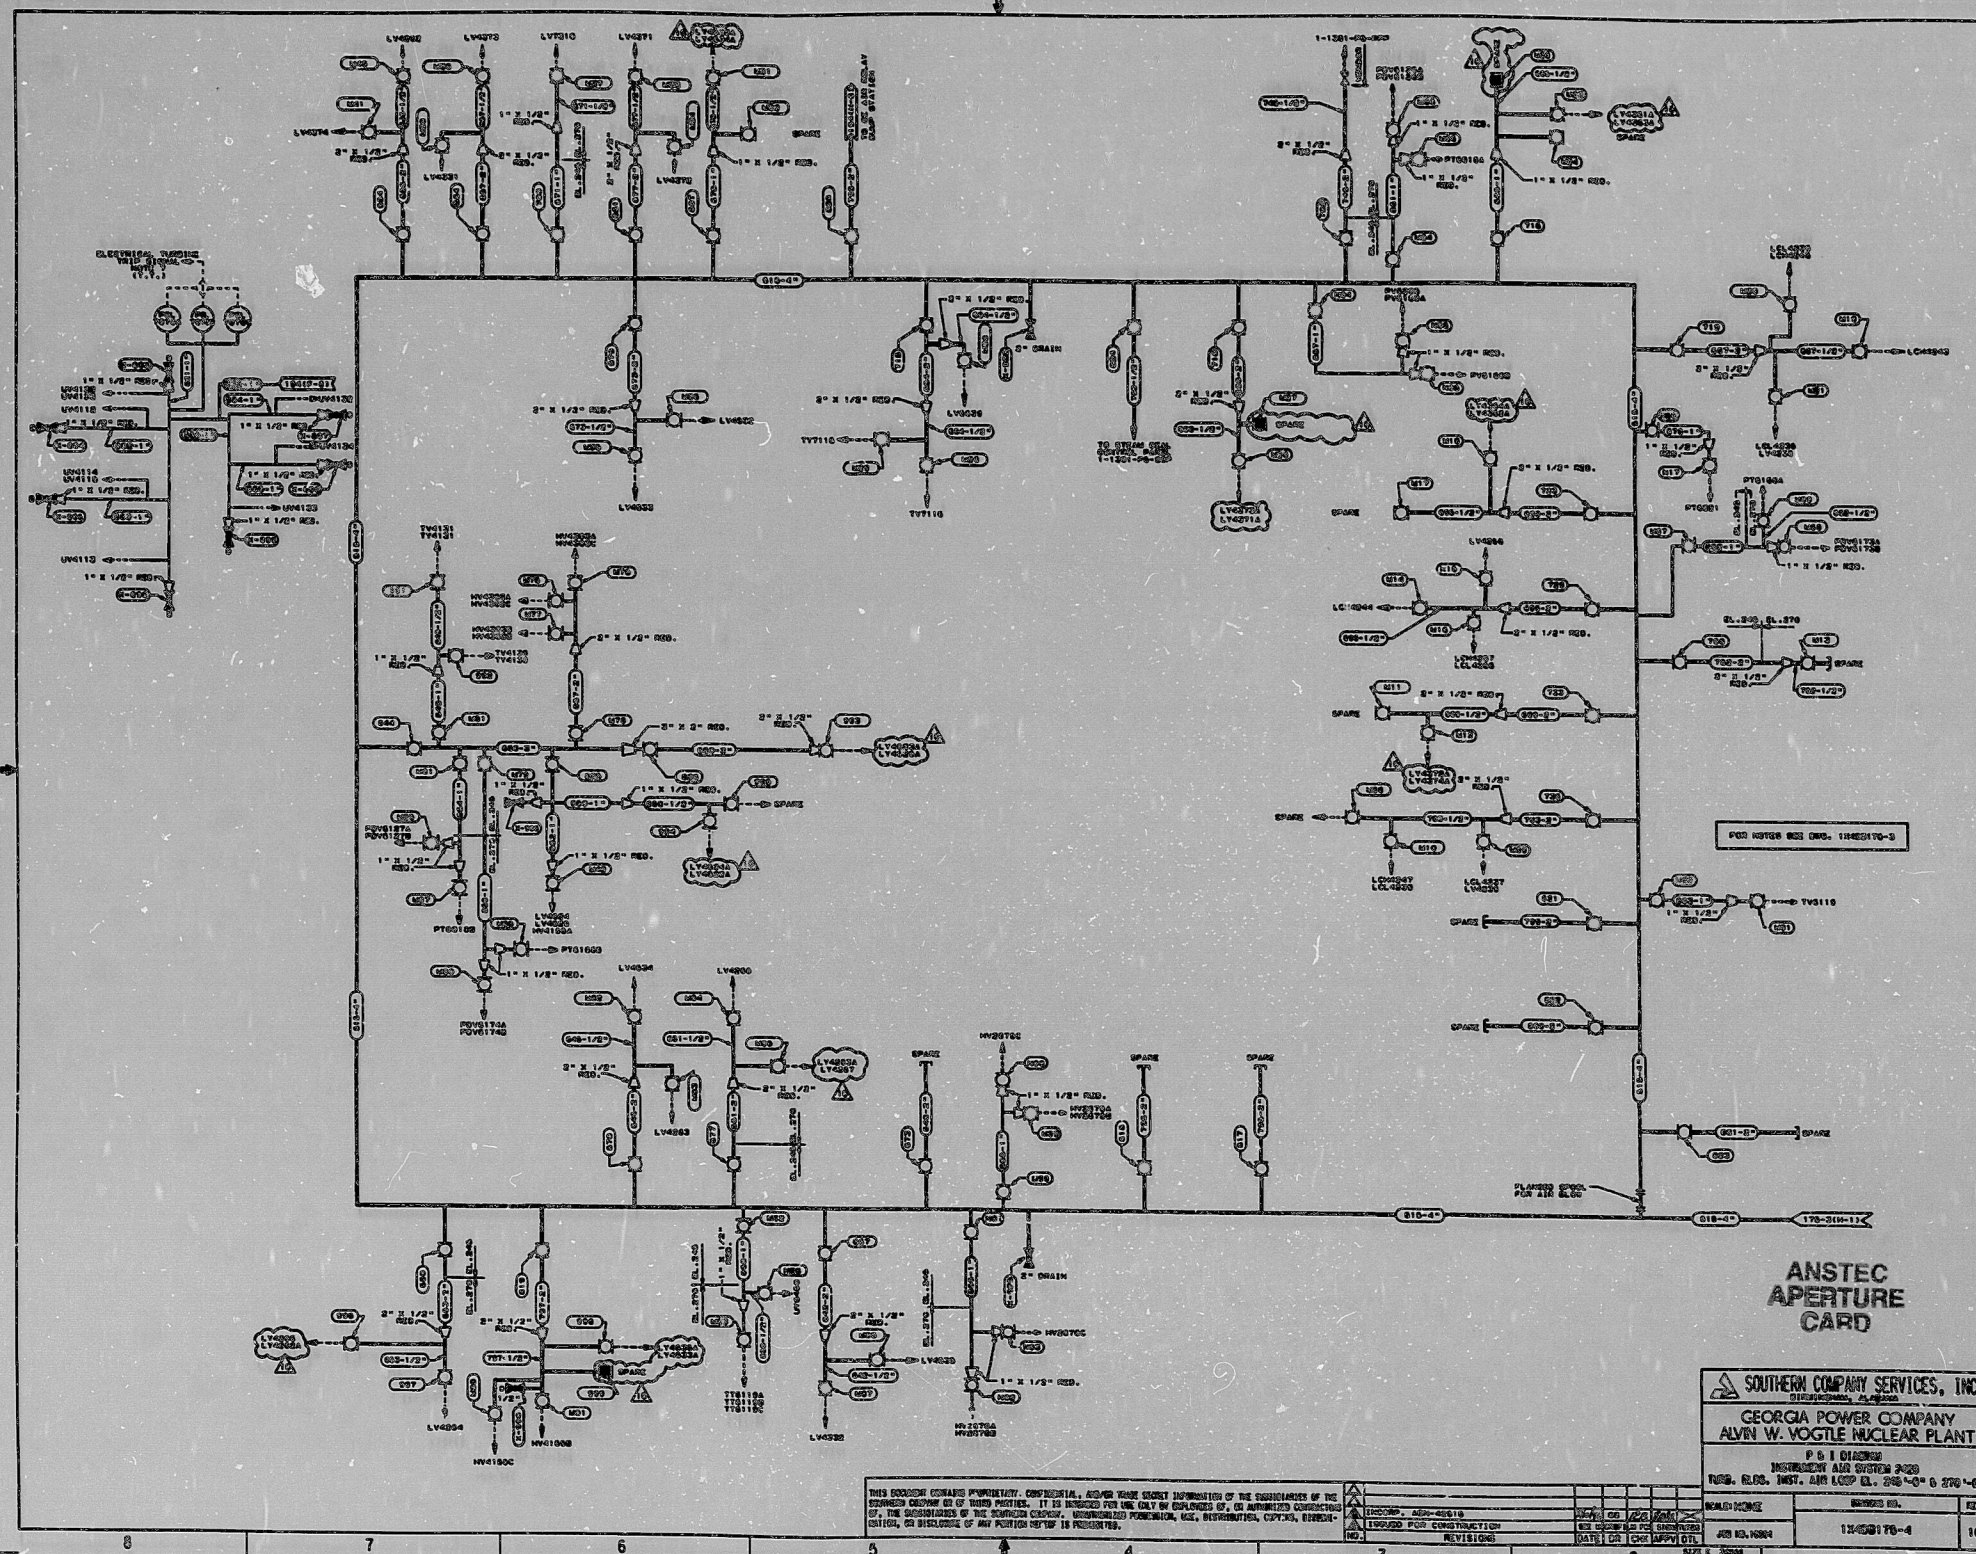

**ANSTEC
APERTURE
CARD**

 SOUTHERN COMPANY SERVICES, INC.

GEORGIA POWER COMPANY
ALVIN W. VOGTLE NUCLEAR PLANT

P & I DIAGRAM
INSTRUMENT AIR SYSTEM 3420
P&ID. ALCO. INST. AIR LOOP EL. 240'-0" @ 270'-0"

SCALE: NONE	REMARKS: NO.	RE
-------------	--------------	----


9705280311

PDR RIDS

9705280311

