


THIS DRAWING AND THE DESIGN IT CONTAINS ARE THE PROPERTY OF BECHTEL. THEY ARE LOANED AND ON THE BORROWER'S EXPRESS AGREEMENT THAT THEY WILL NOT BE REPRODUCED, COPIED, LOANED, EXHIBITED, OR USED EXCEPT IN THE LIMITED WAY AND FOR THE PURPOSES SPECIFICALLY AUTHORIZED BY THE LENDER TO THE BORROWER.

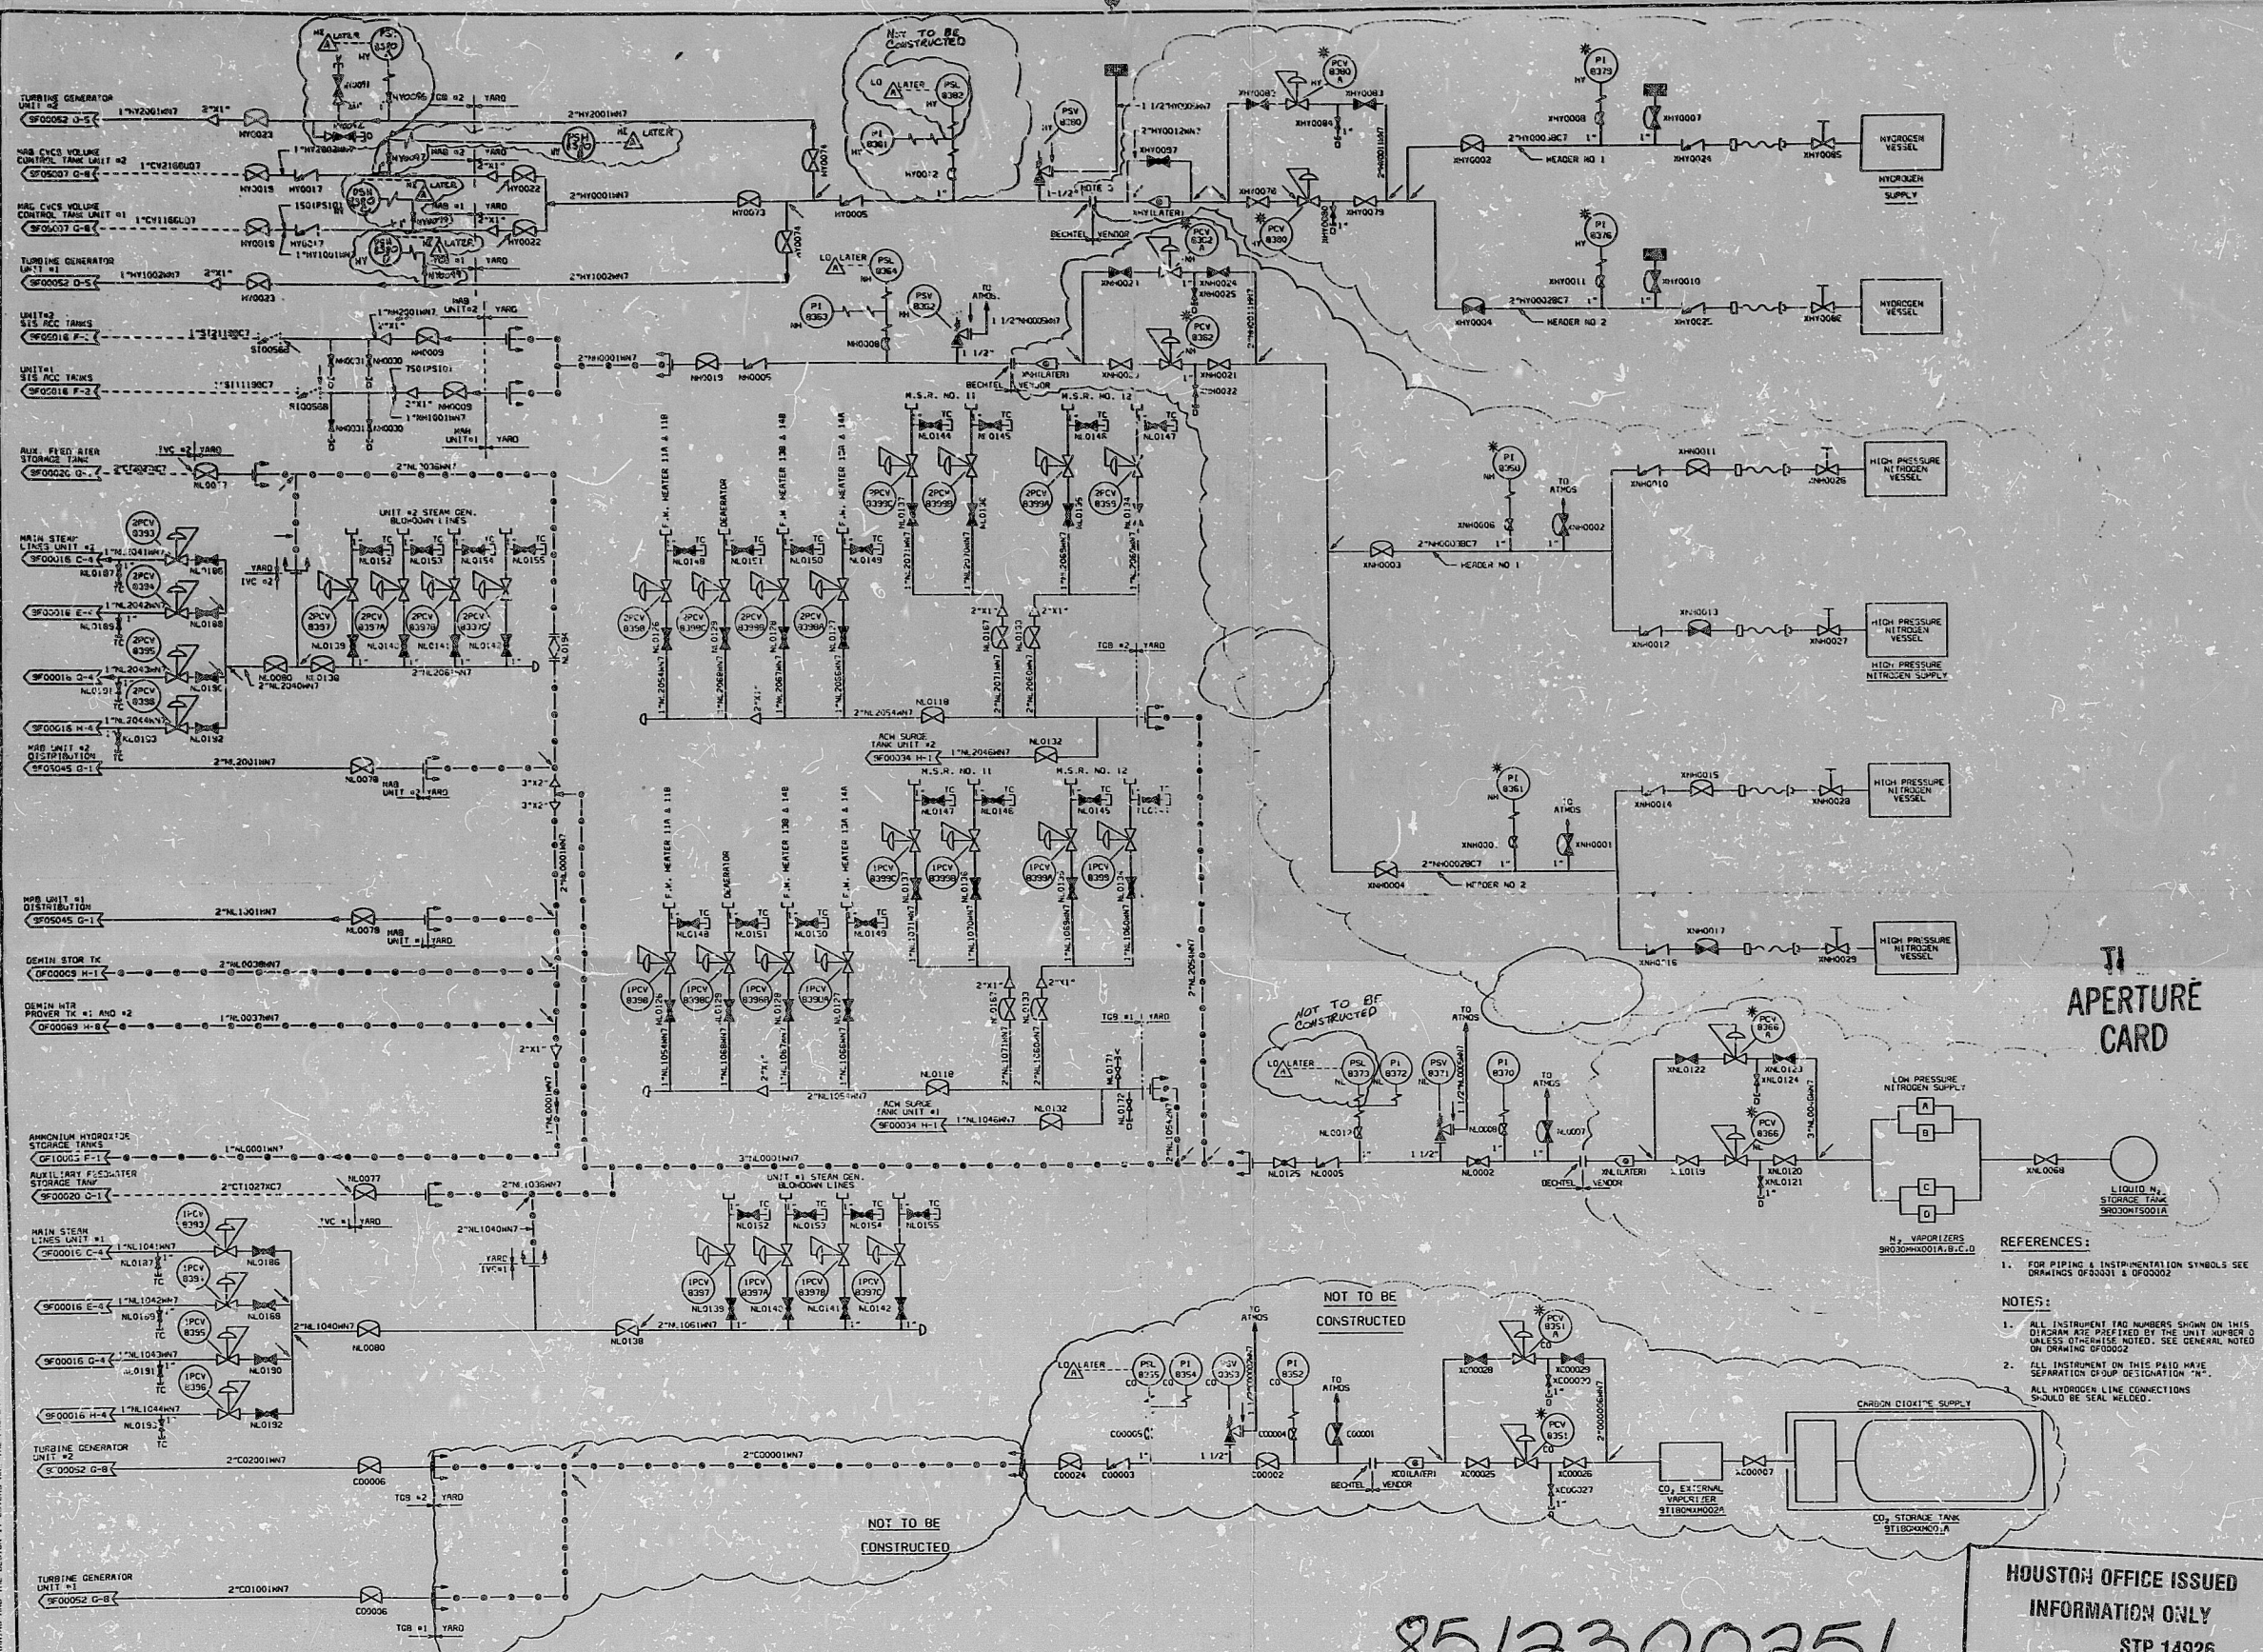

NO.	REVISION	DATE	BY	CHKD	APPD	REVISION	DATE	BY	CHKD	APPD
1	ISSUED FOR CONSTRUCTION OF BULK GAS STORAGE TANKS	7/11/82	...	...	...	1	ISSUED FOR CONSTRUCTION OF BULK GAS STORAGE TANKS	7/11/82	...	...
2	REVISED AS NOTED AND INCORP. DCH 1	7/11/82	...	...	...	2	REVISED AS NOTED AND INCORP. DCH 1	7/11/82	...	...
3	ISSUED FOR CONSTRUCTION OF BULK GAS STORAGE TANKS	9/14/82	...	...	...	3	ISSUED FOR CONSTRUCTION OF BULK GAS STORAGE TANKS	9/14/82	...	...

8512300251

BECHTEL ENERGY CORPORATION
HOUSTON, TEXAS
HOUSTON LIGHTING & POWER CO.
SOUTH TEXAS PROJECT

HOUSTON OFFICE ISSUED
INFORMATION ONLY
STP 14926

SCALE	JOB NO.	DRAWING NO.	REV.
NONE	14926	6T180F00015	5

FDR RIDS

8512300251

