


THIS DRAWING AND THE DESIGN IT COVERS ARE THE PROPERTY OF BECHTEL. THEY ARE LOANED TO YOU BY THE PROJECT MANAGER. IT IS YOUR RESPONSIBILITY TO RETURN THEM TO THE PROJECT MANAGER. THEY WILL NOT BE REPRODUCED, COPIED, LOANED, EXHIBITED, OR USED EXCEPT IN THE LIMITED MANNER AND PRIVATE USE PERMITTED BY ANY WRITTEN CANNOTATION GIVEN BY THE PROJECT MANAGER.


LD0140 06/07/05 13:59 KDS COMP. D

NO	SIGNATURE	DATE	REFERENCE	NO	DATE	REFERENCE	NO	DATE	REVISION	RE	CHK	DL	EDS	PE	NO	DATE	REVISION	RE	CHK	DL	EDS	PE
3	N/A	4974-00219-7R	V/D ZLP-104												3	4/1/04	INC DCN 4					
2	N/A	4077-01009-0N	V/D CONT. PNL												2	4/1/04	REVISED AS NOTED					
1	N/A	4077-01005-0N	V/D ELEM. DIA												1	4/1/04	INC DCN 1,2,3 & MOD					
0	N/A	4077-01020-0N	V/D WIRING DIA												0	4/1/04	ISSUED FOR CONST					
NO	SIGNATURE	DATE	REFERENCE	NO	DATE	REFERENCE	NO	DATE	REVISION	RE	CHK	DL	EDS	PE	NO	DATE	REVISION	RE	CHK	DL	EDS	PE

LACB00

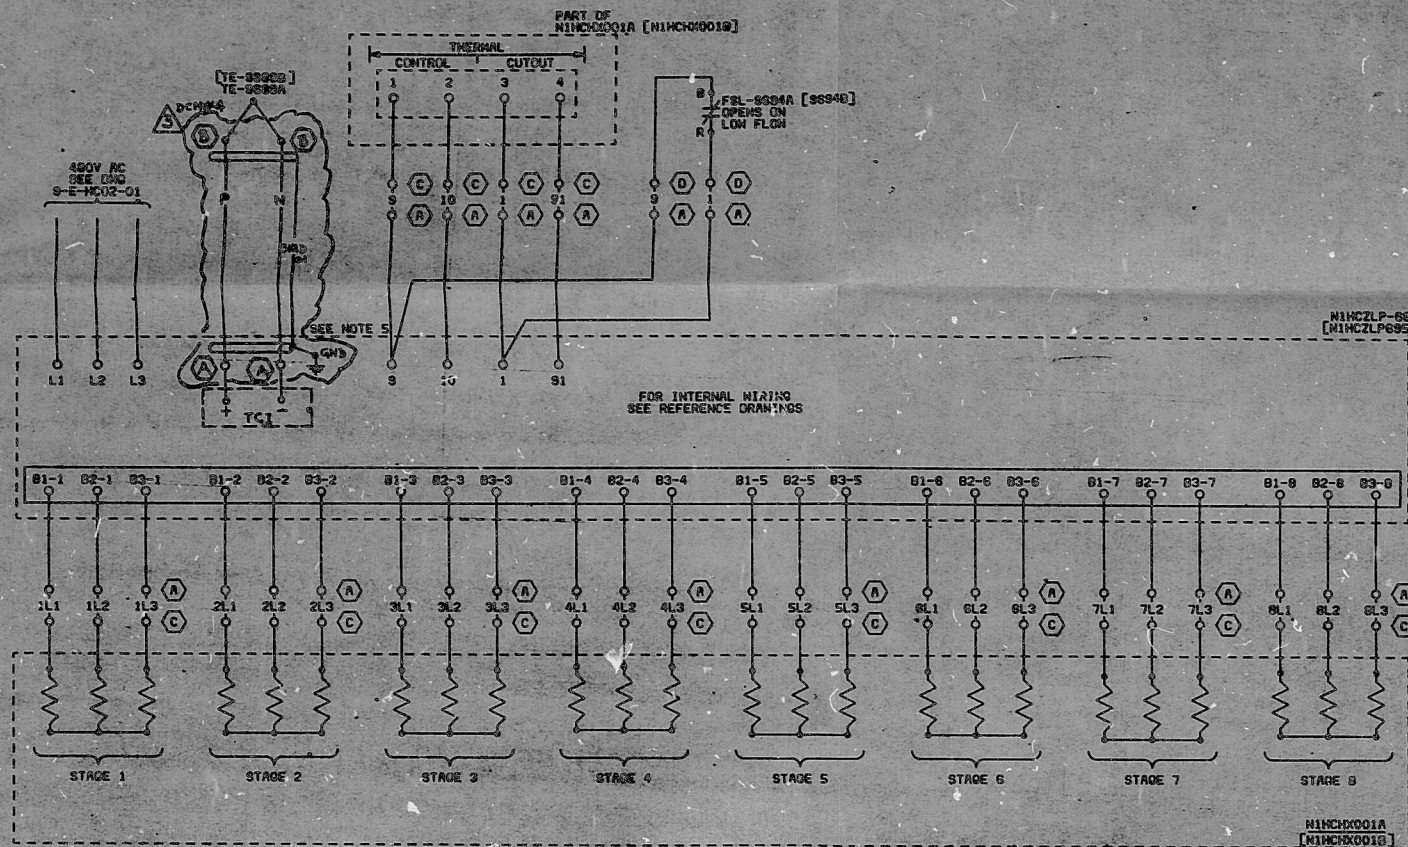


93
1-SR
94
TO DMC
9-E-HC02-01

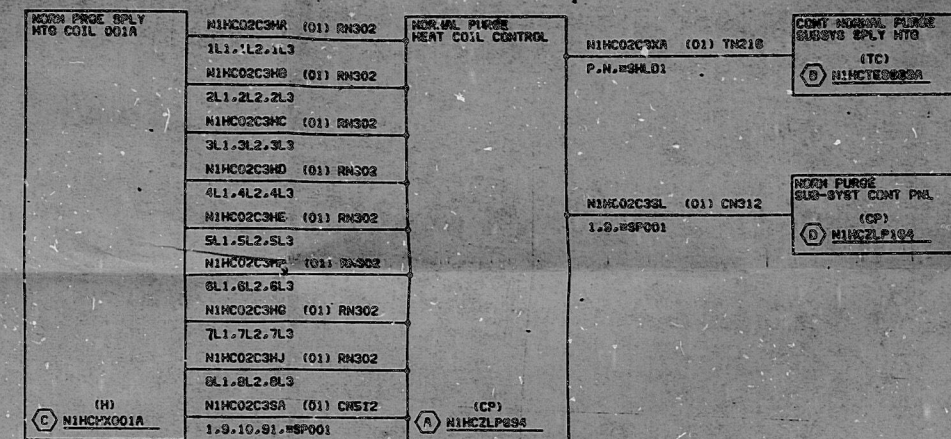

CABLE BLOCK DIAGRAM 3

SCHEME NIMC02C3
R.C.B. HVAC NORMAL PURGE
SUPPLY HEATING COIL
(NIMC0001A)

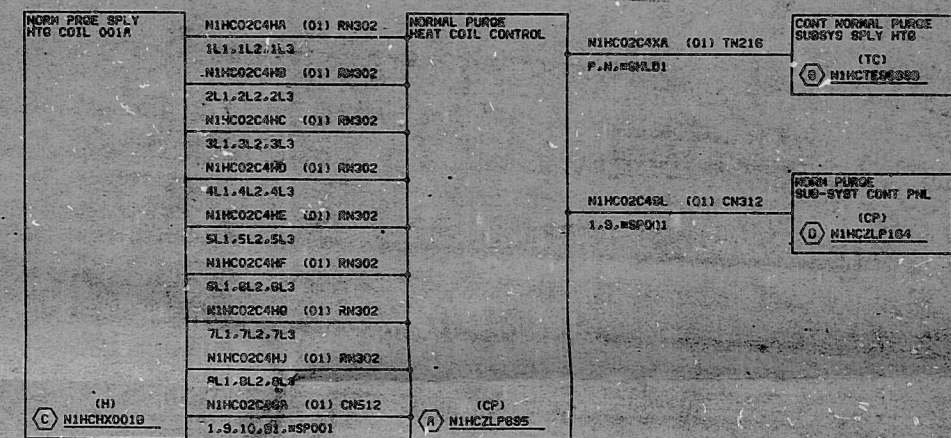

CABLE BLOCK DIAGRAM 4

SCHEME NIMC02C4
R.C.B. HVAC NORMAL PURGE
SUPPLY HEATING COIL
(NIMC0001B)

- NOTES:
- FOR LEGEND AND SYMBOLS REFER TO DRAWINGS 9-E-NZ01-01 AND 9-E-NZ01-02.
 - O - DENOTES LOCATION NUMBER. FOR COMPLETE LOCATION NUMBER REFER TO CABLE BLOCK DIAGRAMS SHOWN ON THIS DRAWING.
 - CABLE NUMBERS FOR POWER CABLE TO THE DUCT HTG ARE ASSIGNED FROM THIS DNG.
 - ELEMENTARY SHOWN IS FOR HTR NIMC001A. HTR NIMC001B IS SIMILAR EXCEPT AS NOTED OR INDICATED ON CHASING BLOCK DRAWINGS AND IN BRACKETS.
 - FIELD TO TAPE BACK SHIELD.

BECHTEL ENERGY CORPORATION
HOUSTON, TEXAS
HOUSTON LIGHTING & POWER CO.
SOUTH TEXAS PROJECT

ELEMENTARY DIAGRAM APPROVAL
R.C.B. HVAC
NORMAL PURGE SUPPLY
HEATING COILS NIMC001A & B
SCALE: 1/8" = 1'-0"
DRAWING NO.: 9-E-HC02-02
REV: 3

8701 22 0030

PDR RIDS

8701220030

