


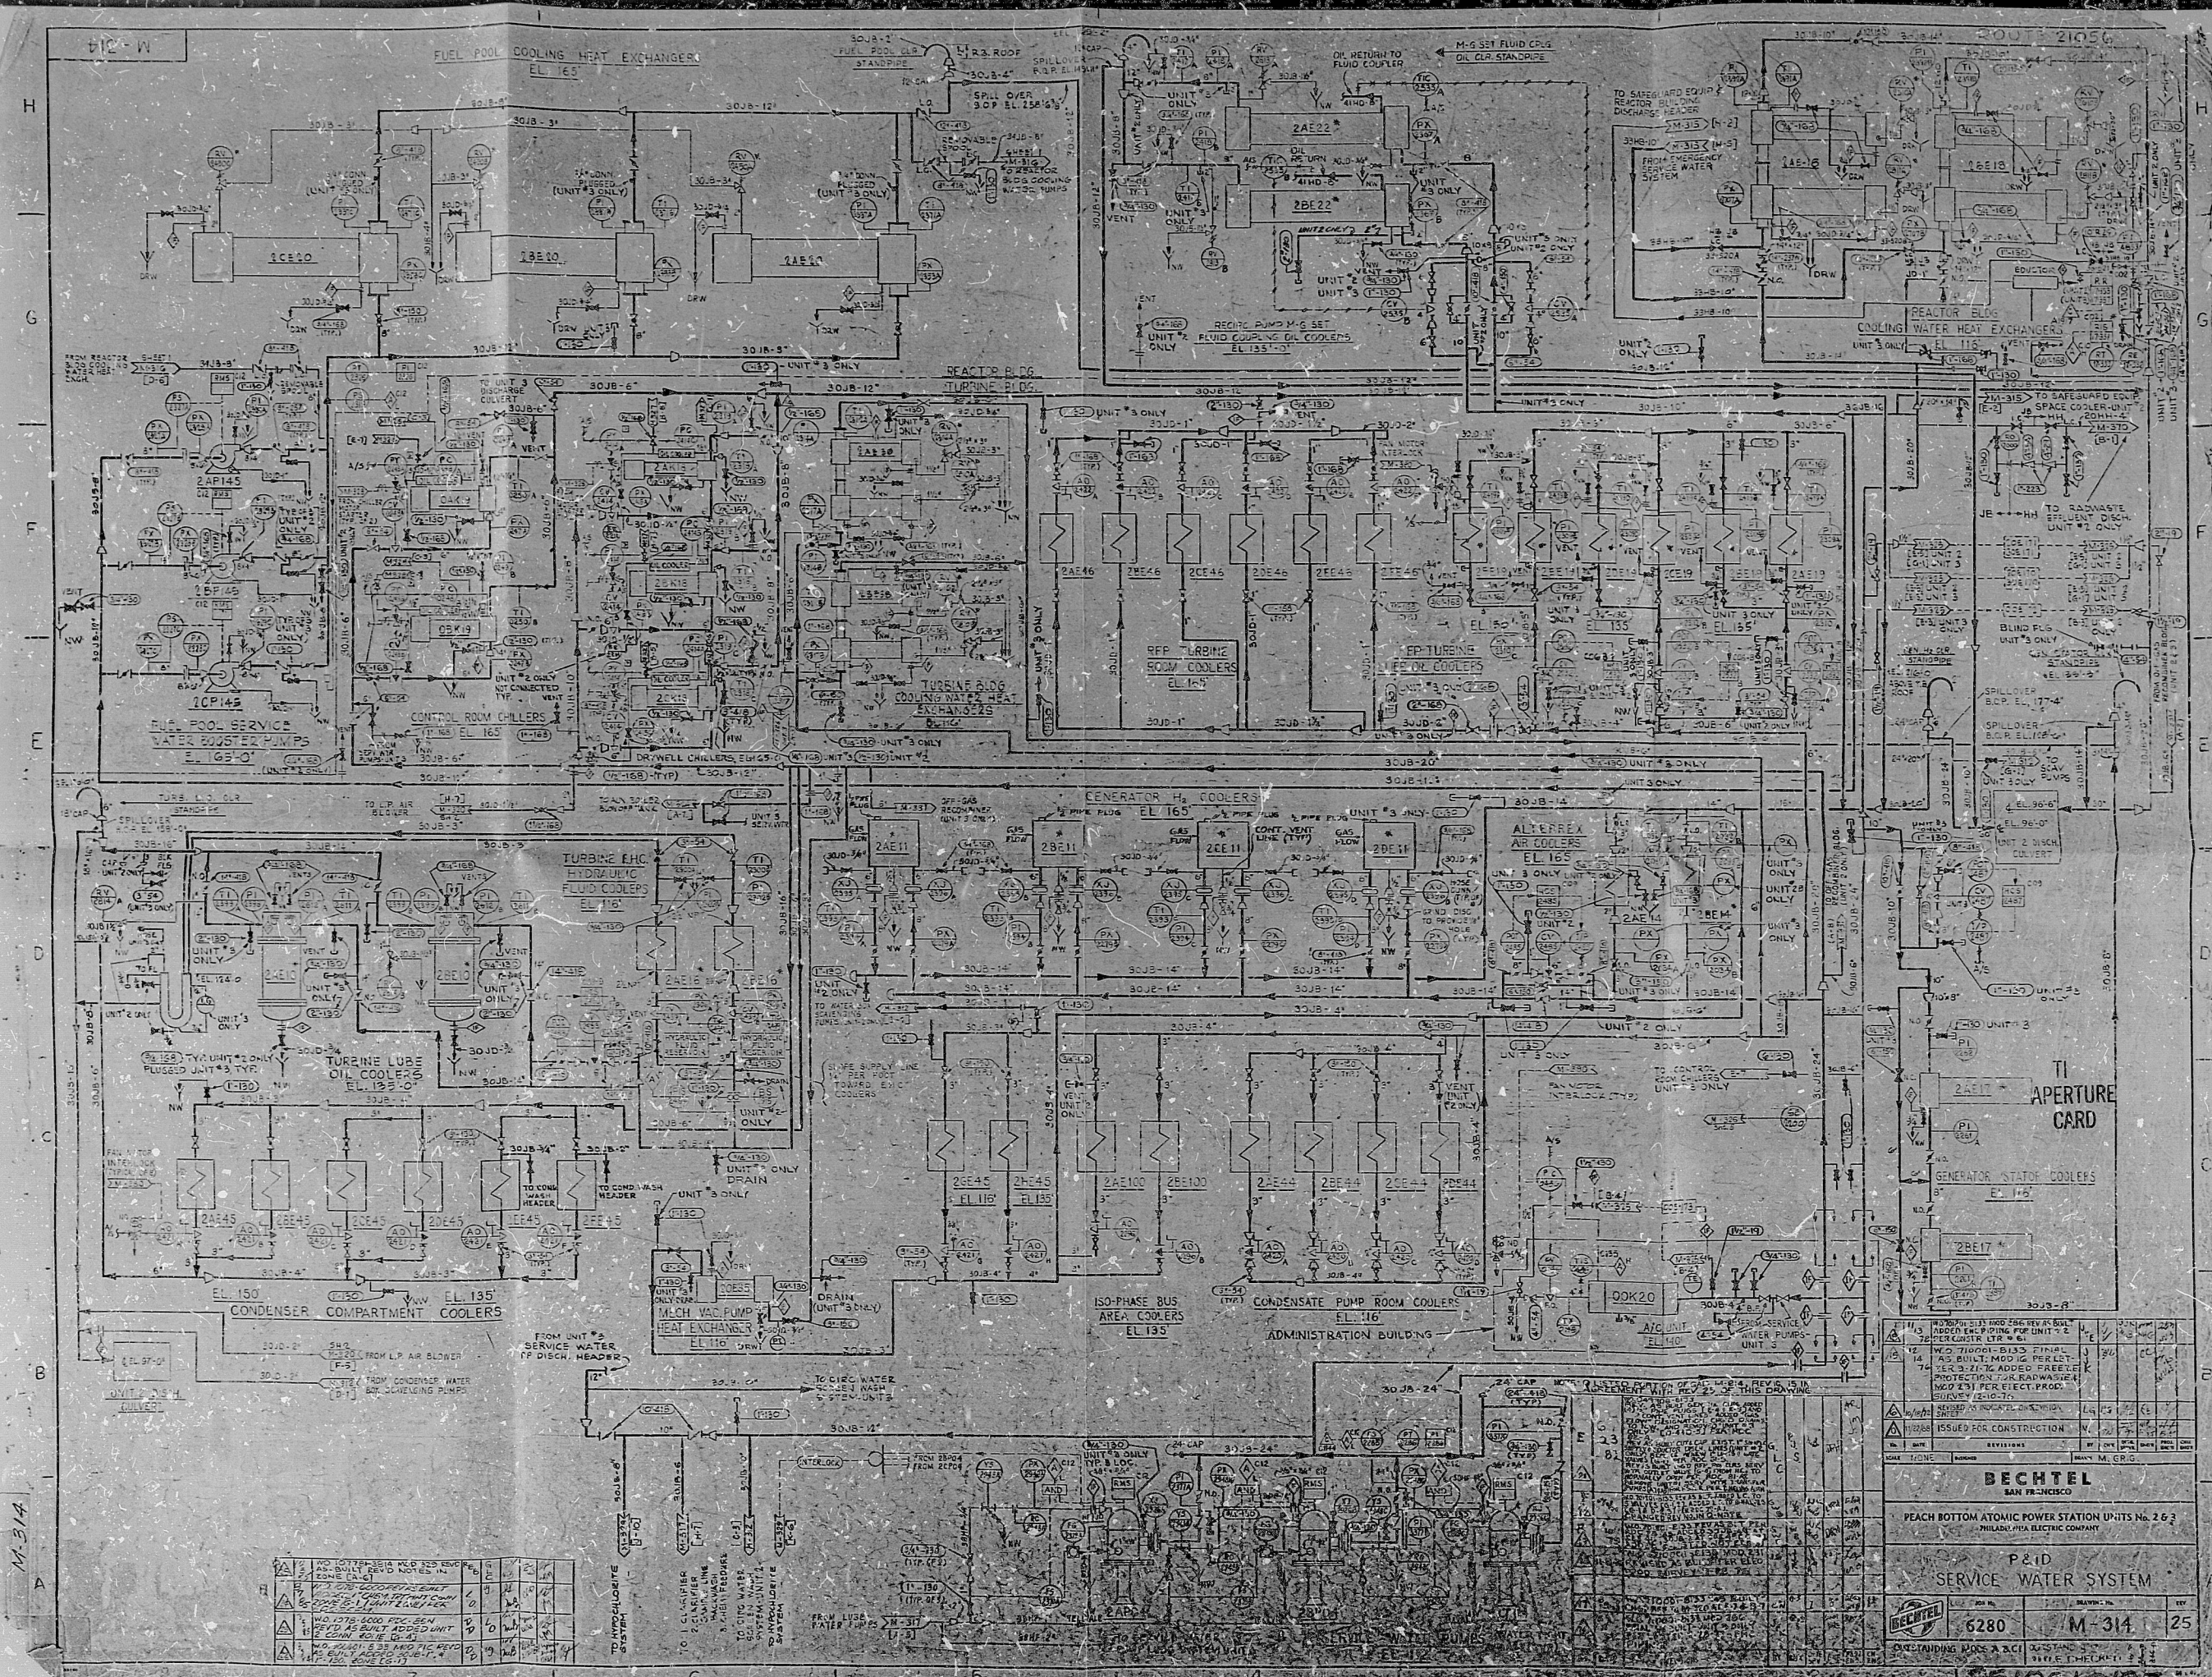



R105

8512310195

