


AK1000000

This drawing and the design it covers are the property of BECHTEL. They are provided for your information only and are not to be reproduced, copied, loaned, exhibited, or used except in the limited way and for the limited purpose for which they are provided.

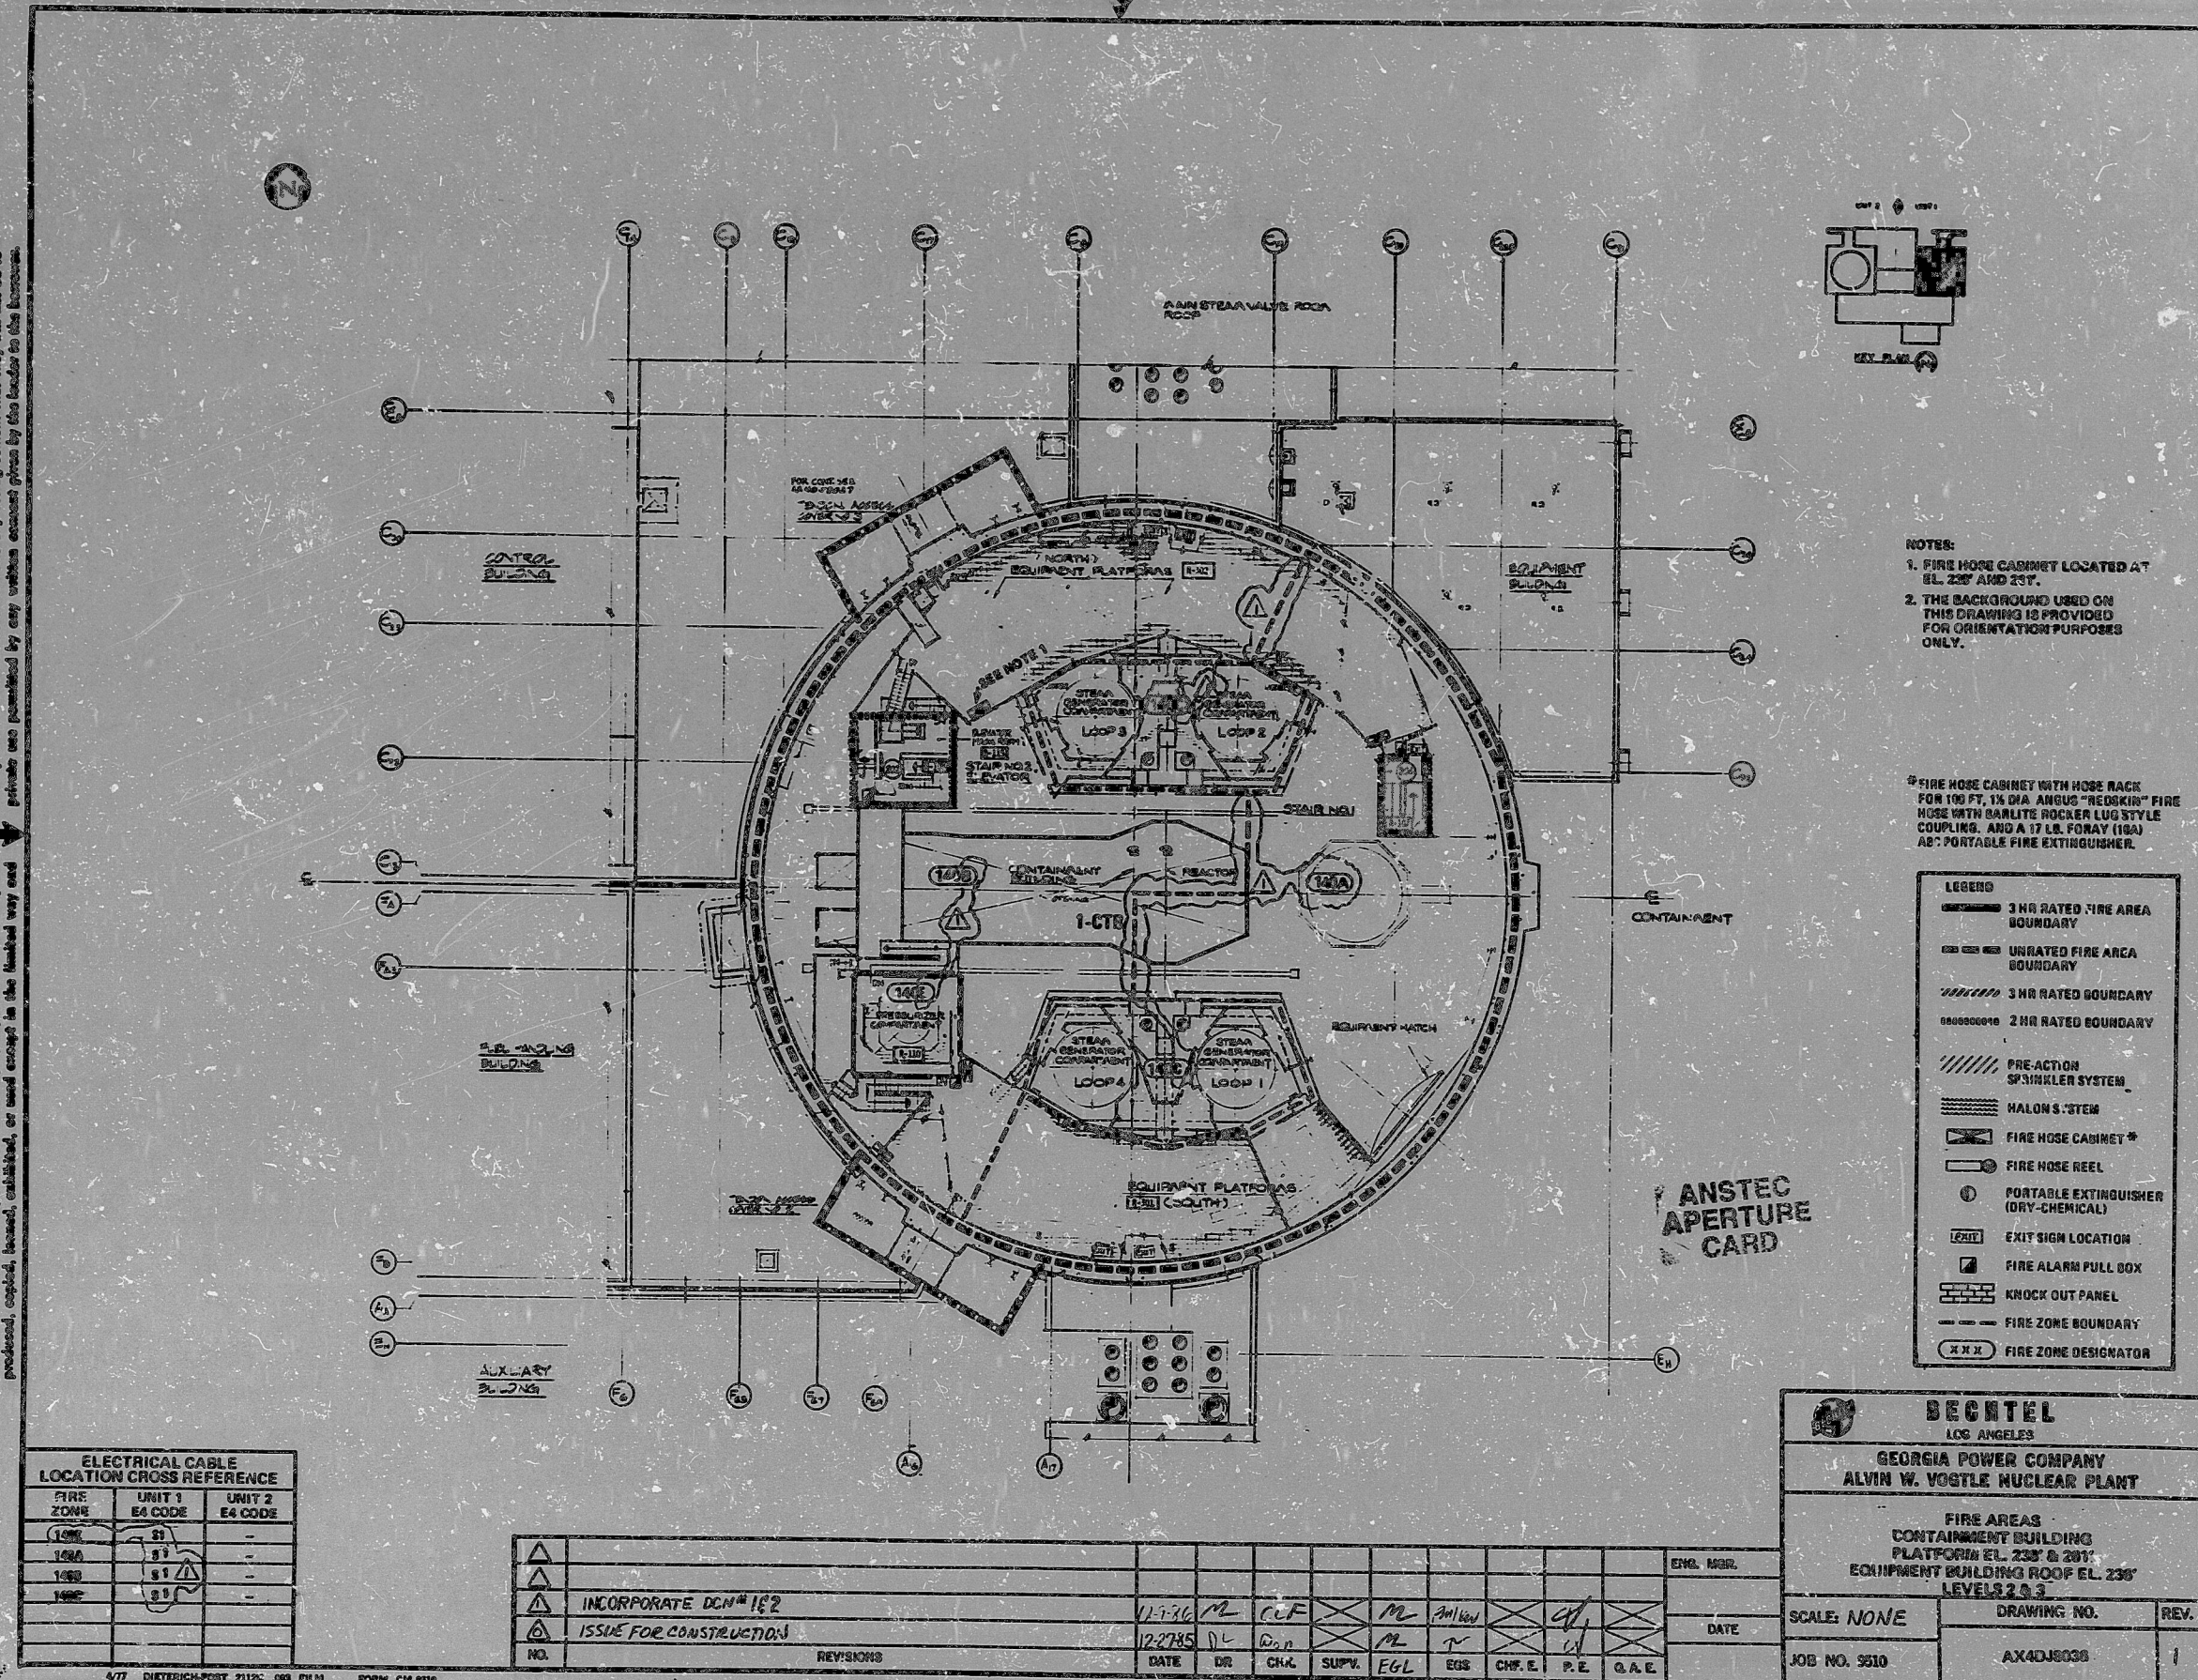

ELECTRICAL CABLE LOCATION CROSS REFERENCE		
FIRE ZONE	UNIT 1 E4 CODE	UNIT 2 E4 CODE

NO.	REVISIONS	DATE	DR	CHK	SUPV	EG	EGS	CHK	P.E.	G.A.E.
1	INCORPORATE DCN# 102	11-1-80	M	CLF		M	Am			
2	ISSUE FOR CONSTRUCTION	12-27-85	DL	Don		M	T			

BECHTEL LOS ANGELES	
GEORGIA POWER COMPANY ALVIN W. VOGTLE NUCLEAR PLANT	
FIRE AREAS CONTAINMENT BUILDING PLATFORM EL. 235' & 201' EQUIPMENT BUILDING ROOF EL. 235' LEVEL 2 & 3	
SCALE: NONE	DRAWING NO. AX4DJ8038
JOB NO. 9510	REV. 1

PDR RIES

9601030202

