


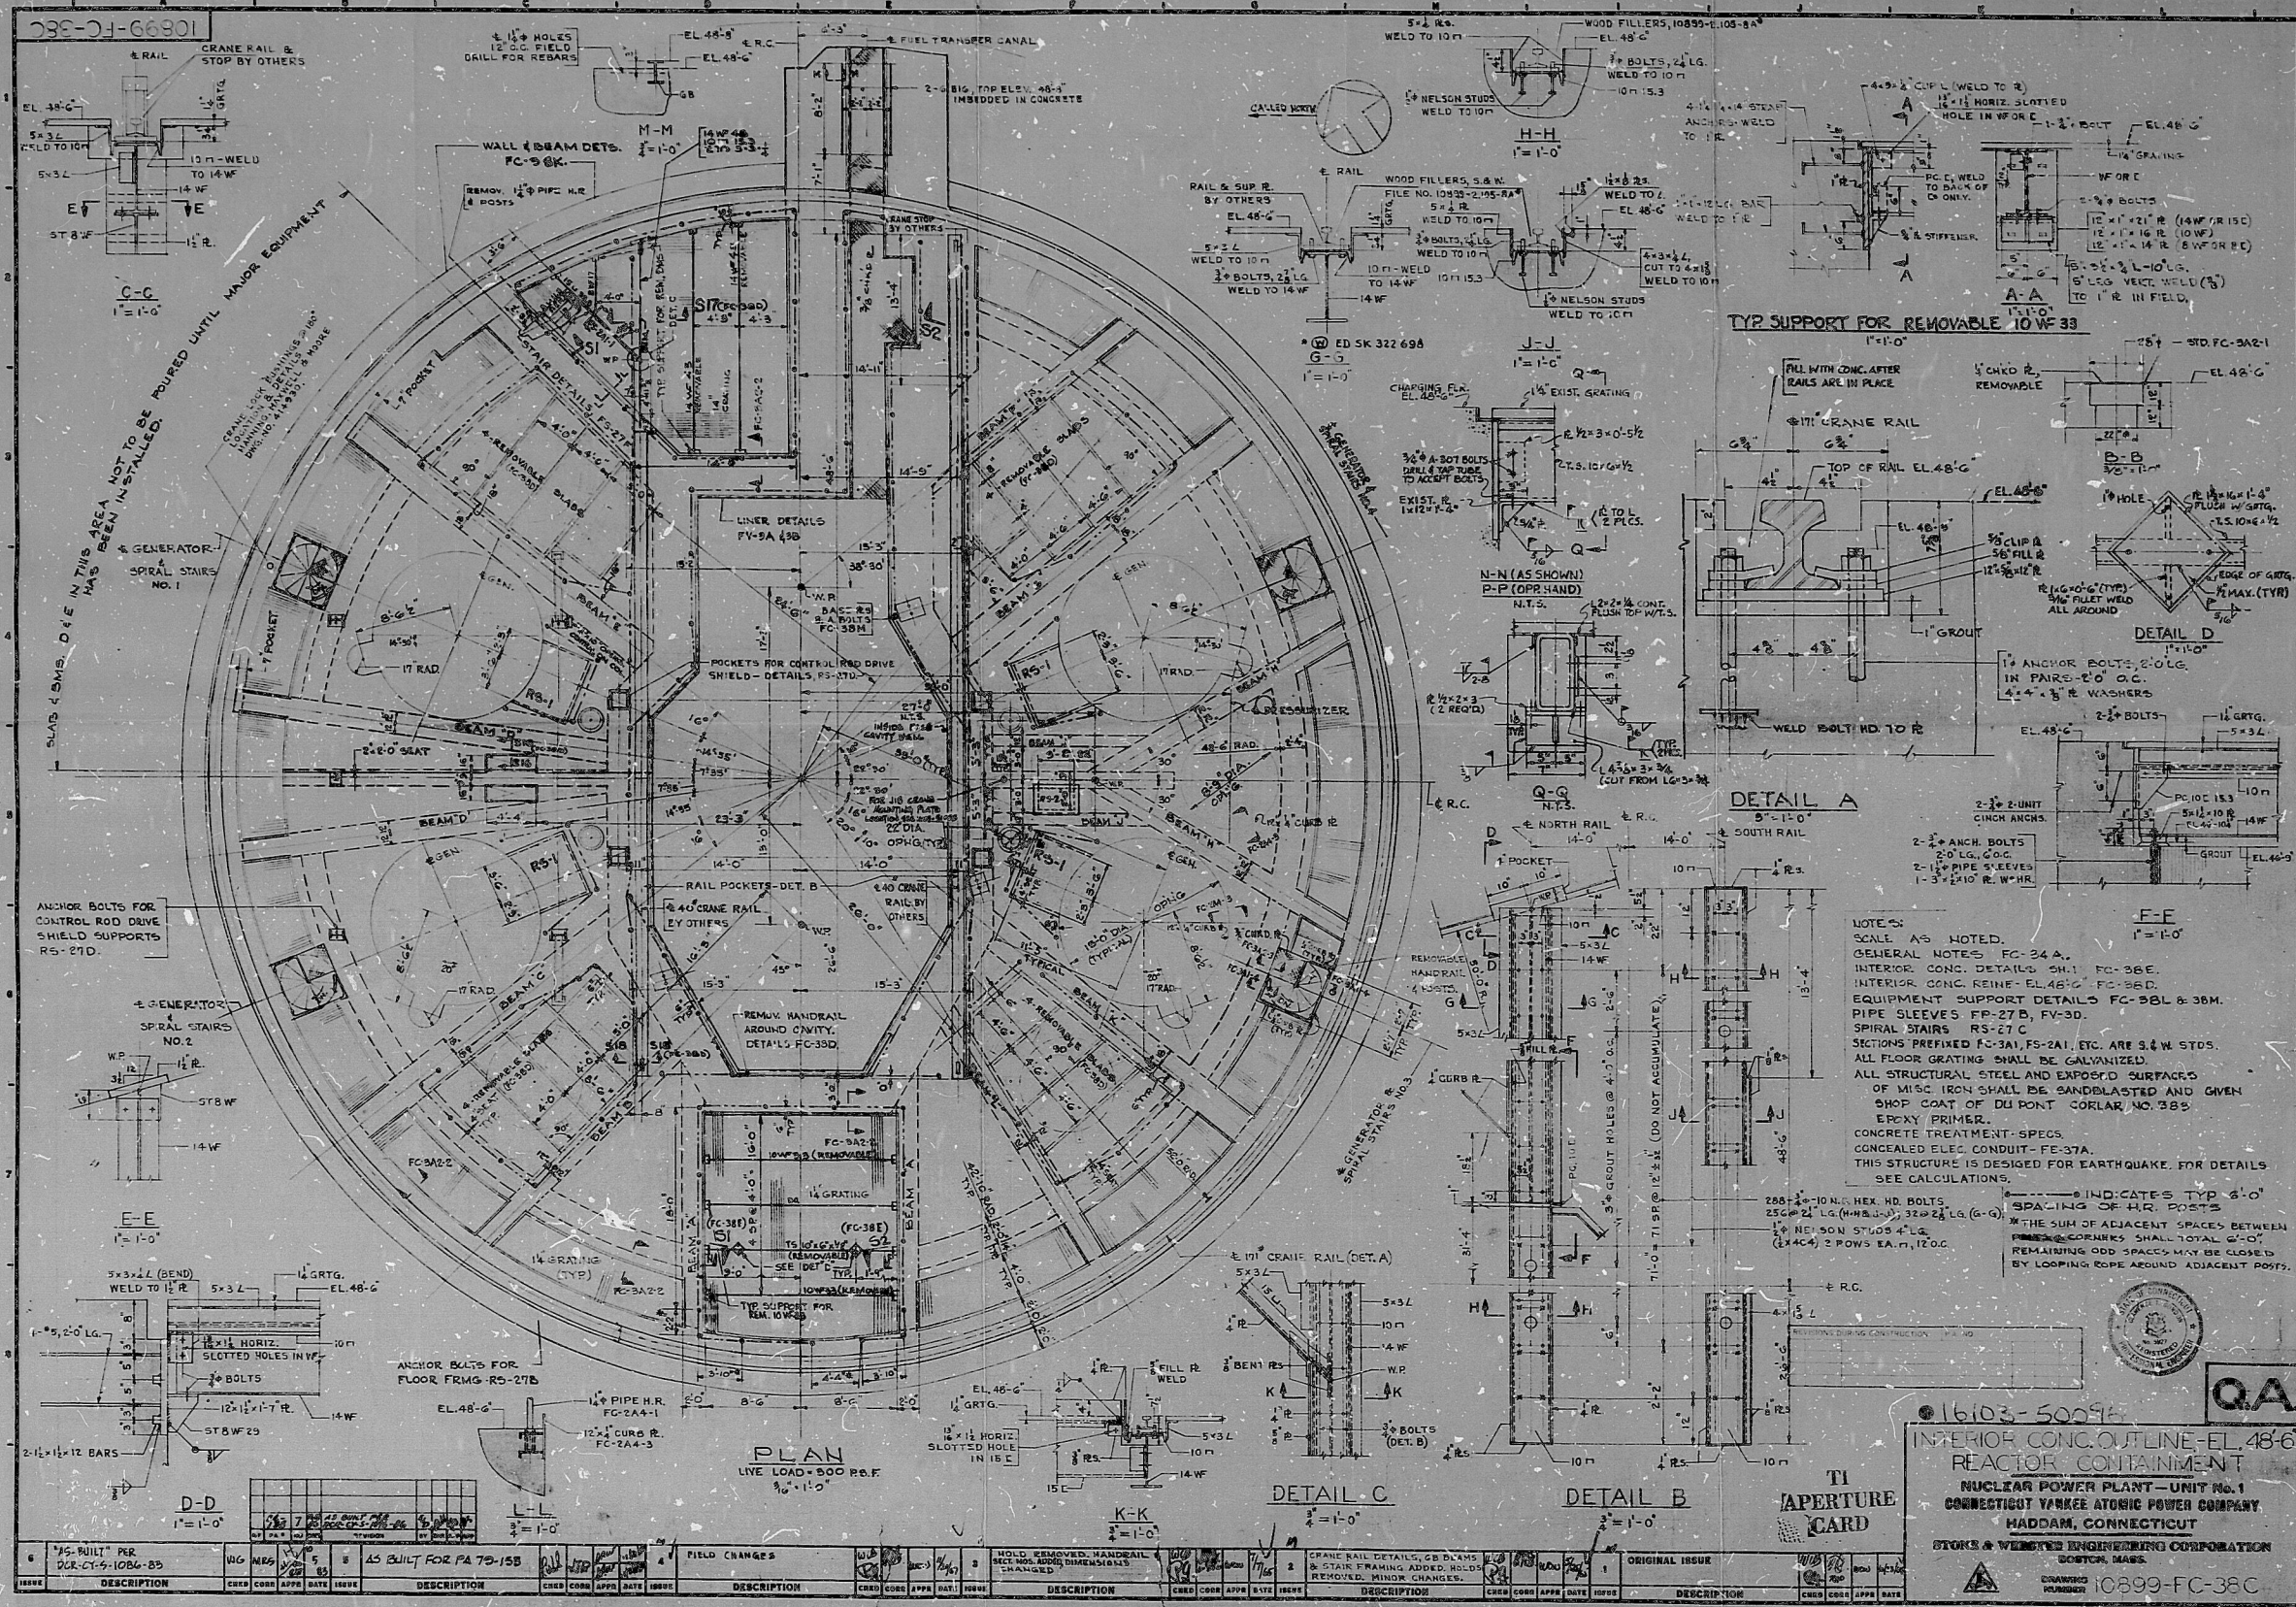

8806/302451

PDR RIDS

8806130242

