
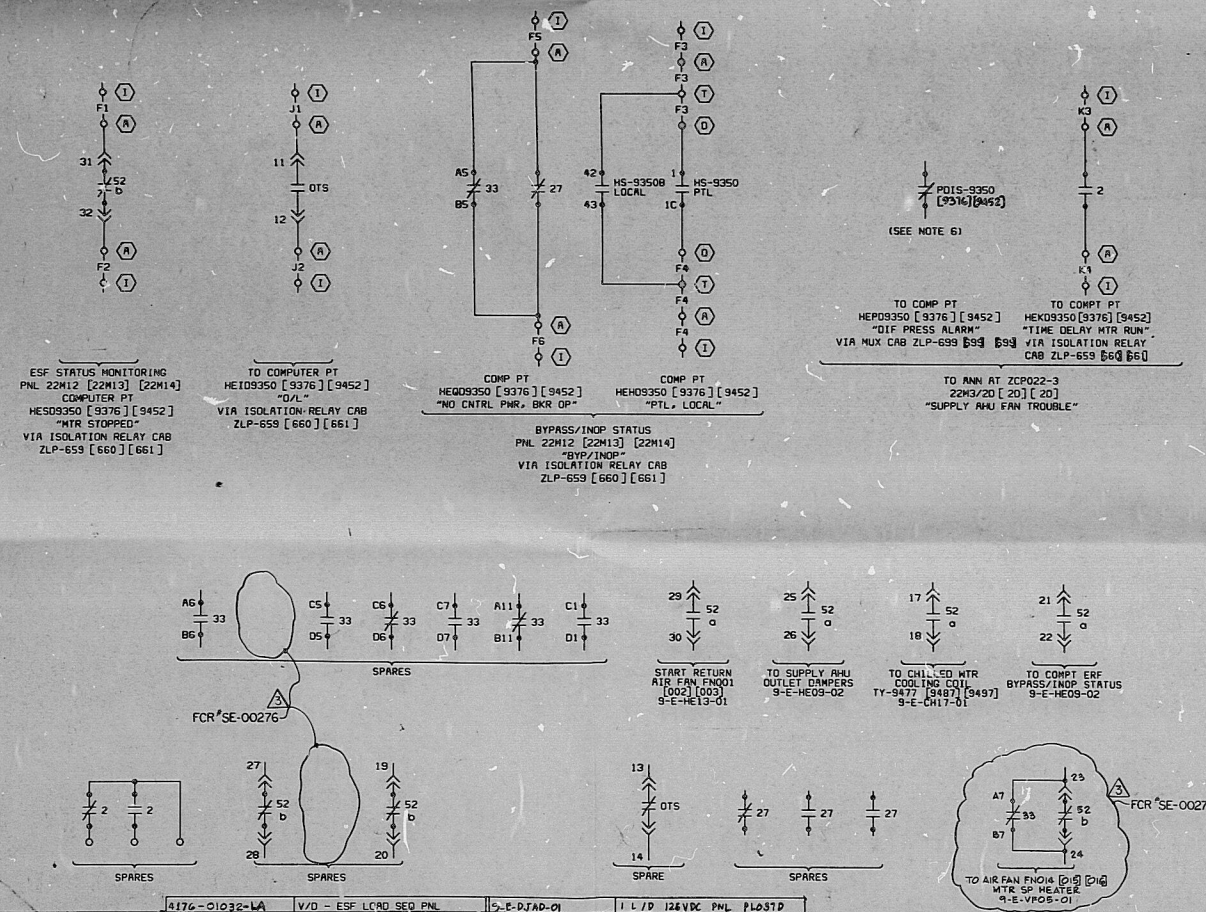
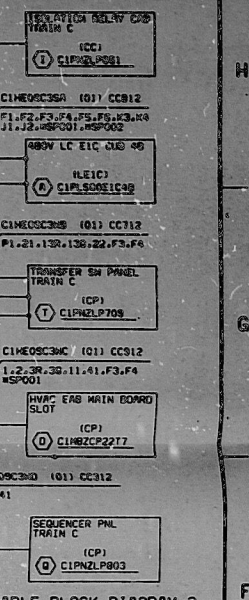
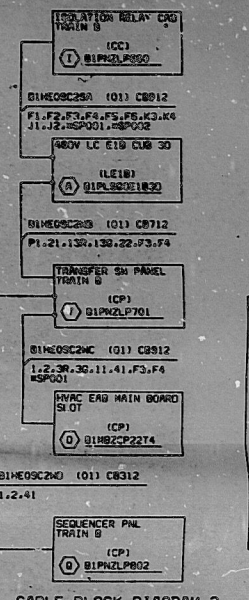
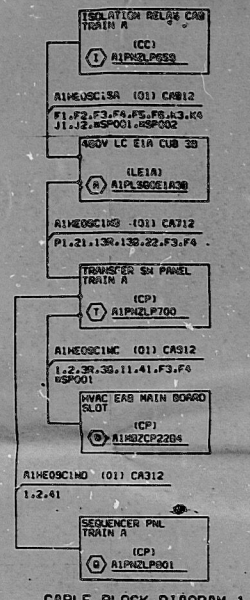


THIS DRAWING AND THE DESIGN IT COVERS ARE THE PROPERTY OF BECHTEL. THEY ARE HEREBY LOANED AND ON THE BORROWER'S EXPRESS AGREEMENT THAT THEY WILL NOT BE REPRODUCED, COPIED, LOANED, EXHIBITED, OR USED EXCEPT IN THE LIMITED MANNER AND PRIVATE USE PERMITTED BY THE LENDER TO THE BORROWER.

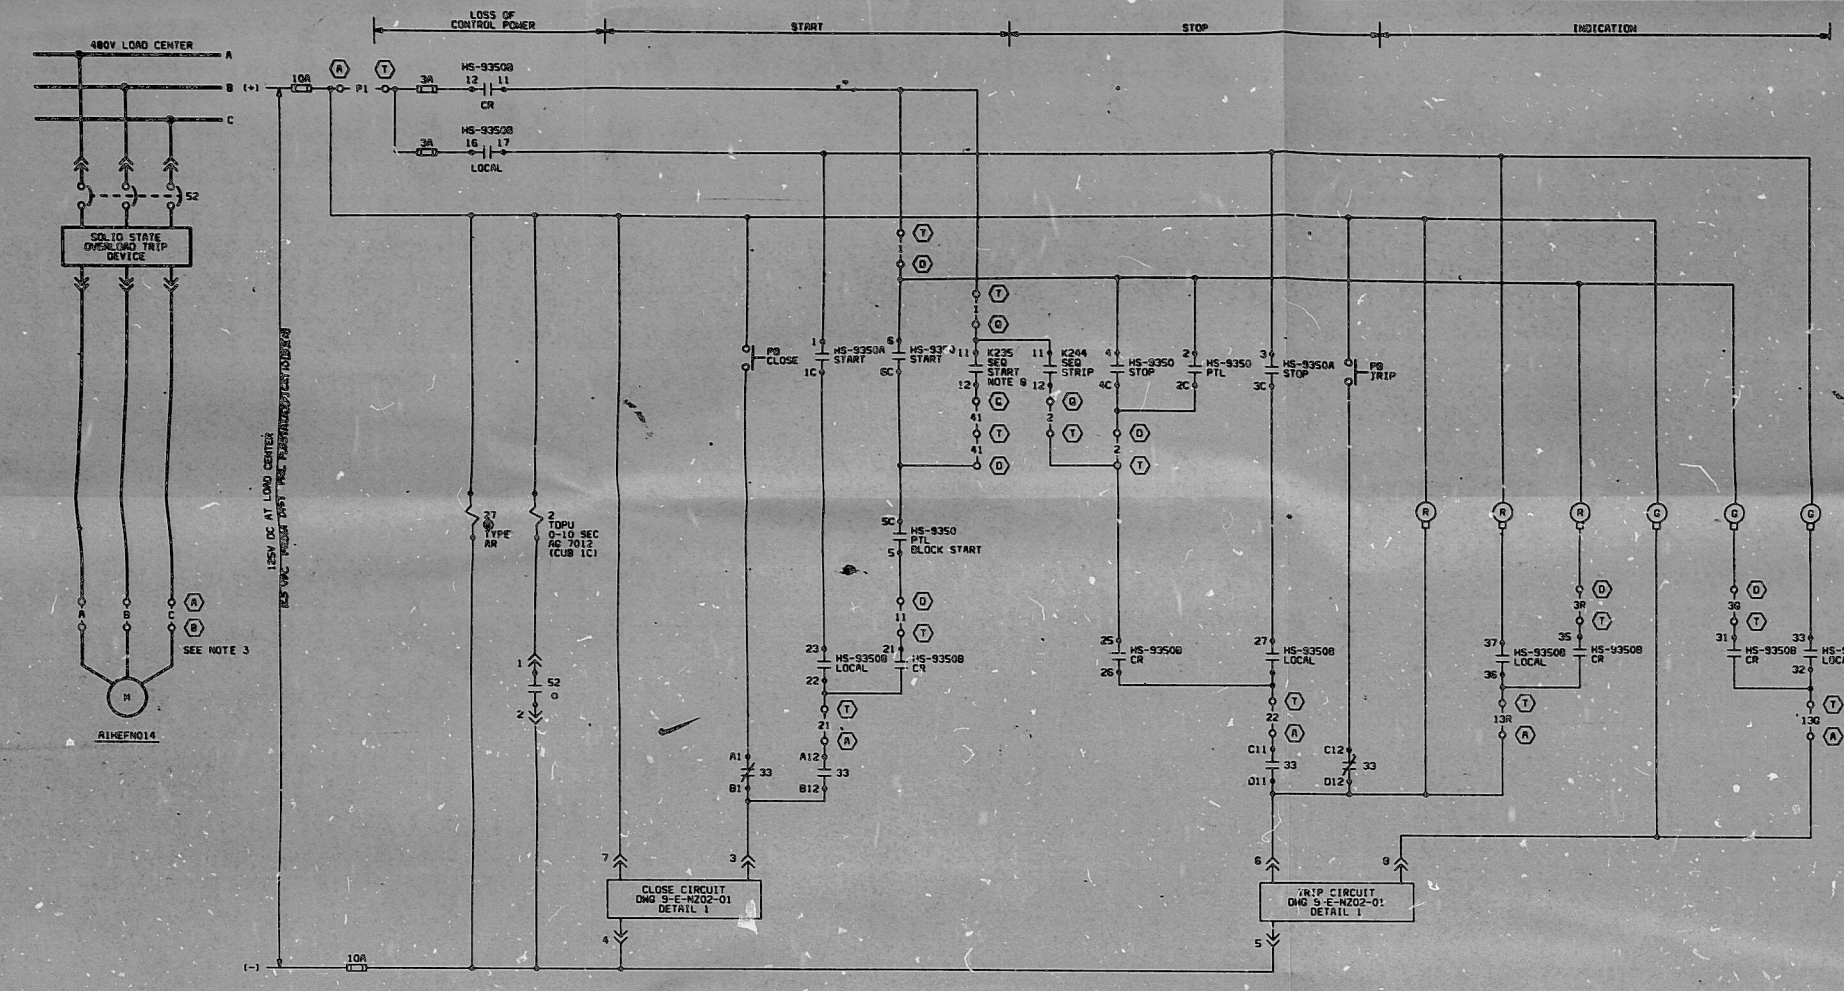

HS-9350 [9376][9452] (CONT. RM)






- NOTES:
- FOR LEGEND AND SYMBOLS REFER TO DRAWINGS 9-E-N201-01 & 9-E-N201-02.
 - O DENOTES LOCATION NUMBER FOR COMPLETE LOCATION NUMBER REFER TO BLOCK DIAGRAM SHOWN IN THIS DRAWING.
 - CABLE NUMBER FOR POWER CABLE ARE ASSIGNED FROM REFERENCED ONE LINE DRAWING.
 - THIS Dwg SUPERCEDES 647 Dwg NUMBER 4V1115506, 4V1115507, 4V1115508, 4V11157406 SH 1 & 2, 4V11157407 SH 1 & 2, & 4V11157408 SH 1 & 2.
 - ELEMENTARY DIAGRAM SHOWN IS FOR AIR SUPPLY FAN FNO14. FANS FNO15 & FNO16 ARE SIMILAR EXCEPT AS SHOWN ON CABLE BLOCK DIAGRAM AND IN BRACKETS [].
 - FOR CABLEING INFORMATION SEE Dwg 9-E-N201-01/02.
 - CONTACT CLOSING ON SEQ MODE 1, 11 OR 111.

REVISION	NO	DATE	REVISION	NO	DATE	REVISION	NO	DATE	REVISION	NO	DATE
NUCLEAR SAFETY RELATED		ELEMENTARY DIAGRAM	
BECHTEL ENERGY CORPORATION HOUSTON, TEXAS		E.A.B. HVAC MAIN SUPPLY AIR VENT FANS FNO14, FNO15, & FNO16	
HOUSTON LIGHTING & POWER CO. SOUTH TEXAS PROJECT		APERTURE CARD	

PDR RIDS

8701230081

