




ANSTEC
 APERTURE
 CARD

PDR RIDS

9601040173

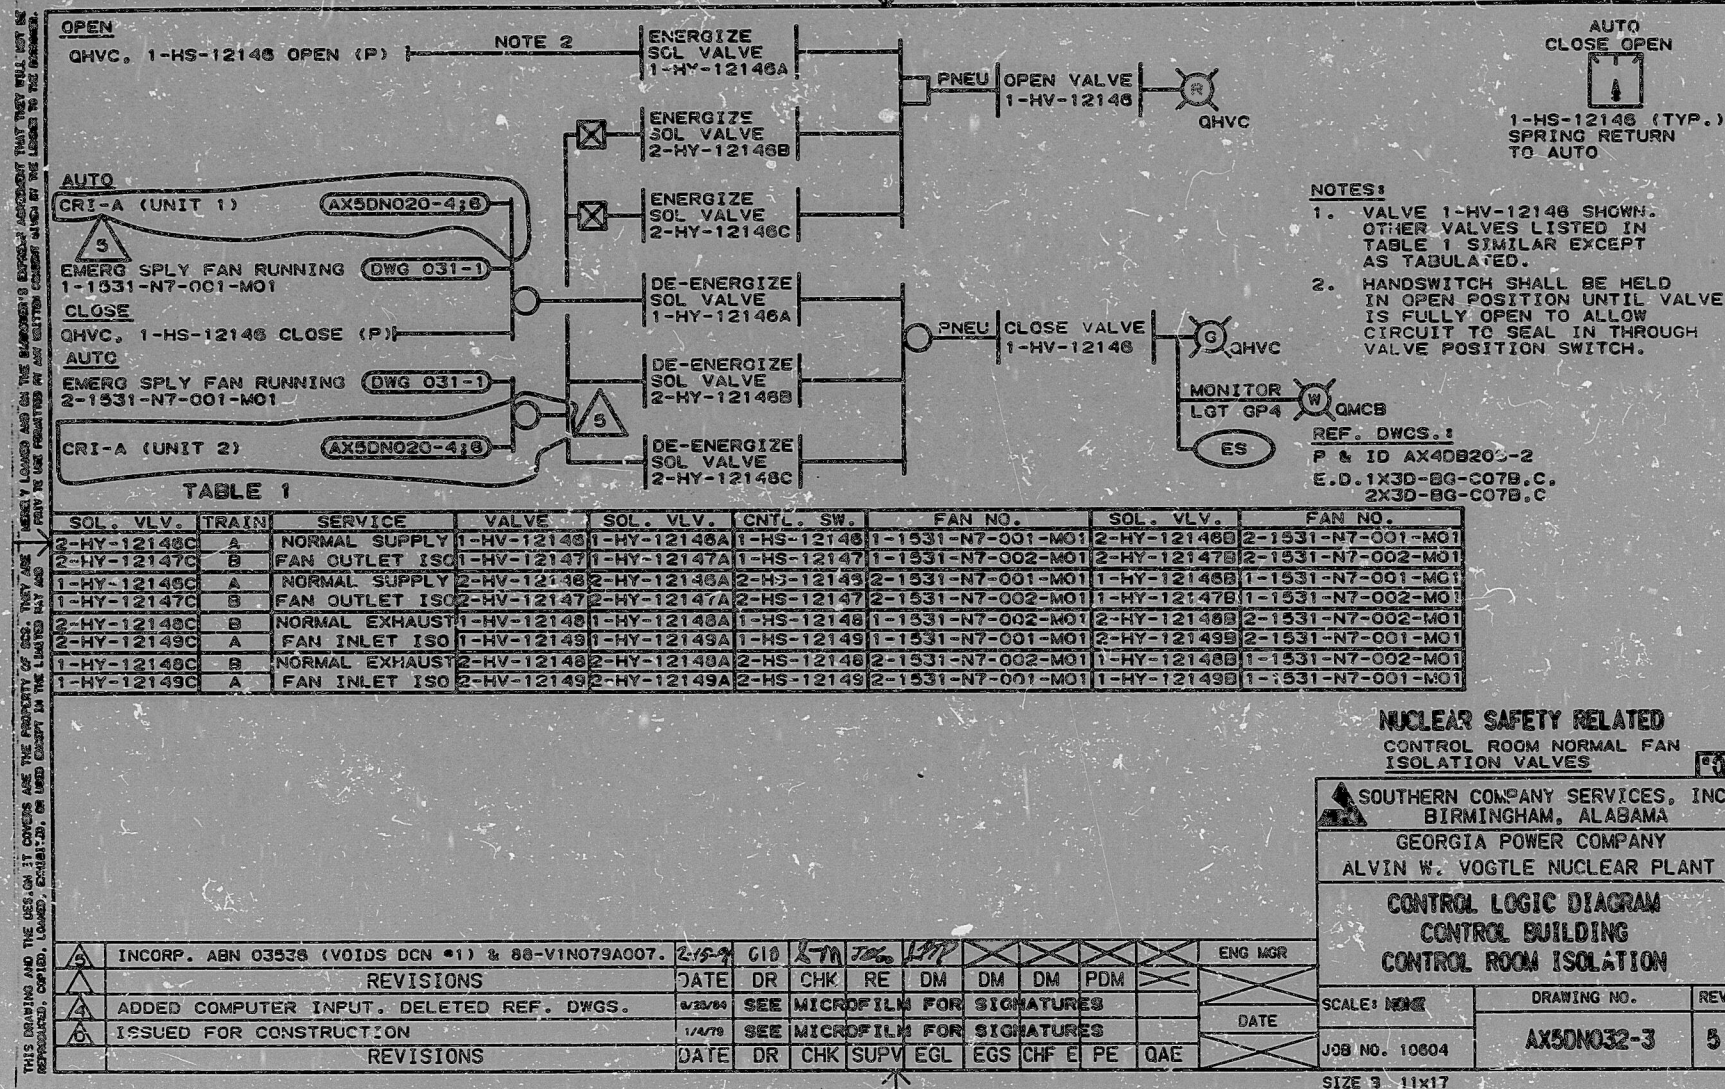