


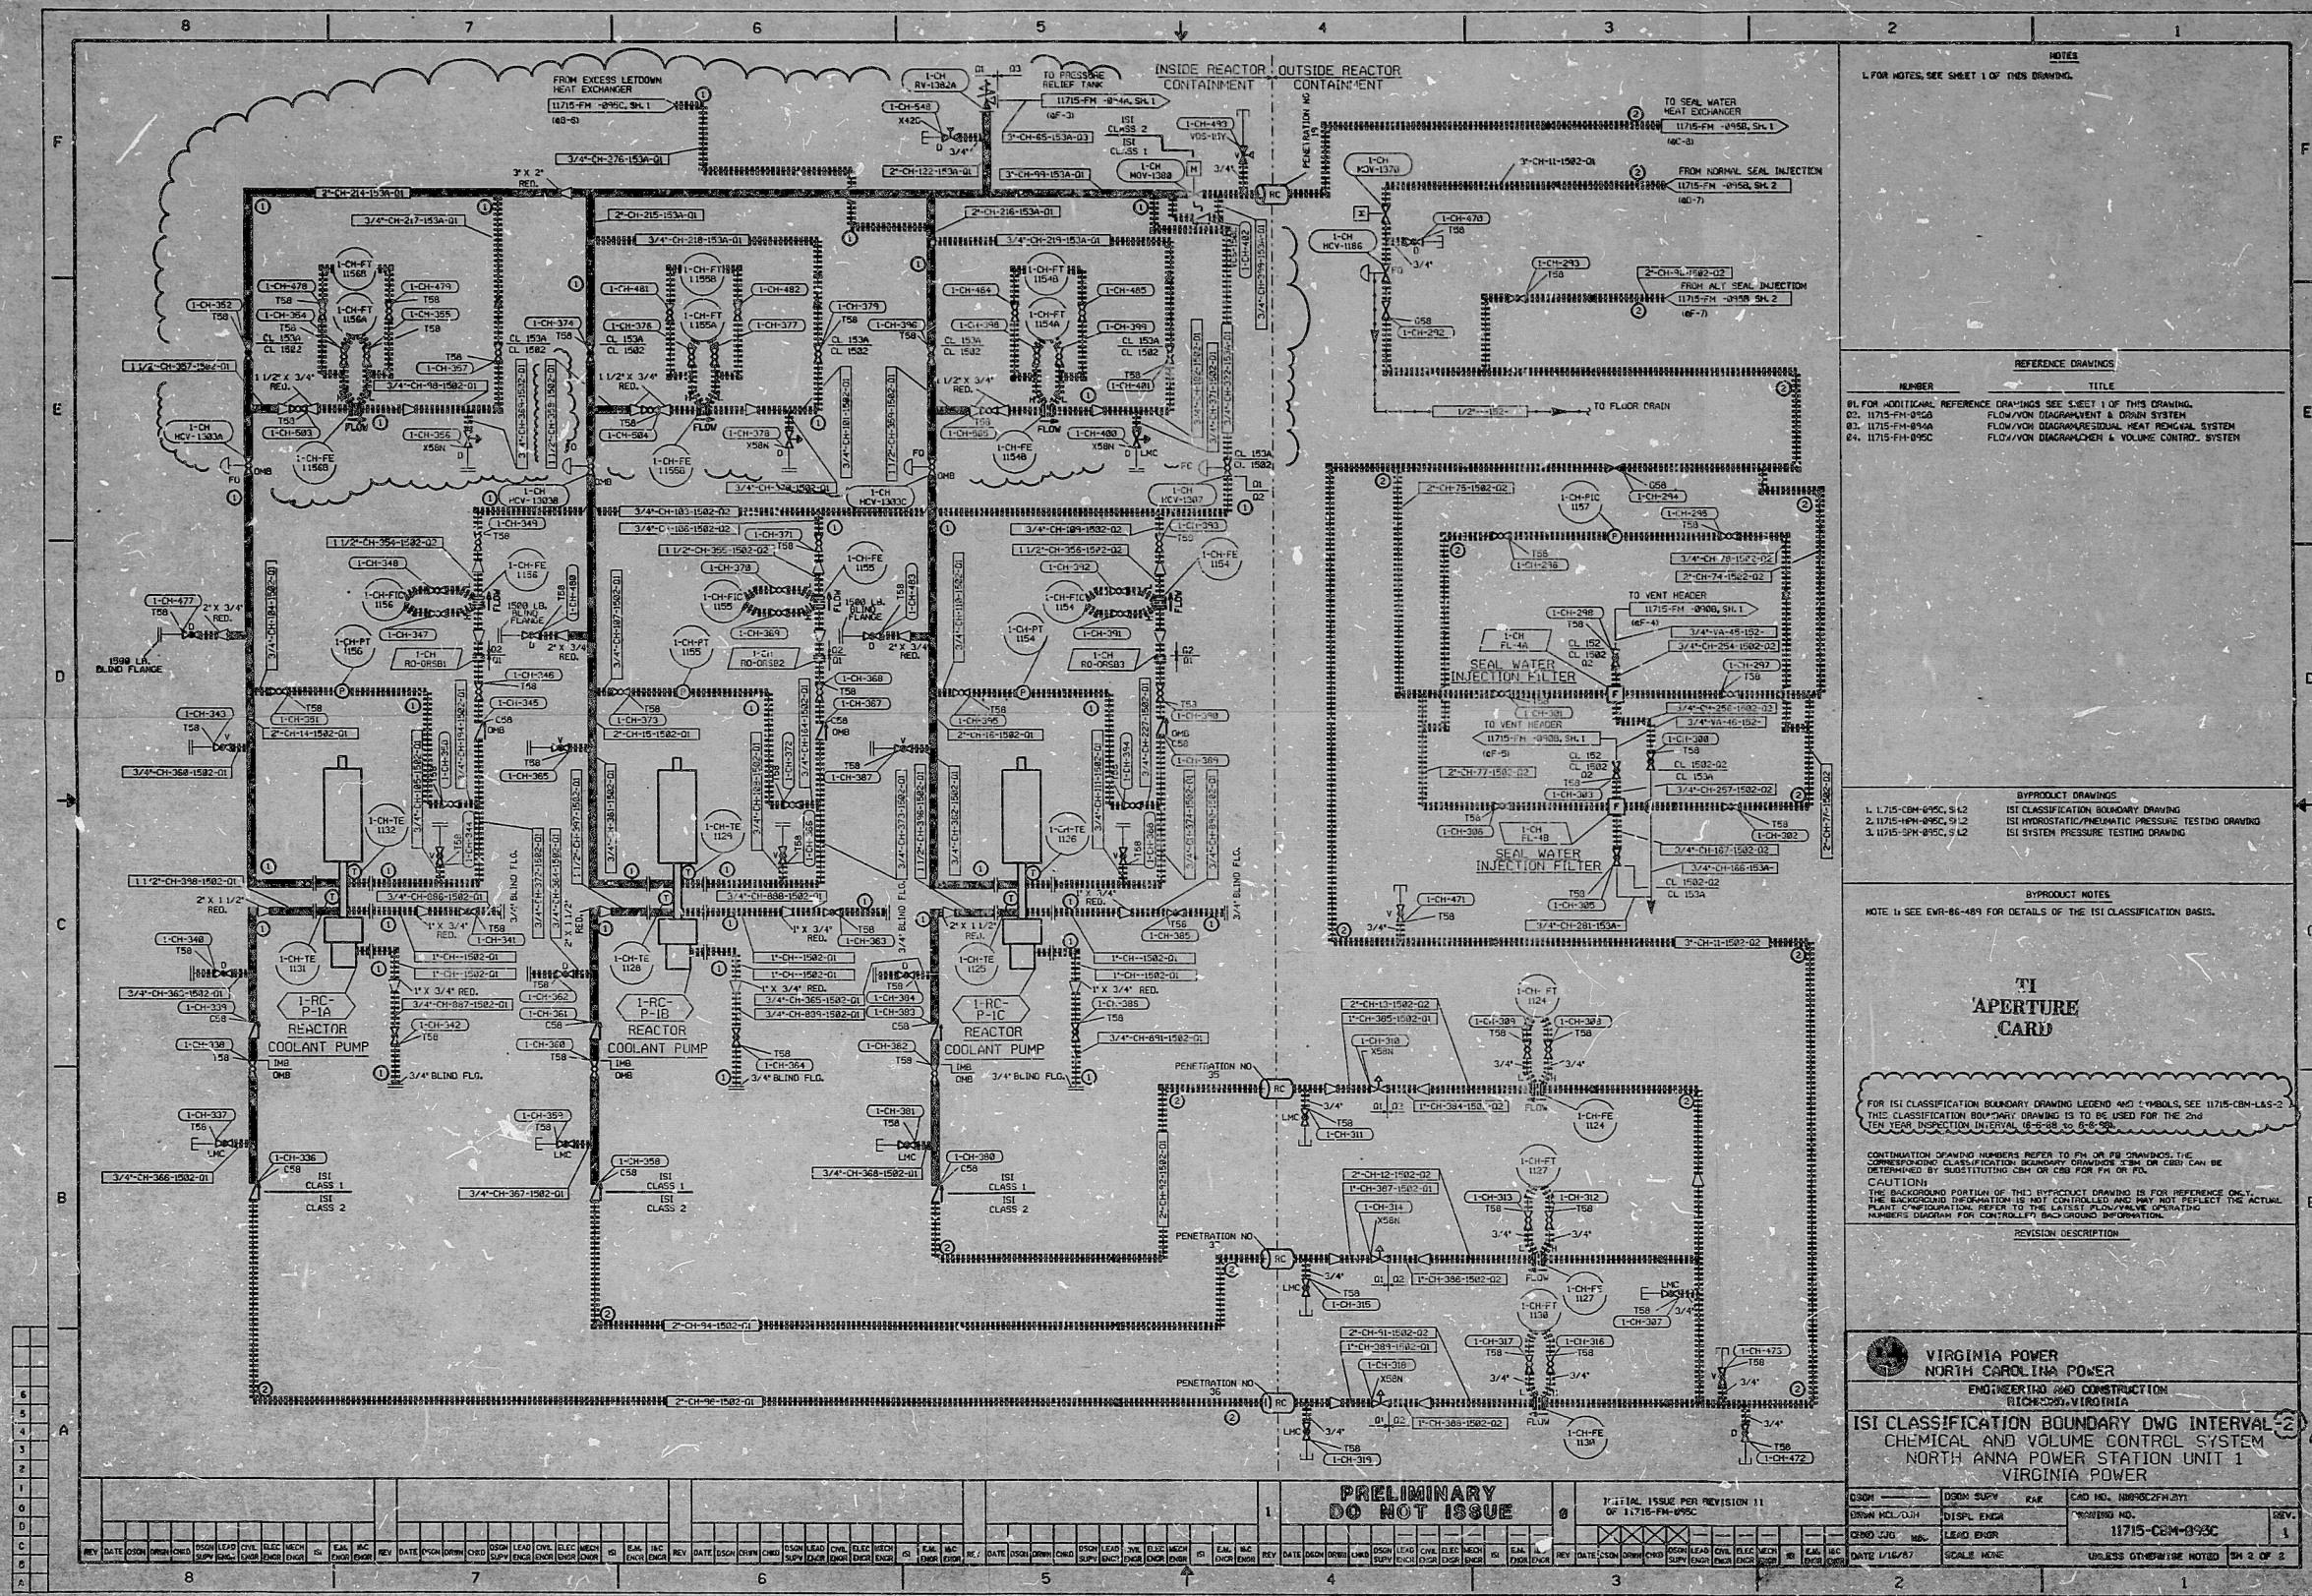

8806170246

PDR RIDS

