

1.60-21










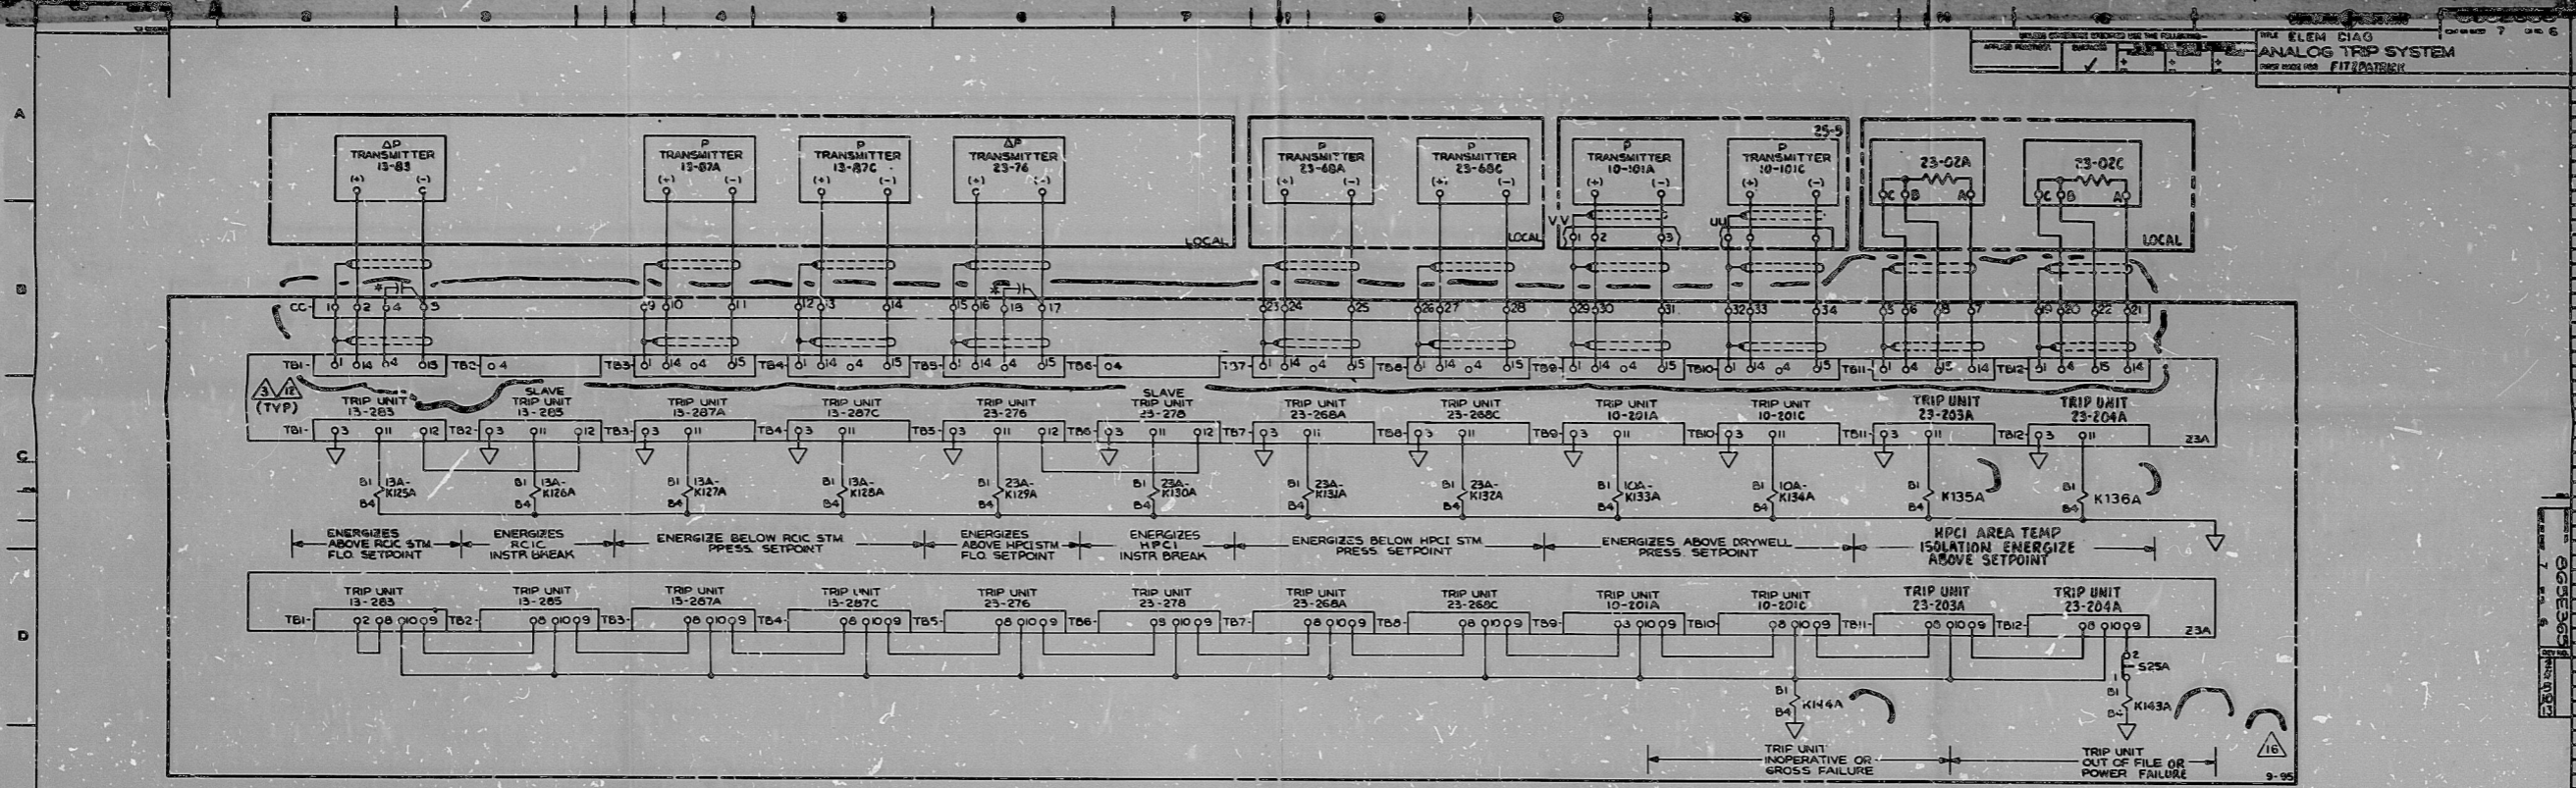

ECCS CHANNEL A/C DIV. I

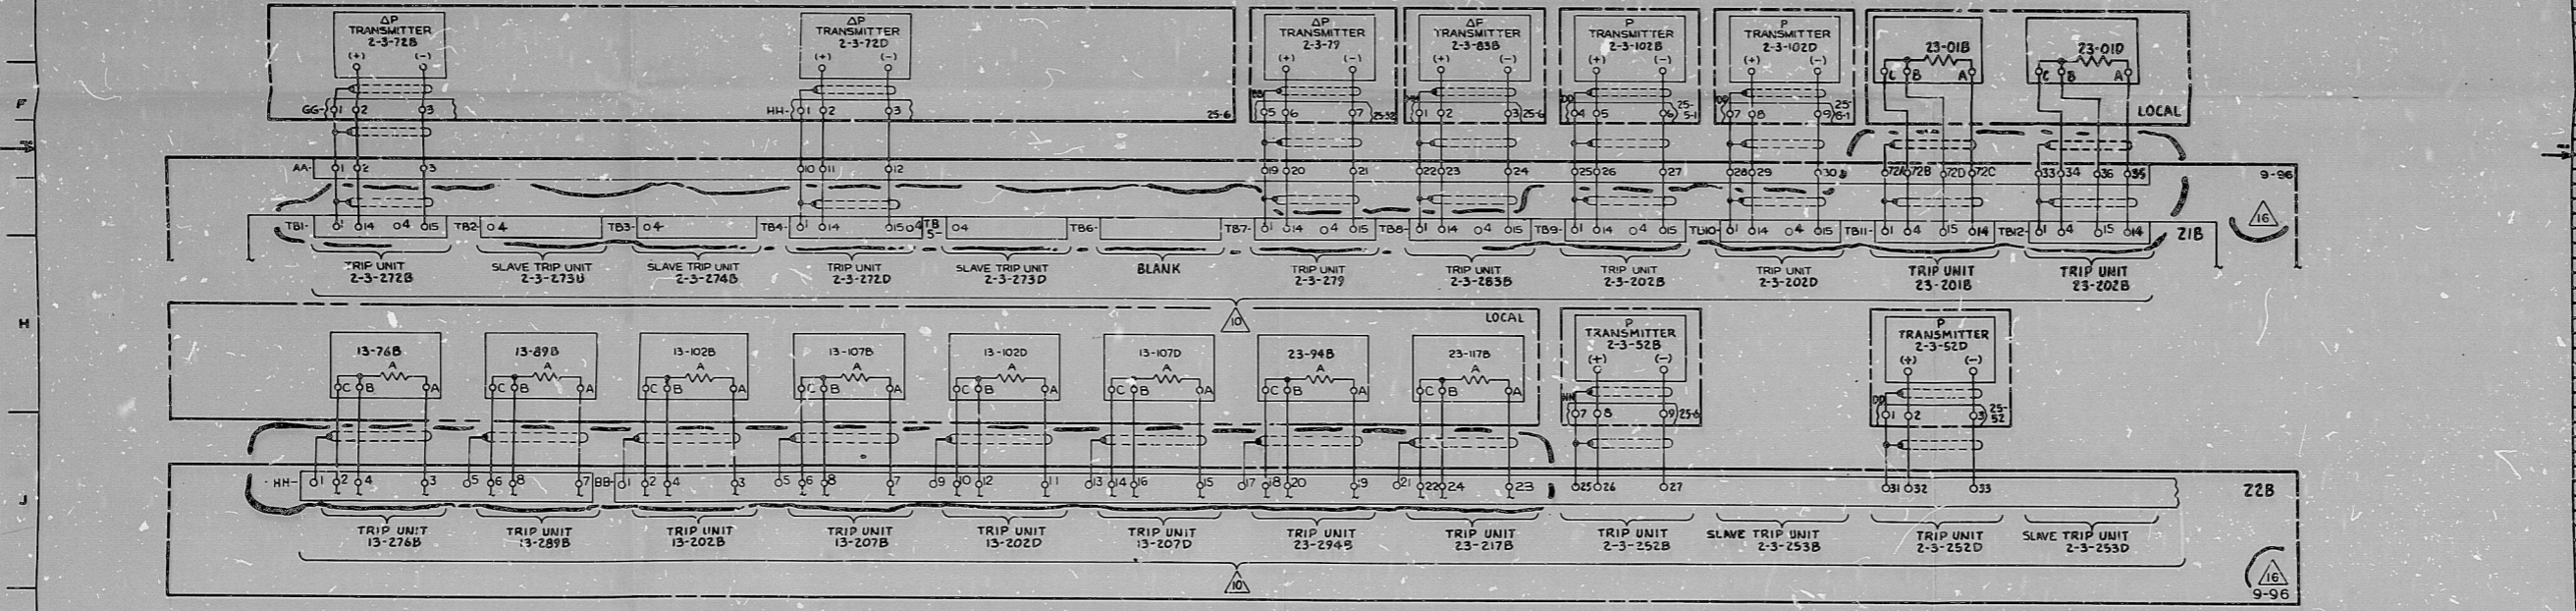

ECCS CHANNEL B/D DIV. II

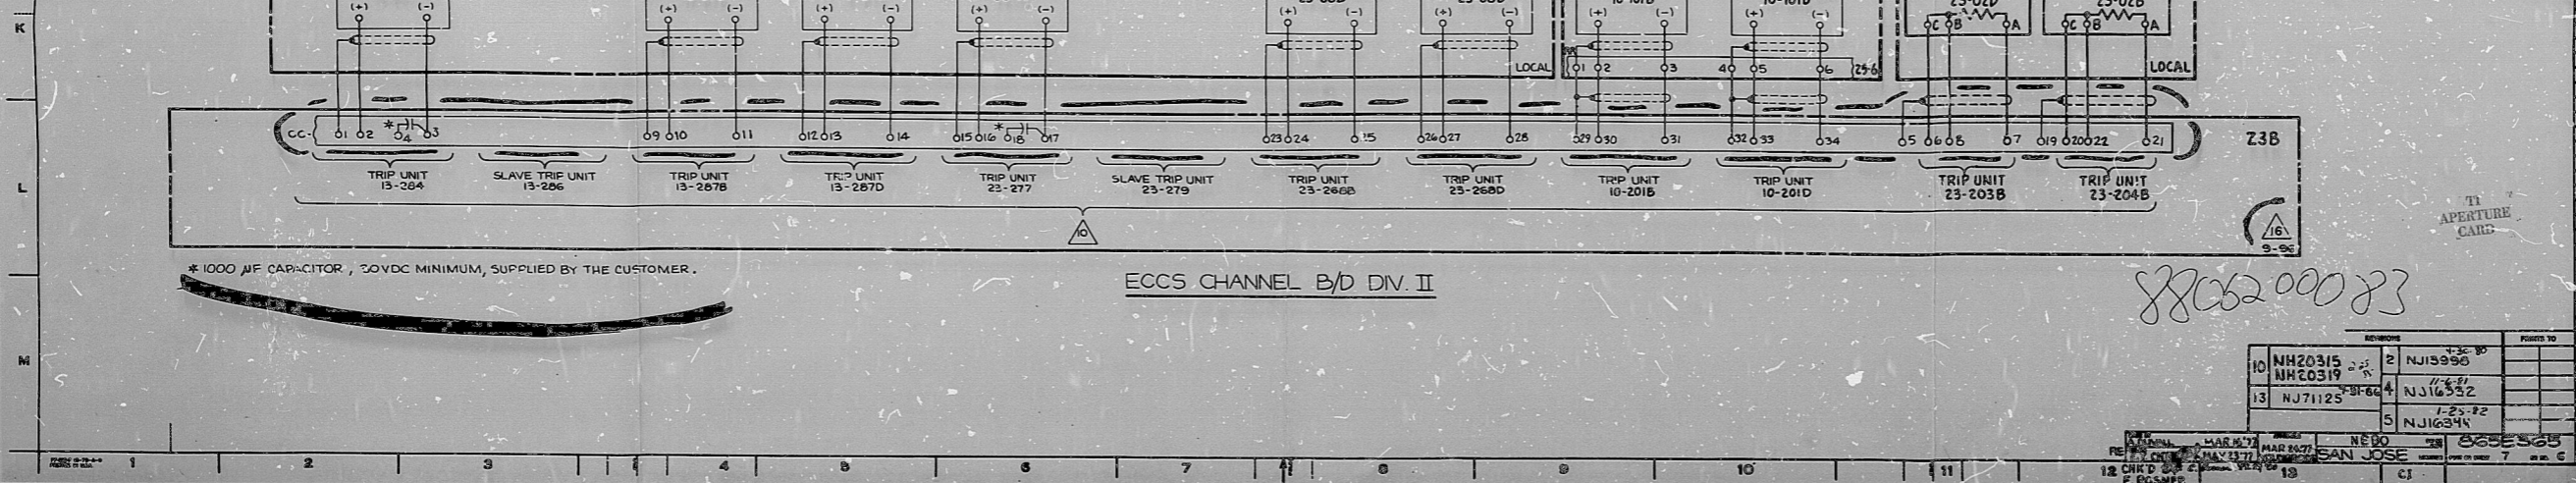

* 1000 µF CAPACITOR, 20VDC MINIMUM, SUPPLIED BY THE CUSTOMER.

REV.	DESCRIPTION	DATE	BY	CHKD	APPR
10	NH20315	2-25-80			
11	NH20319	2-25-80			
13	NJ71125	3-31-84			
14	NJ16332	1-25-82			
15	NJ16344	1-25-82			

REV.	DESCRIPTION	DATE	BY	CHKD	APPR
1	REVISION BY NYPA				
2	JAMES A FITZPATRICK NUCLEAR POWER PLANT POWER AUTHORITY OF THE STATE OF NEW YORK				
3	TITLE: ELEM DIAG ANALOG TRIP SYS ATTS				
4	COMPONENT I.D. NO: PANELS 09-91 THRU - 96				
5	VEHICLE: G.E.				
6	VERSION: 865E365 SHG				
7	FILE NO: 11828 1.60-21				

8806200083

PDR RIDS

8806200083

