

1.60-24








ANALOG TRIP SYSTEM

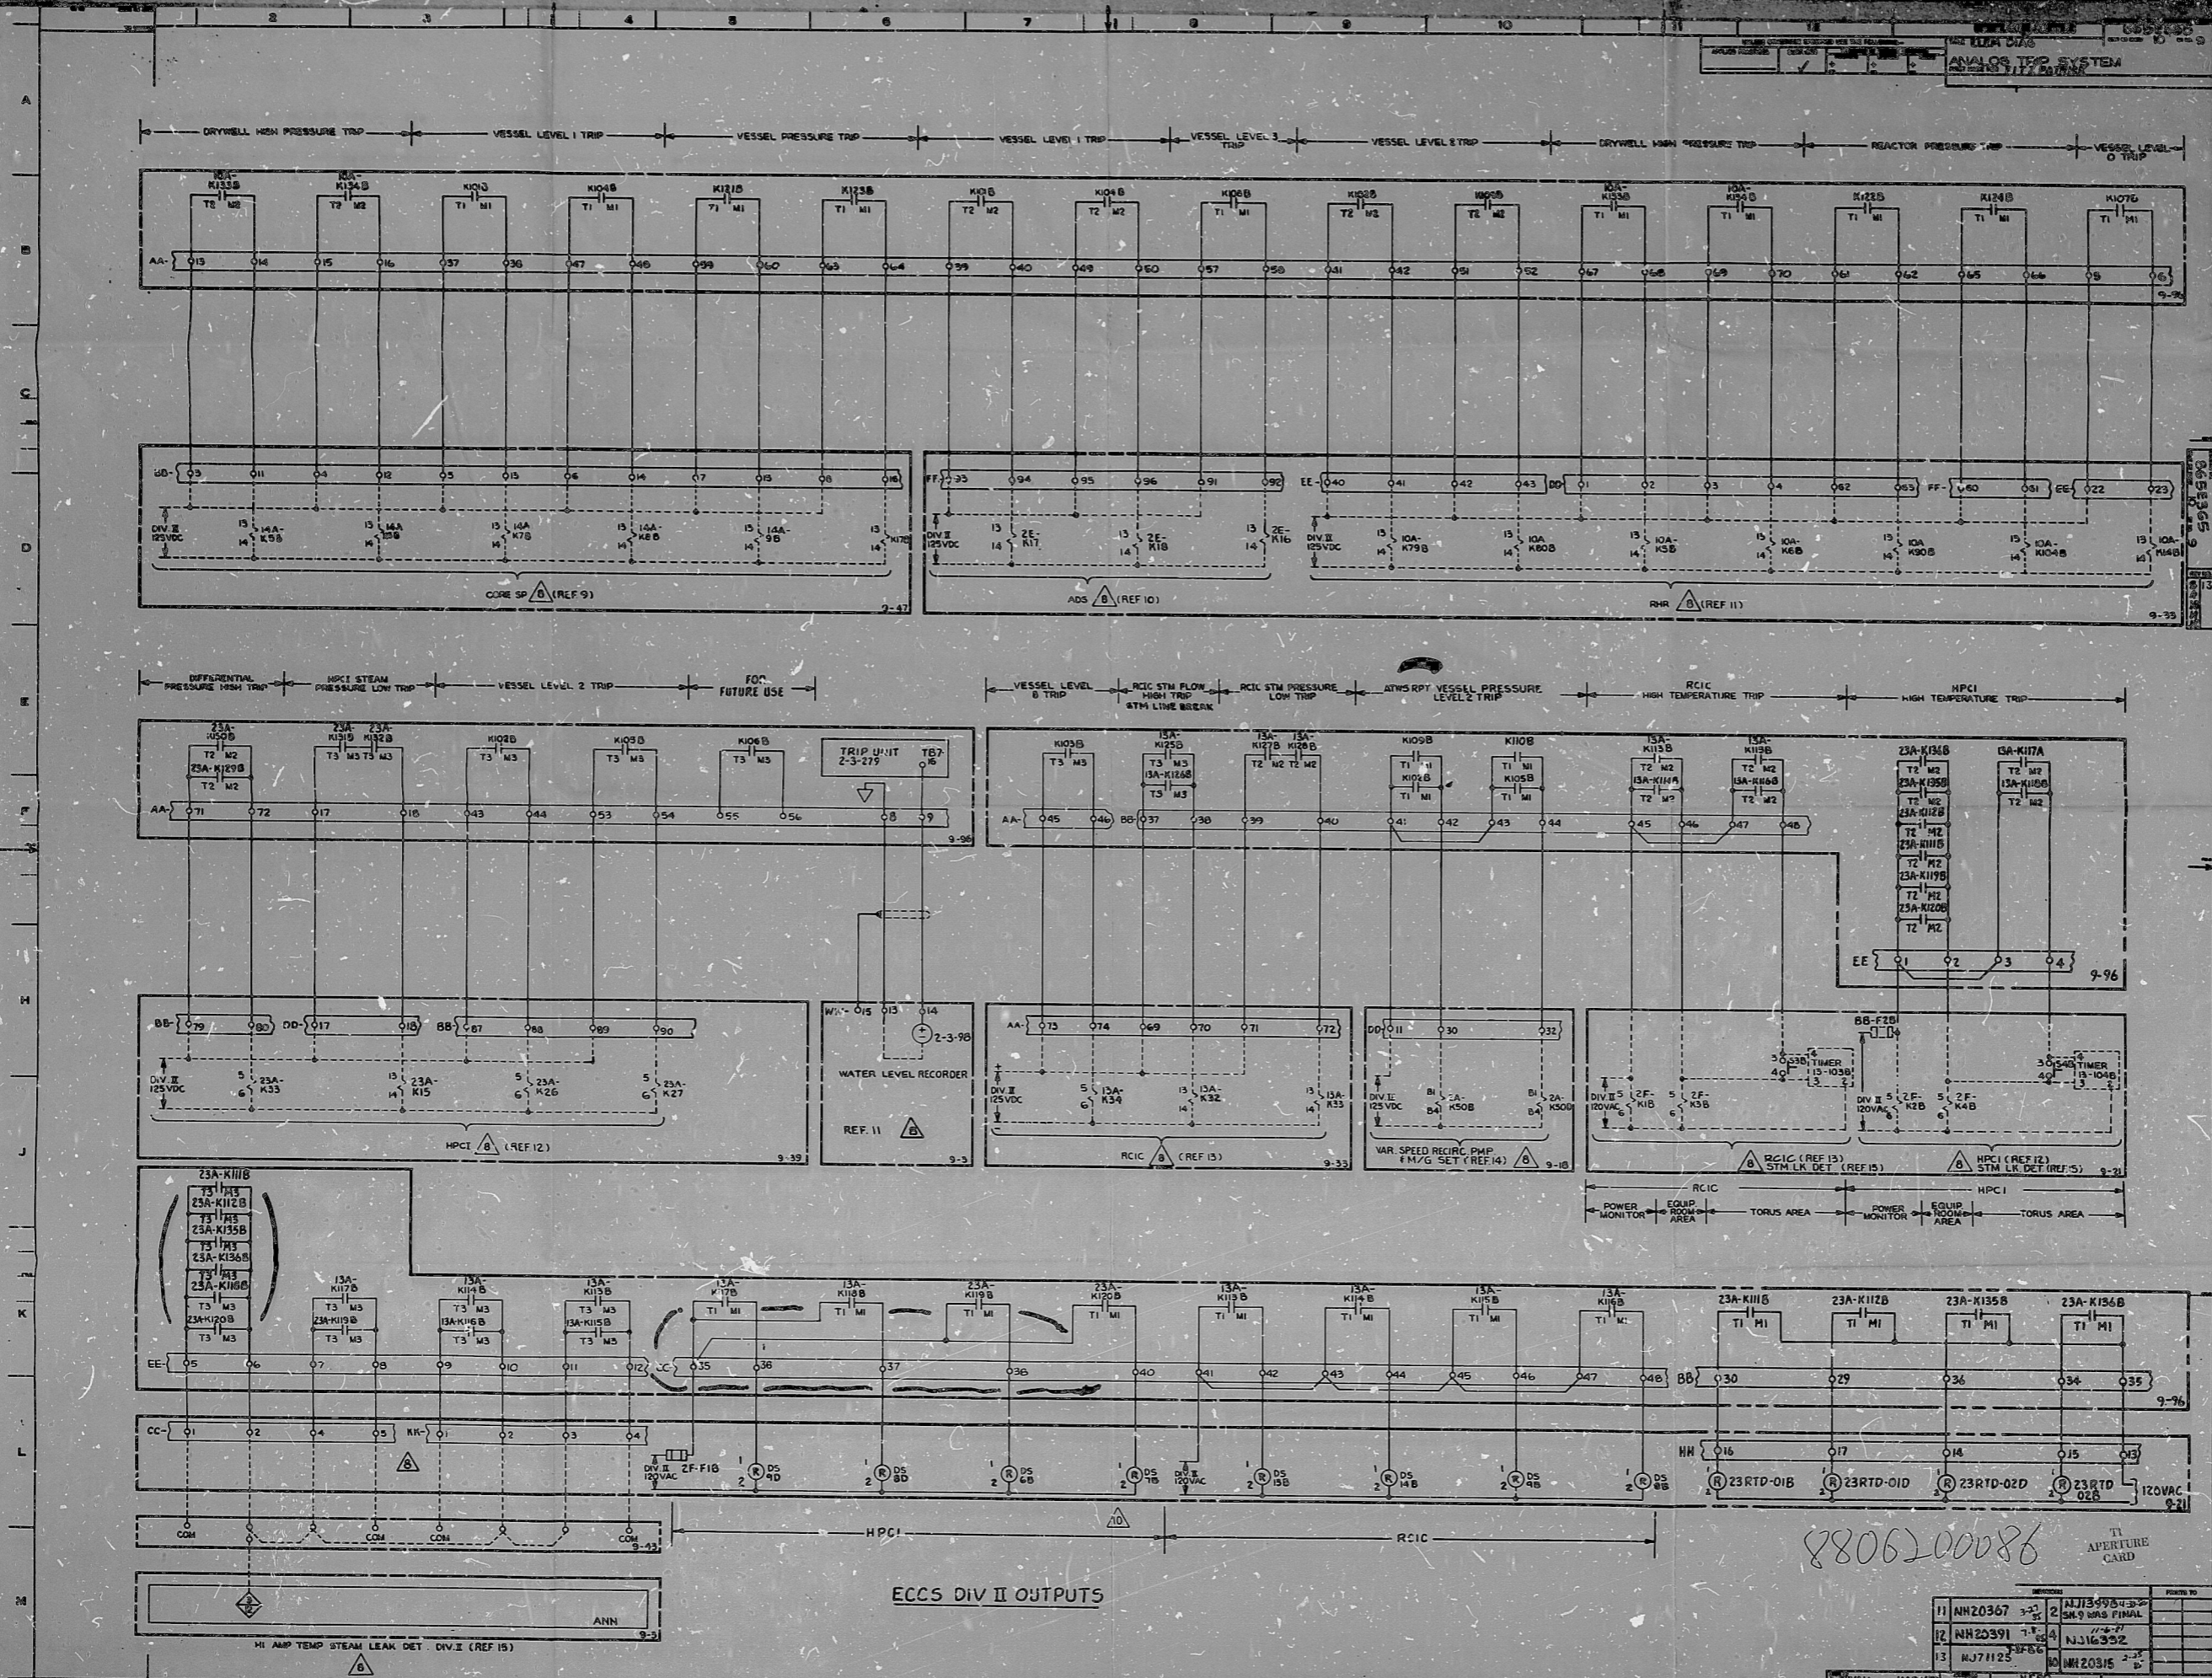

REV.	DESCRIPTION	DATE	BY	CHKD.	APP'D.
1	REPLACEMENT REPRODUCIBLE AS-BUILT PER FR-6-C-25				
REVISION BY NYPA					
JAMES A FITZPATRICK NUCLEAR POWER PLANT POWER AUTHORITY OF THE STATE OF NEW YORK					
TITLE: ELEM DIAS ANALOG TRIP SYS ATTS					
COMPONENT I.D. NO. PANELS 09-91 THRU 96					
VERSION: G.F.					
REVISION NO. 885E365 SH2					
FILE NO. 11889 1.60-24					

8806200086

8806200086

REV.	DESCRIPTION	DATE	BY	CHKD.	APP'D.
11	NH20367	3-78	NJ3398		
12	NH20391	7-78	NJ16332		
13	NJ71125	8-86	NH20315		

POWER TO: C1

PDR RIDS

8806200086

