

DRAWING
PLAN HOLD CORPORATION
REVISION BY

DRAWING NUMBER
PLAN HOLD CORPORATION
REVISION BY



DRAWING NUMBER
PLAN HOLD CORPORATION
REVISION BY

DRAWING NUMBER
PLAN HOLD CORPORATION
REVISION BY

DRAWING
PLAN HOLD CORPORATION
REVISION BY

9E-PN04-02

THIS DRAWING AND THE DESIGN IT COVERS ARE THE PROPERTY OF BECHTEL. THEY ARE MERELY LOANED AND ON THE BORROWER'S EXPRESS AGREEMENT THAT THEY WILL NOT BE REPRODUCED, COPIED, OR IN ANY MANNER USED EXCEPT IN THE LIMITED WAY AND PRIVATE USE PERMITTED BY ANY WRITTEN CONSENT GIVEN BY THE LENDER TO THE BORROWER.

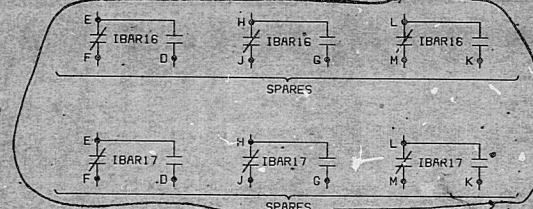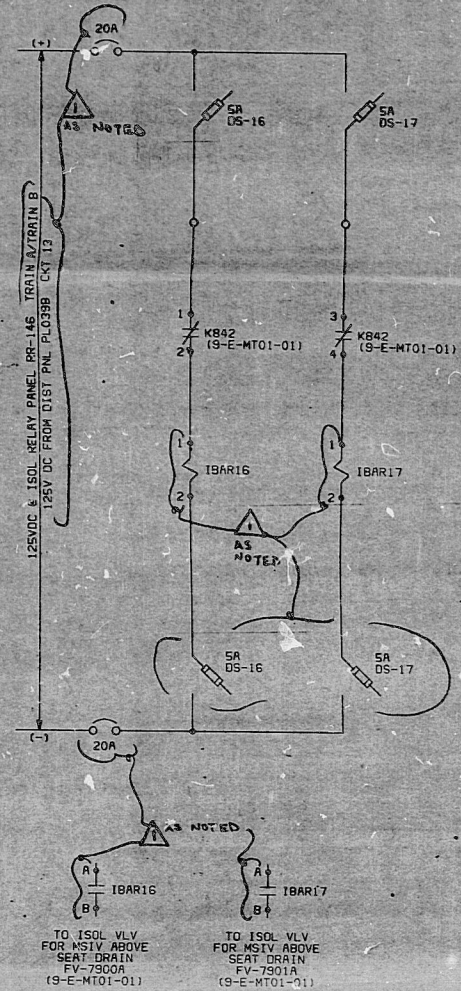

HL&P	NO	SIGNATURE	DWG NO	REFERENCE	DWG NO	REFERENCE	NO	DATE	REVISION	RE	CHK	CL	EGS	PE	NO	DATE	REVISION	RE	CHK	CL	EGS	PE
CHIEF ENGINEER	1	N/A			9-E-DJAE-01										1	5/1/83	REVISED AS SHOWN					
	0	N/A			NONE										0	3/2/83	ISSUED FOR CONST					

BECHTEL ENERGY CORPORATION
HOUSTON, TEXAS

HOUSTON LIGHTING & POWER CO.
SOUTH TEXAS PROJECT

SCALE	JOB NO	DRAWING NO.	REV
NONE	14926	9-E-PN04-02	1

NOTE:
1. FOR LEGEND AND GENERAL NOTES
REFER TO DRAWING 9-E-N201-01
AND 9-E-N201-02

HOUSTON OFFICE ISSUED
INFORMATION ONLY
STP 14926

NUCLEAR SAFETY RELATED
ELEMENTARY DIAGRAM
ISOLATION-RELAY PANE
RR-14B
(TRAIN A/TRAIN B)
APERTURE CARD

NO 8701870513

PDR RID'S

8701270513

