



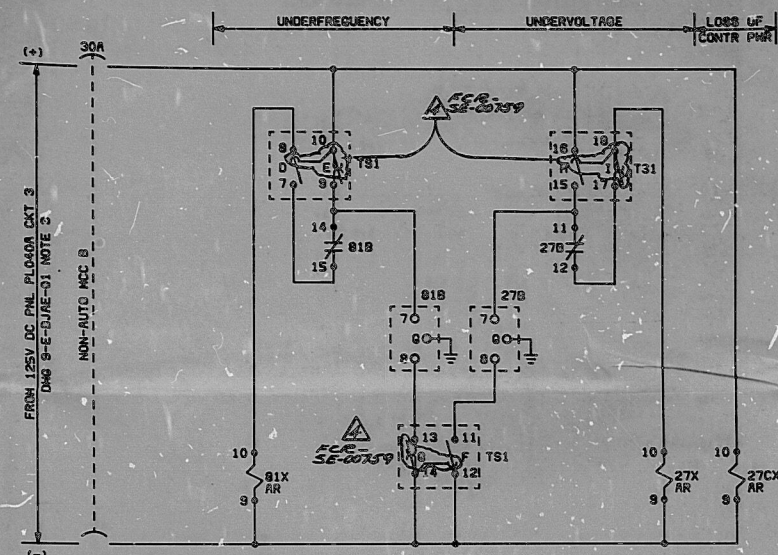

CABLE BLOCK DIAGRAM 6
SCHEME D1RC03C6
CLASS 1E 15KV RCP
CUBICLE 1B
(D1RC90010)

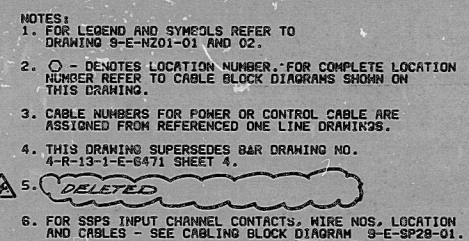

APERTURE
CARD

NUCLEAR SAFETY RELATED

**HOUSTON LIGHTING & POWER CO.
SOUTH TEXAS PROJECT**

SCALE	JOB NO	DRAWING NO.	RE
NOTE	14028	9-E-RC03-03	4

BJ

5741280023

PDR RIDS

8701280023

