


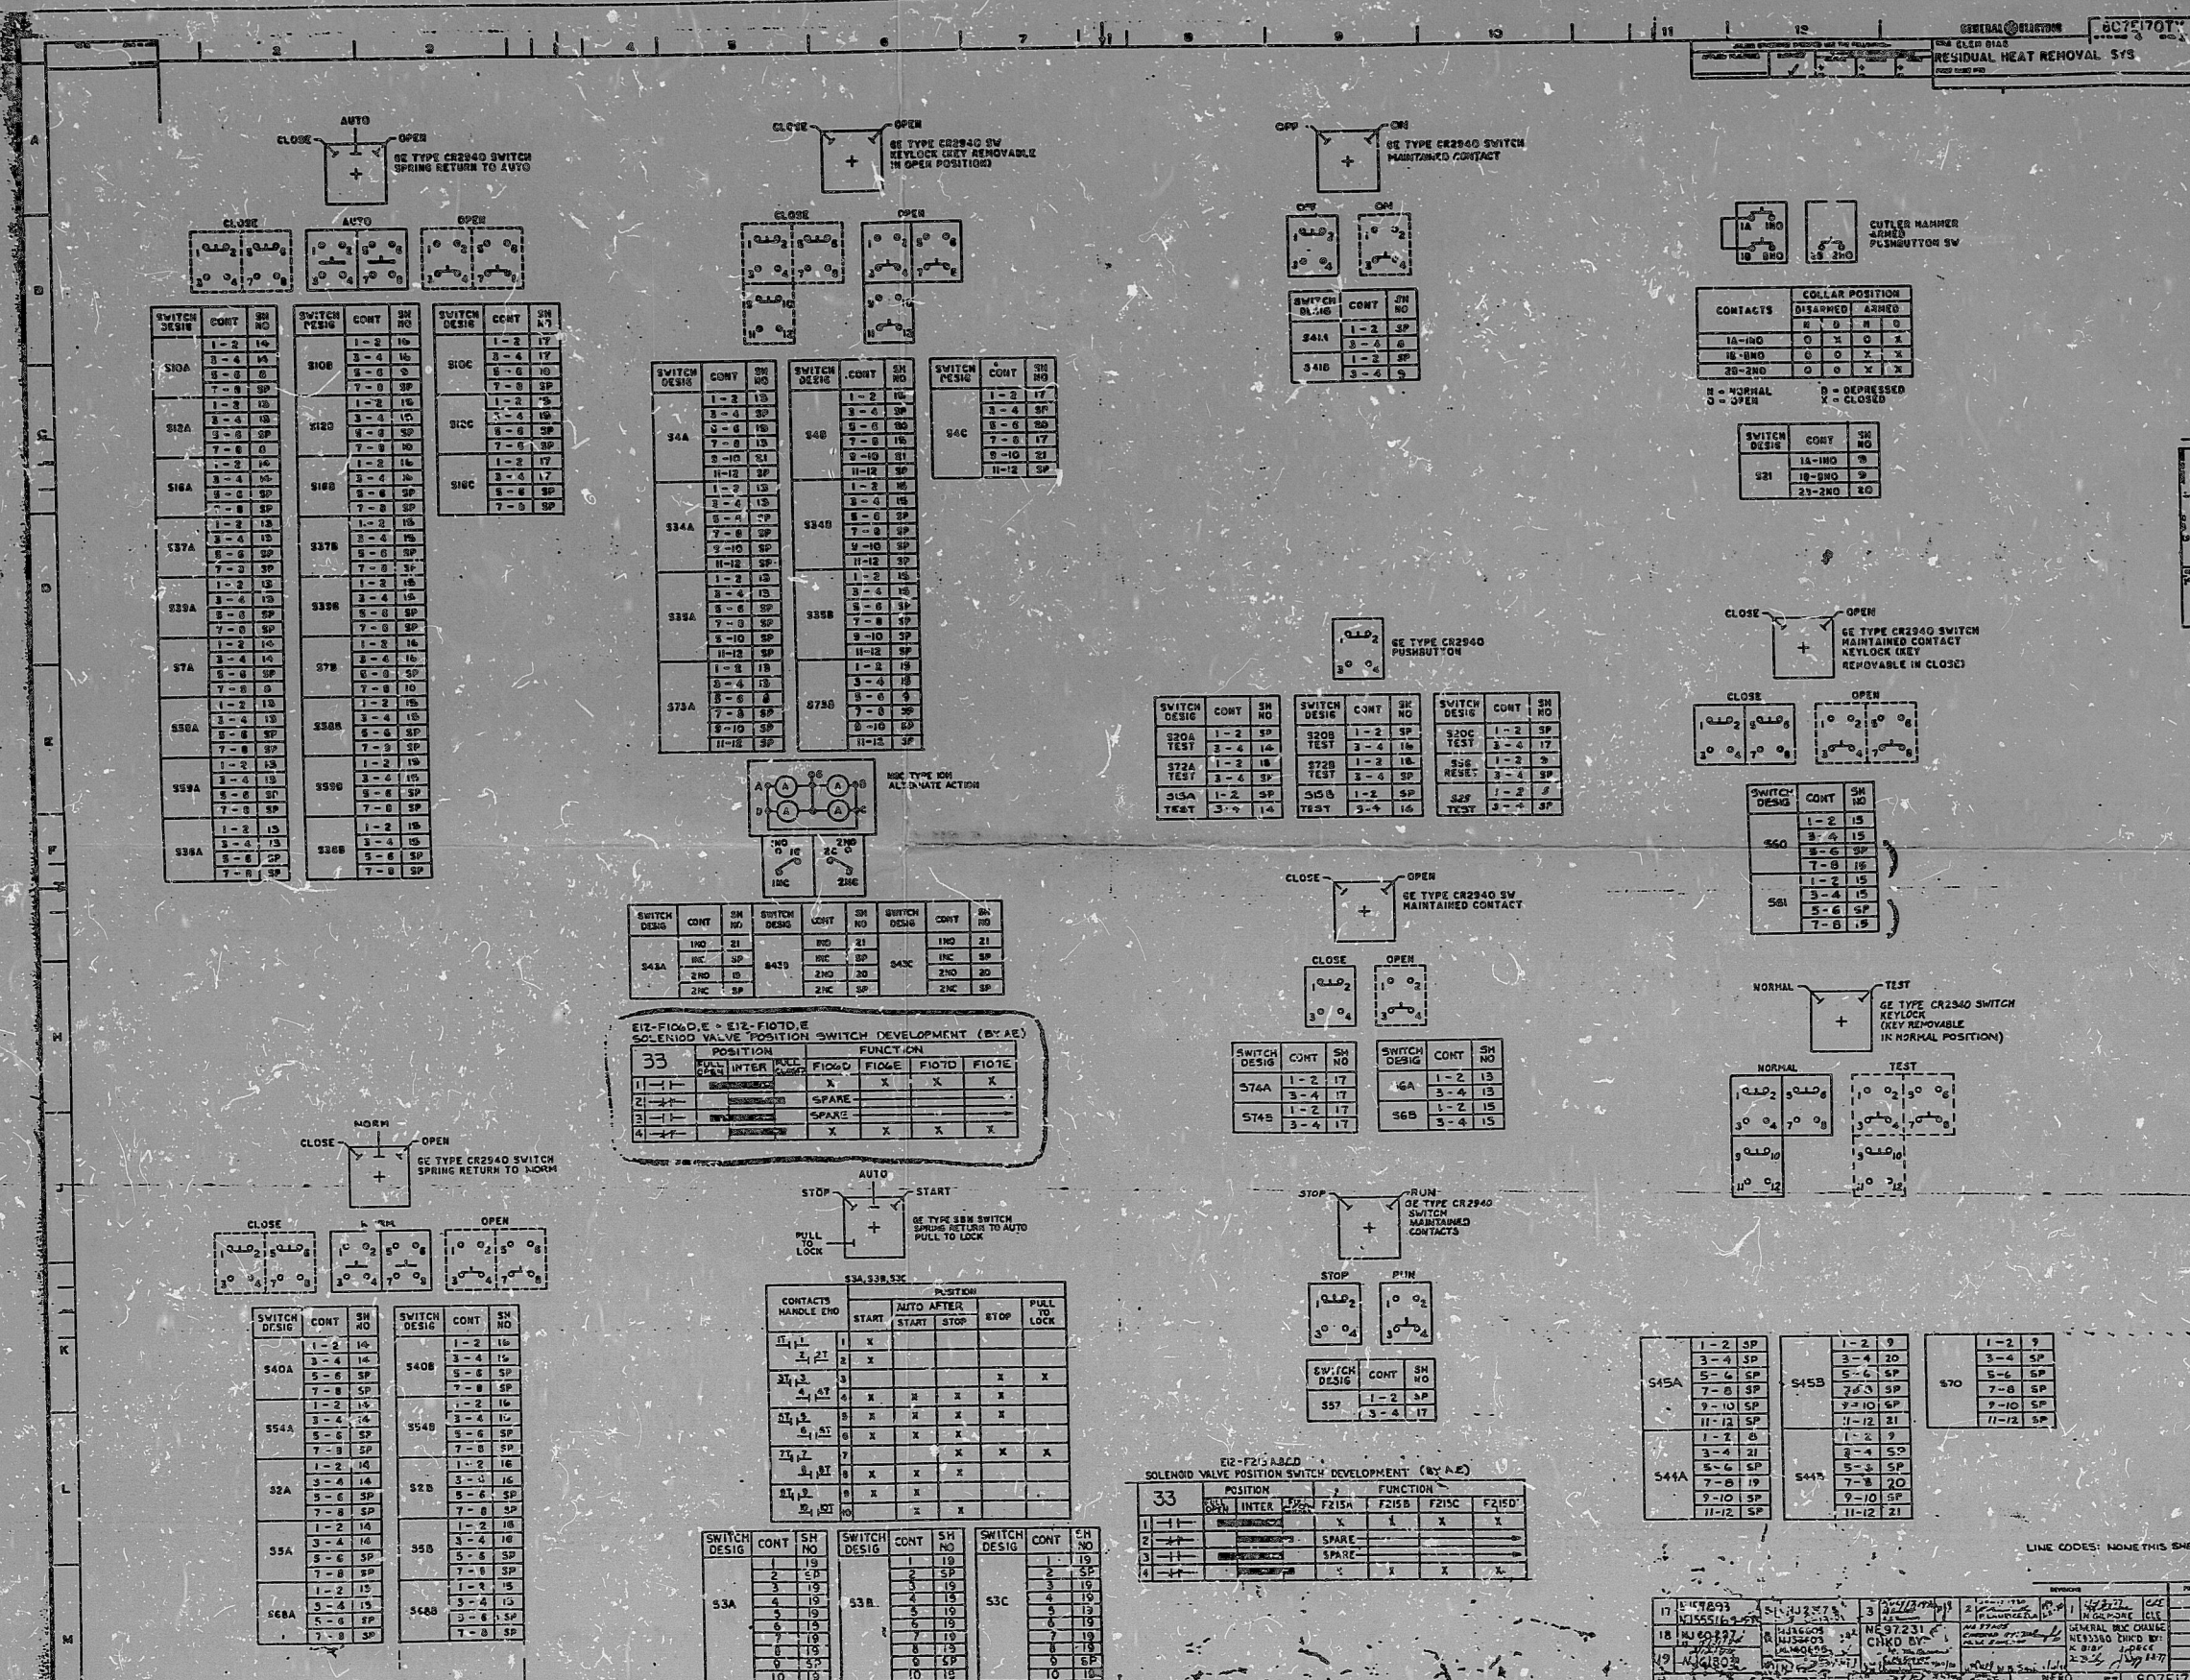

PDR RIDS

8601090165

