
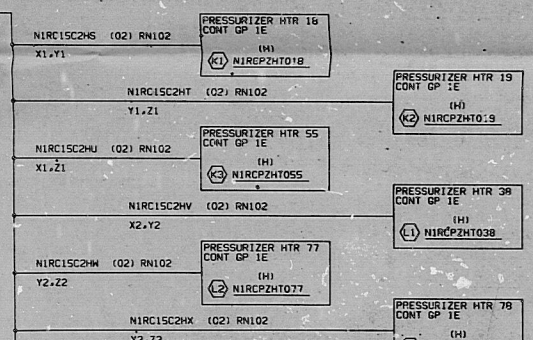
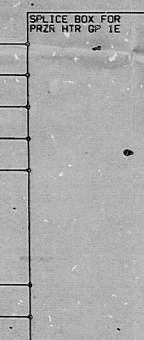
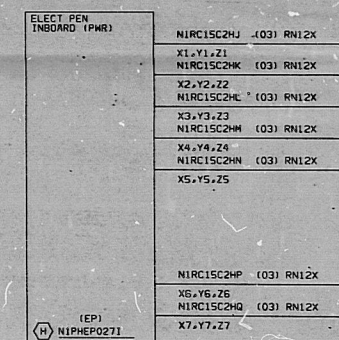
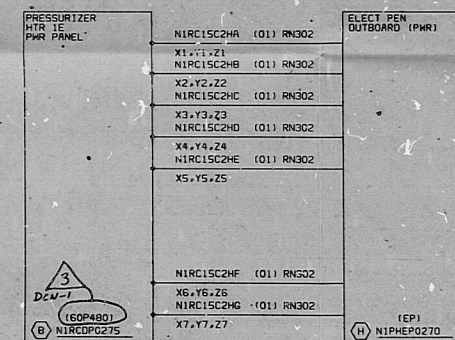


PL&P CHIEF ENGINEER 3 N/A 2 N/A 1 N/A 0 N/A NO. SIGNATURE 0386-0182 PRZR HTR ARRANGEMENT DWG NO. REFERENCE DWG NO. REFERENCE NO. DATE REVISION RE CKR DL EGS PE NO. DATE REVISION INCORP. DOWNS REVISED AS SHOWN REVISED AS SHOWN ISSUED FOR CONSTR. 3/27/74 2/2/74 1/2/74 0/2/74 BECHTEL ENERGY CORPORATION HOUSTON, TEXAS HOUSTON LIGHTING & POWER CO. SOUTH TEXAS PROJECT ELEMENTARY DIAGRAM REACTOR COOLANT PRESSURIZER HEATER ASSEMBLY BACK-UP GROUP 1D & 1E SCALE DATE 14928 MARKING NO. 9-E-RC15-02 REV. 3											
---	--	--	--	--	--	--	--	--	--	--	--	---	--	--	--	--	--	--	--	--	--	--	--

PDR RIDS

8701280112

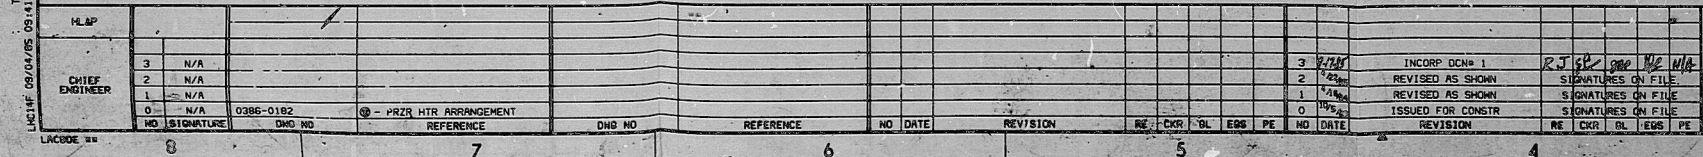