

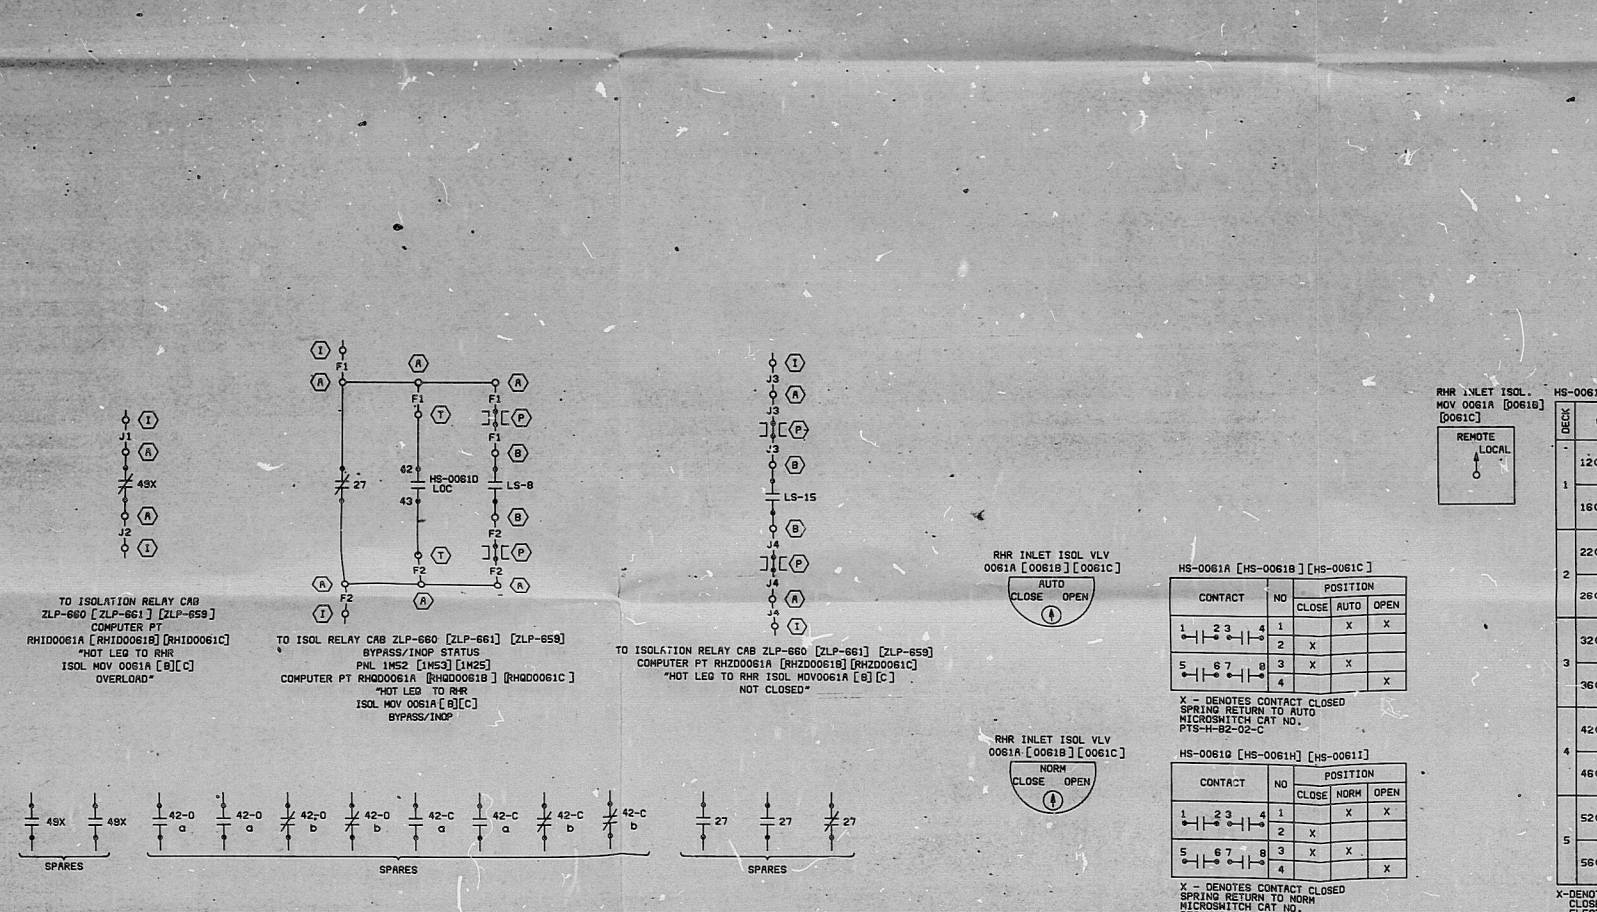
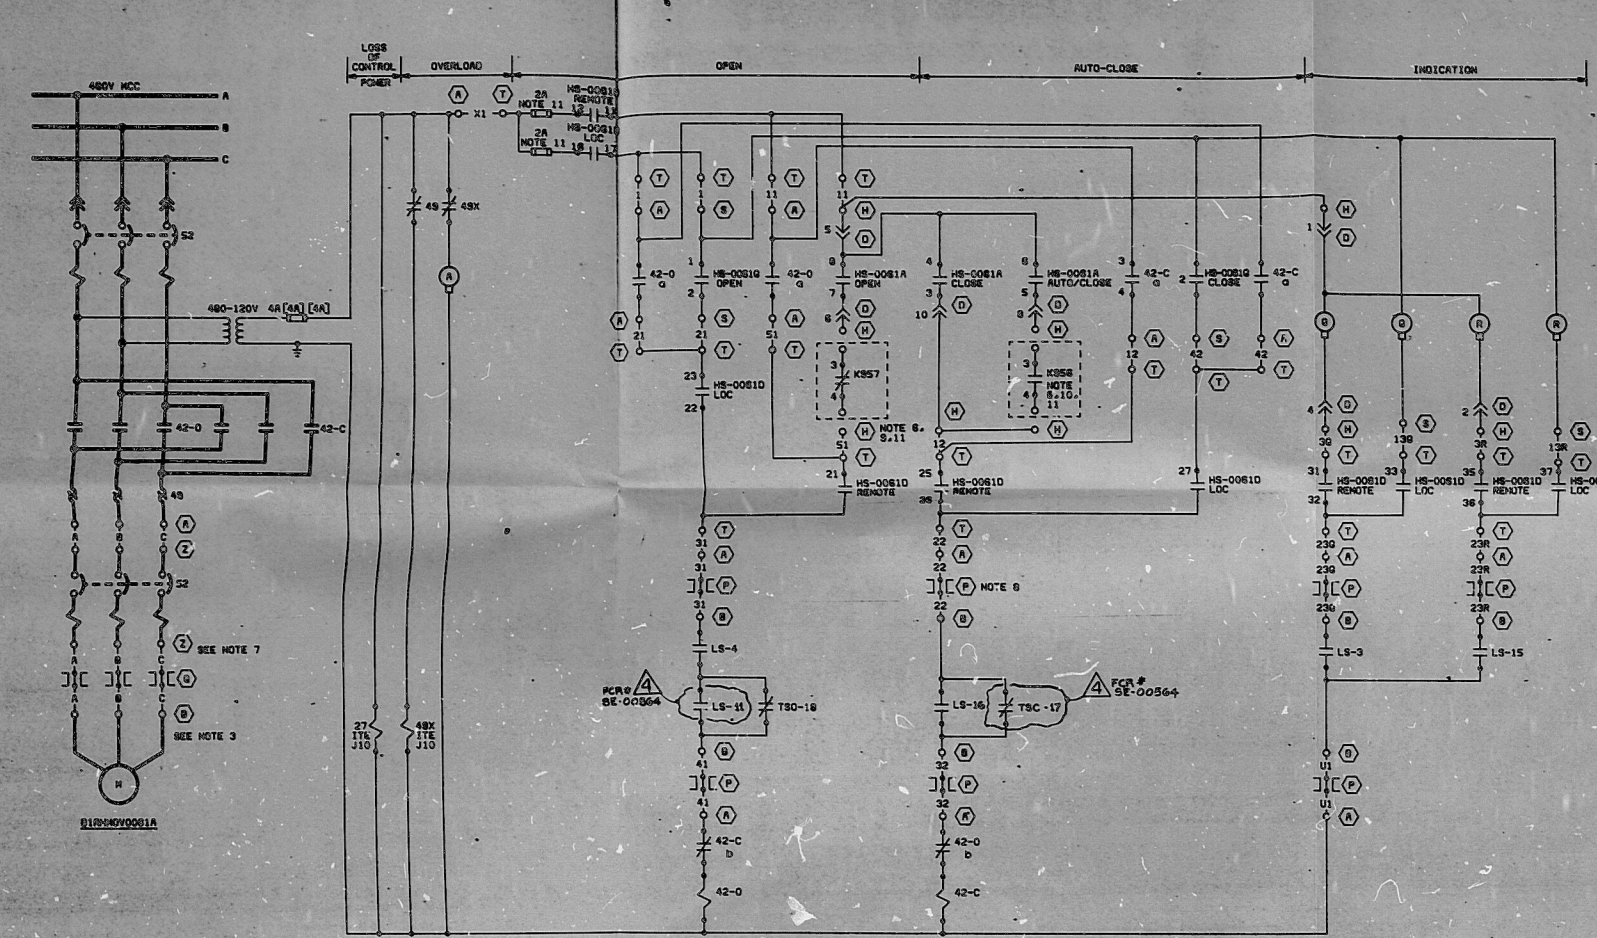


THIS DRAWING AND THE DESIGN IT COVERS ARE THE PROPERTY OF BECHTEL. THEY ARE LOANED TO YOU BY THE BUREAU OF THE BORROWER'S EXPRESS AGREEMENT THAT THEY ARE NOT TO BE REPRODUCED, COPIED, LOANED, OR USED EXCEPT IN THE LIMITED WAY AND PRIVATE USE PERMITTED BY ANY WRITTEN CONSENT GIVEN BY THE BORROWER TO THE BORROWER.

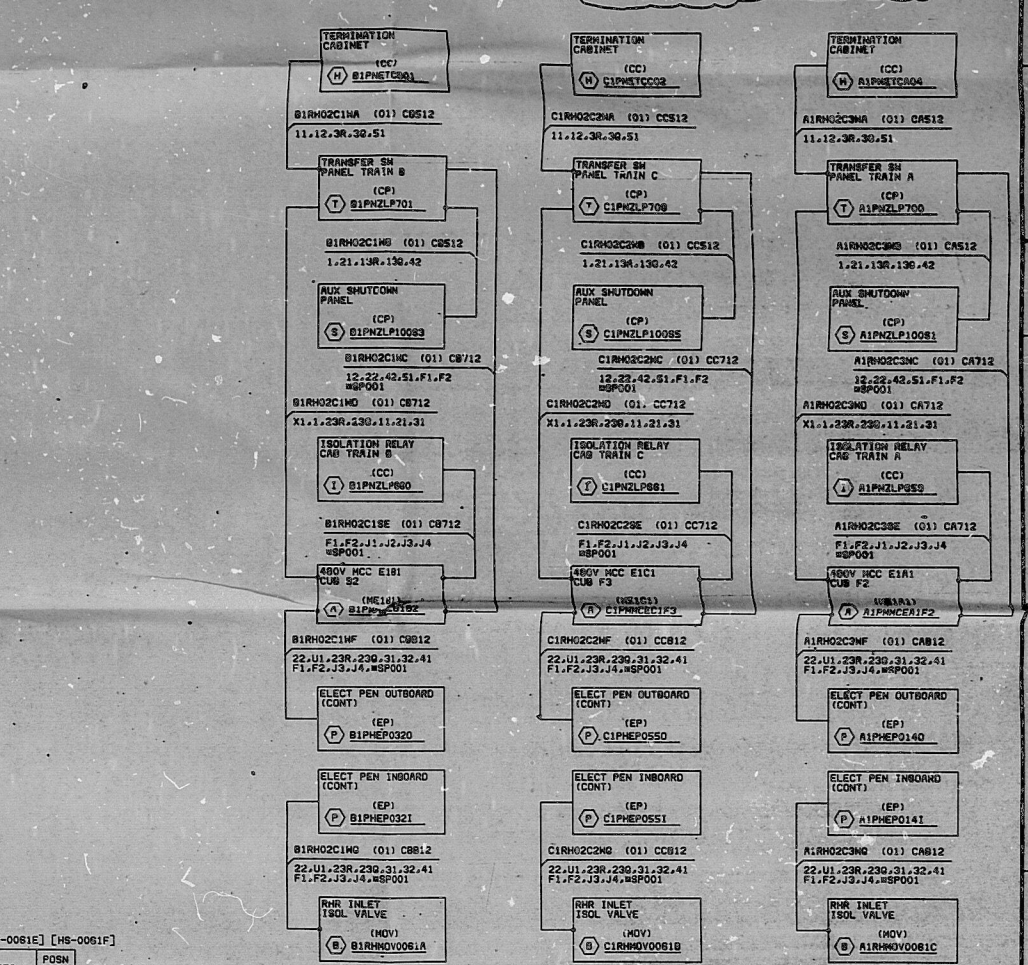


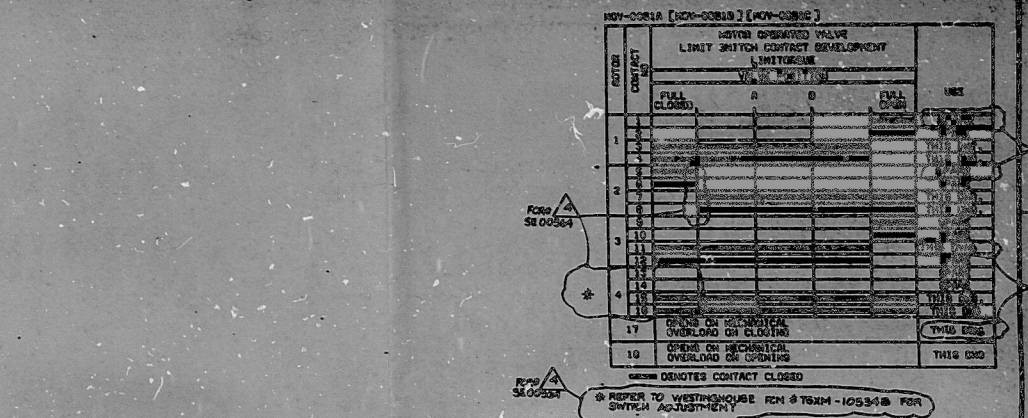



BECHTEL ENERGY CORPORATION
HOUSTON, TEXAS
HOUSTON LIGHTING & POWER CO.
SOUTH TEXAS PROJECT
NUCLEAR SAFETY RELATED
ELECTRICITY DIAGRAM
RHR INLET ISOLATION VALVE
10/1/74

PDR RIDS

87 01 280174

