


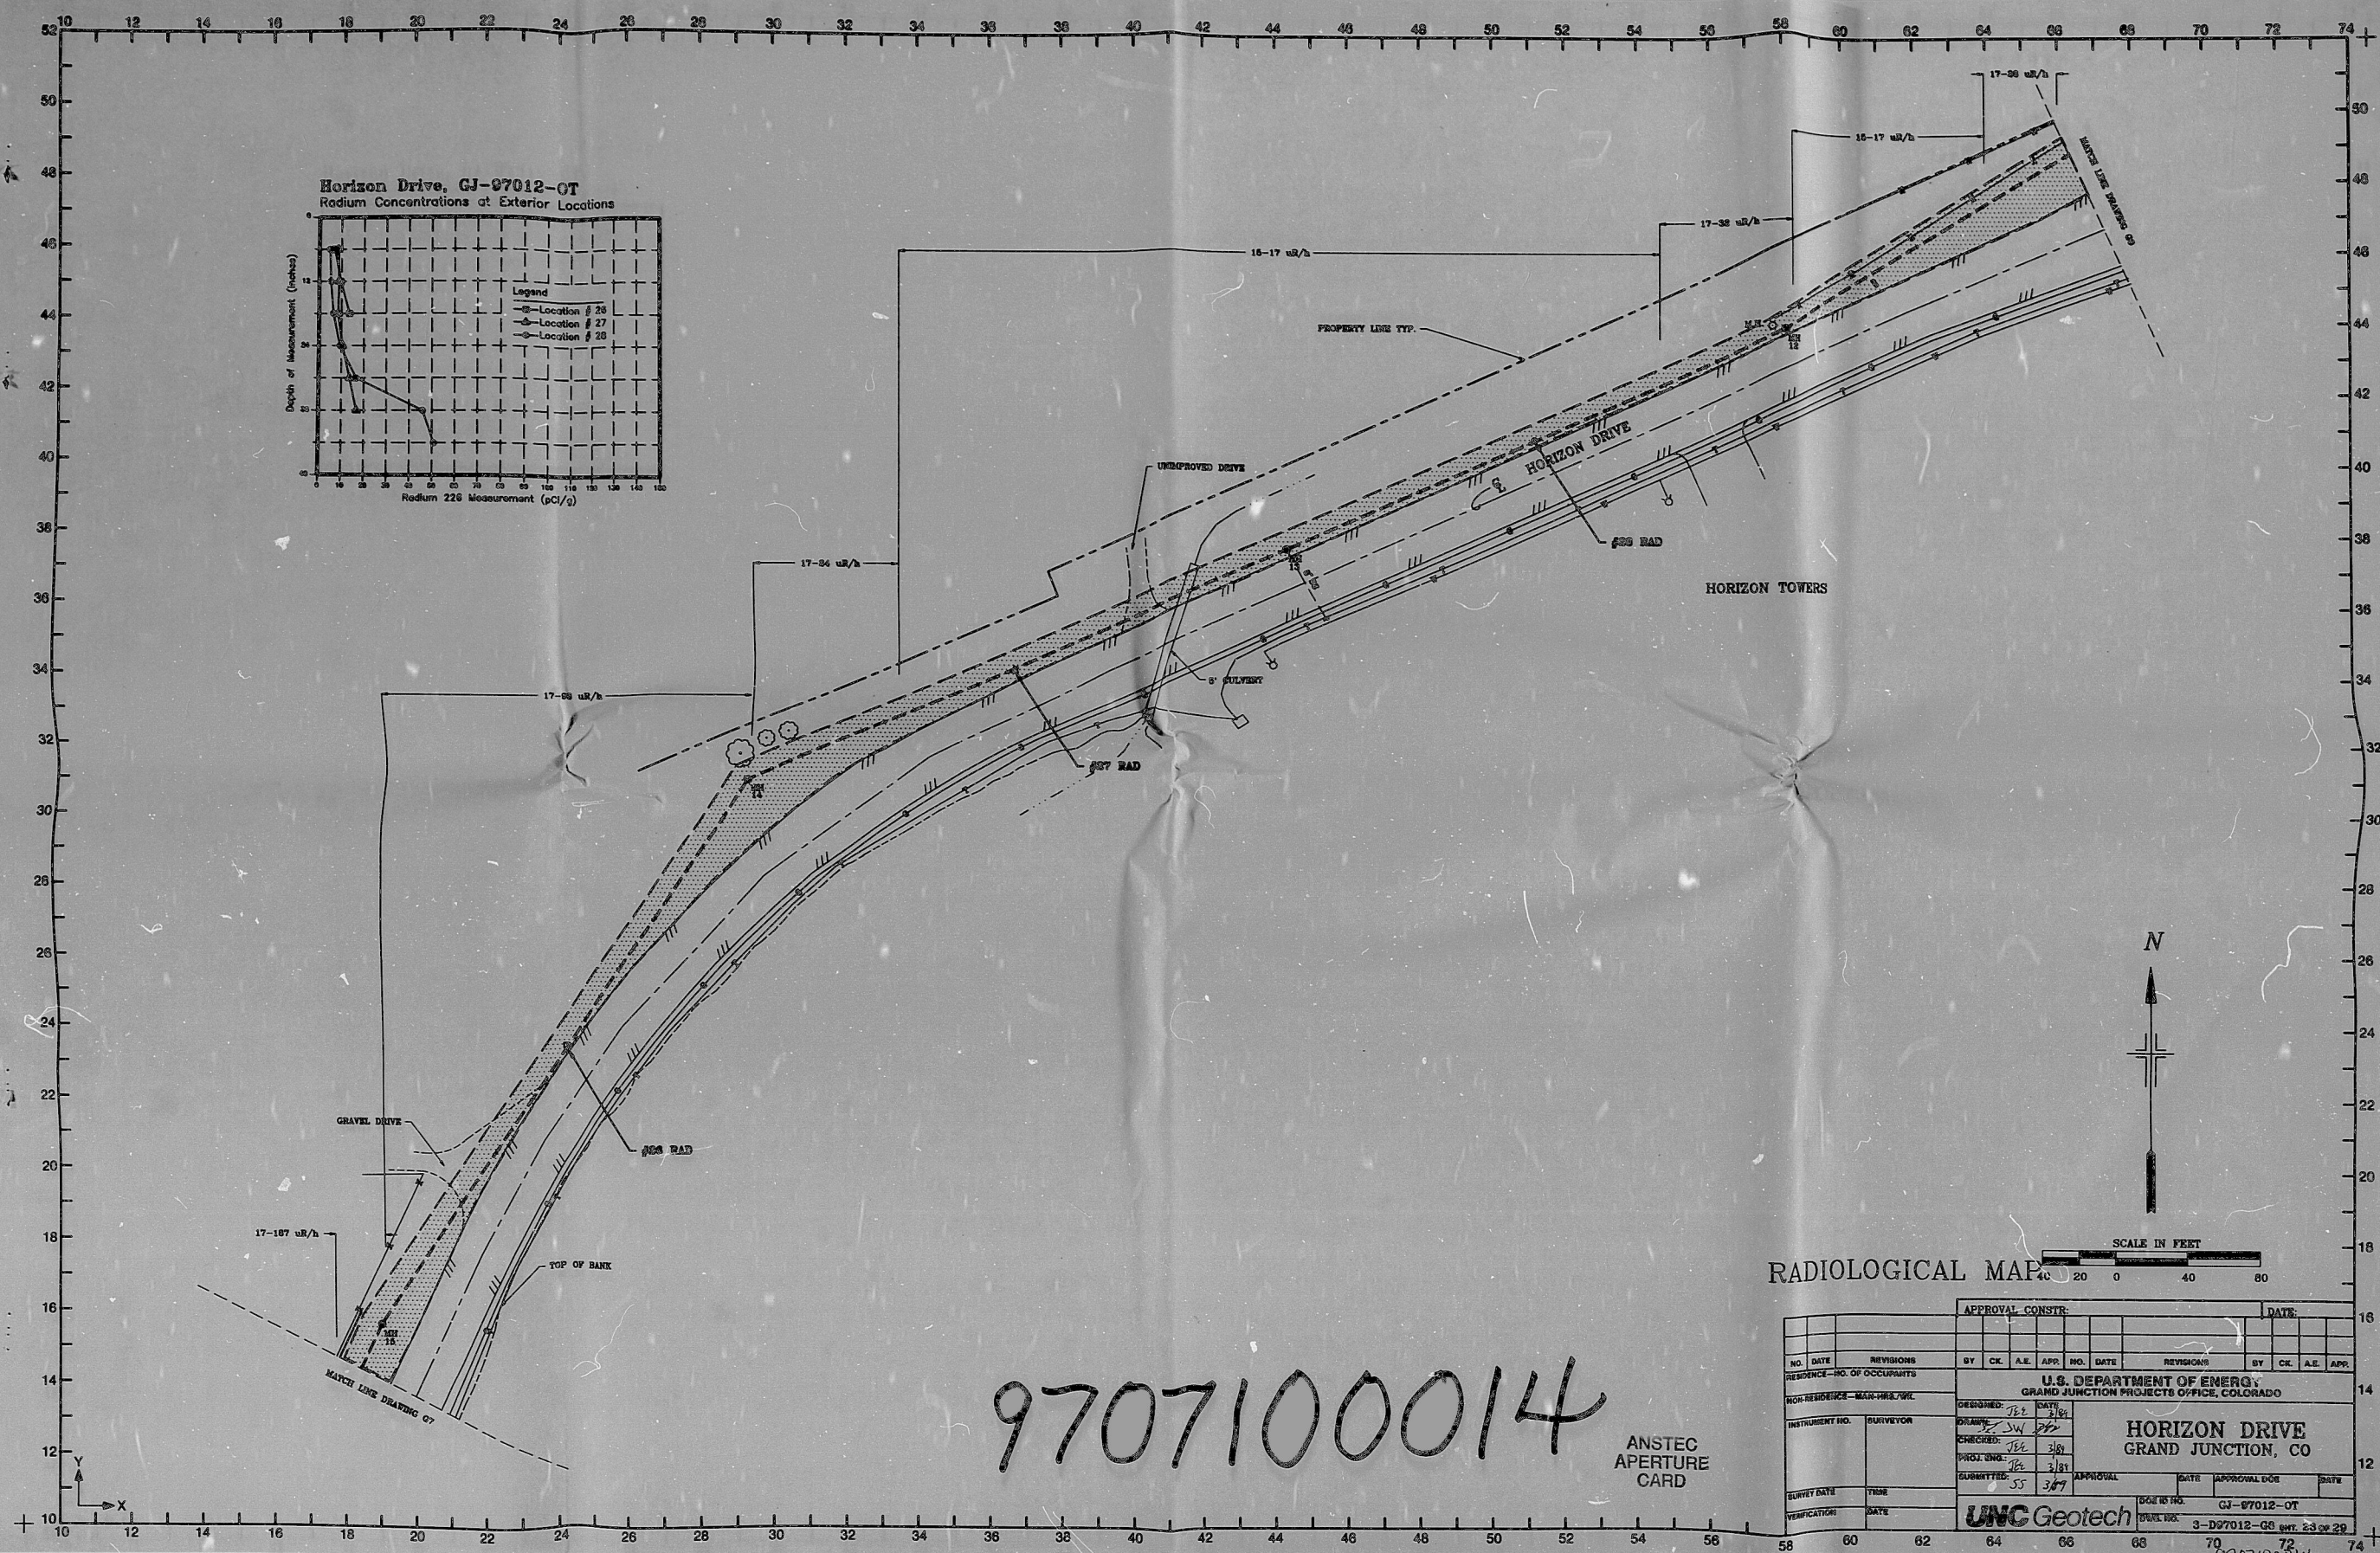

9707100014

PDR RIDS

9707100014

