


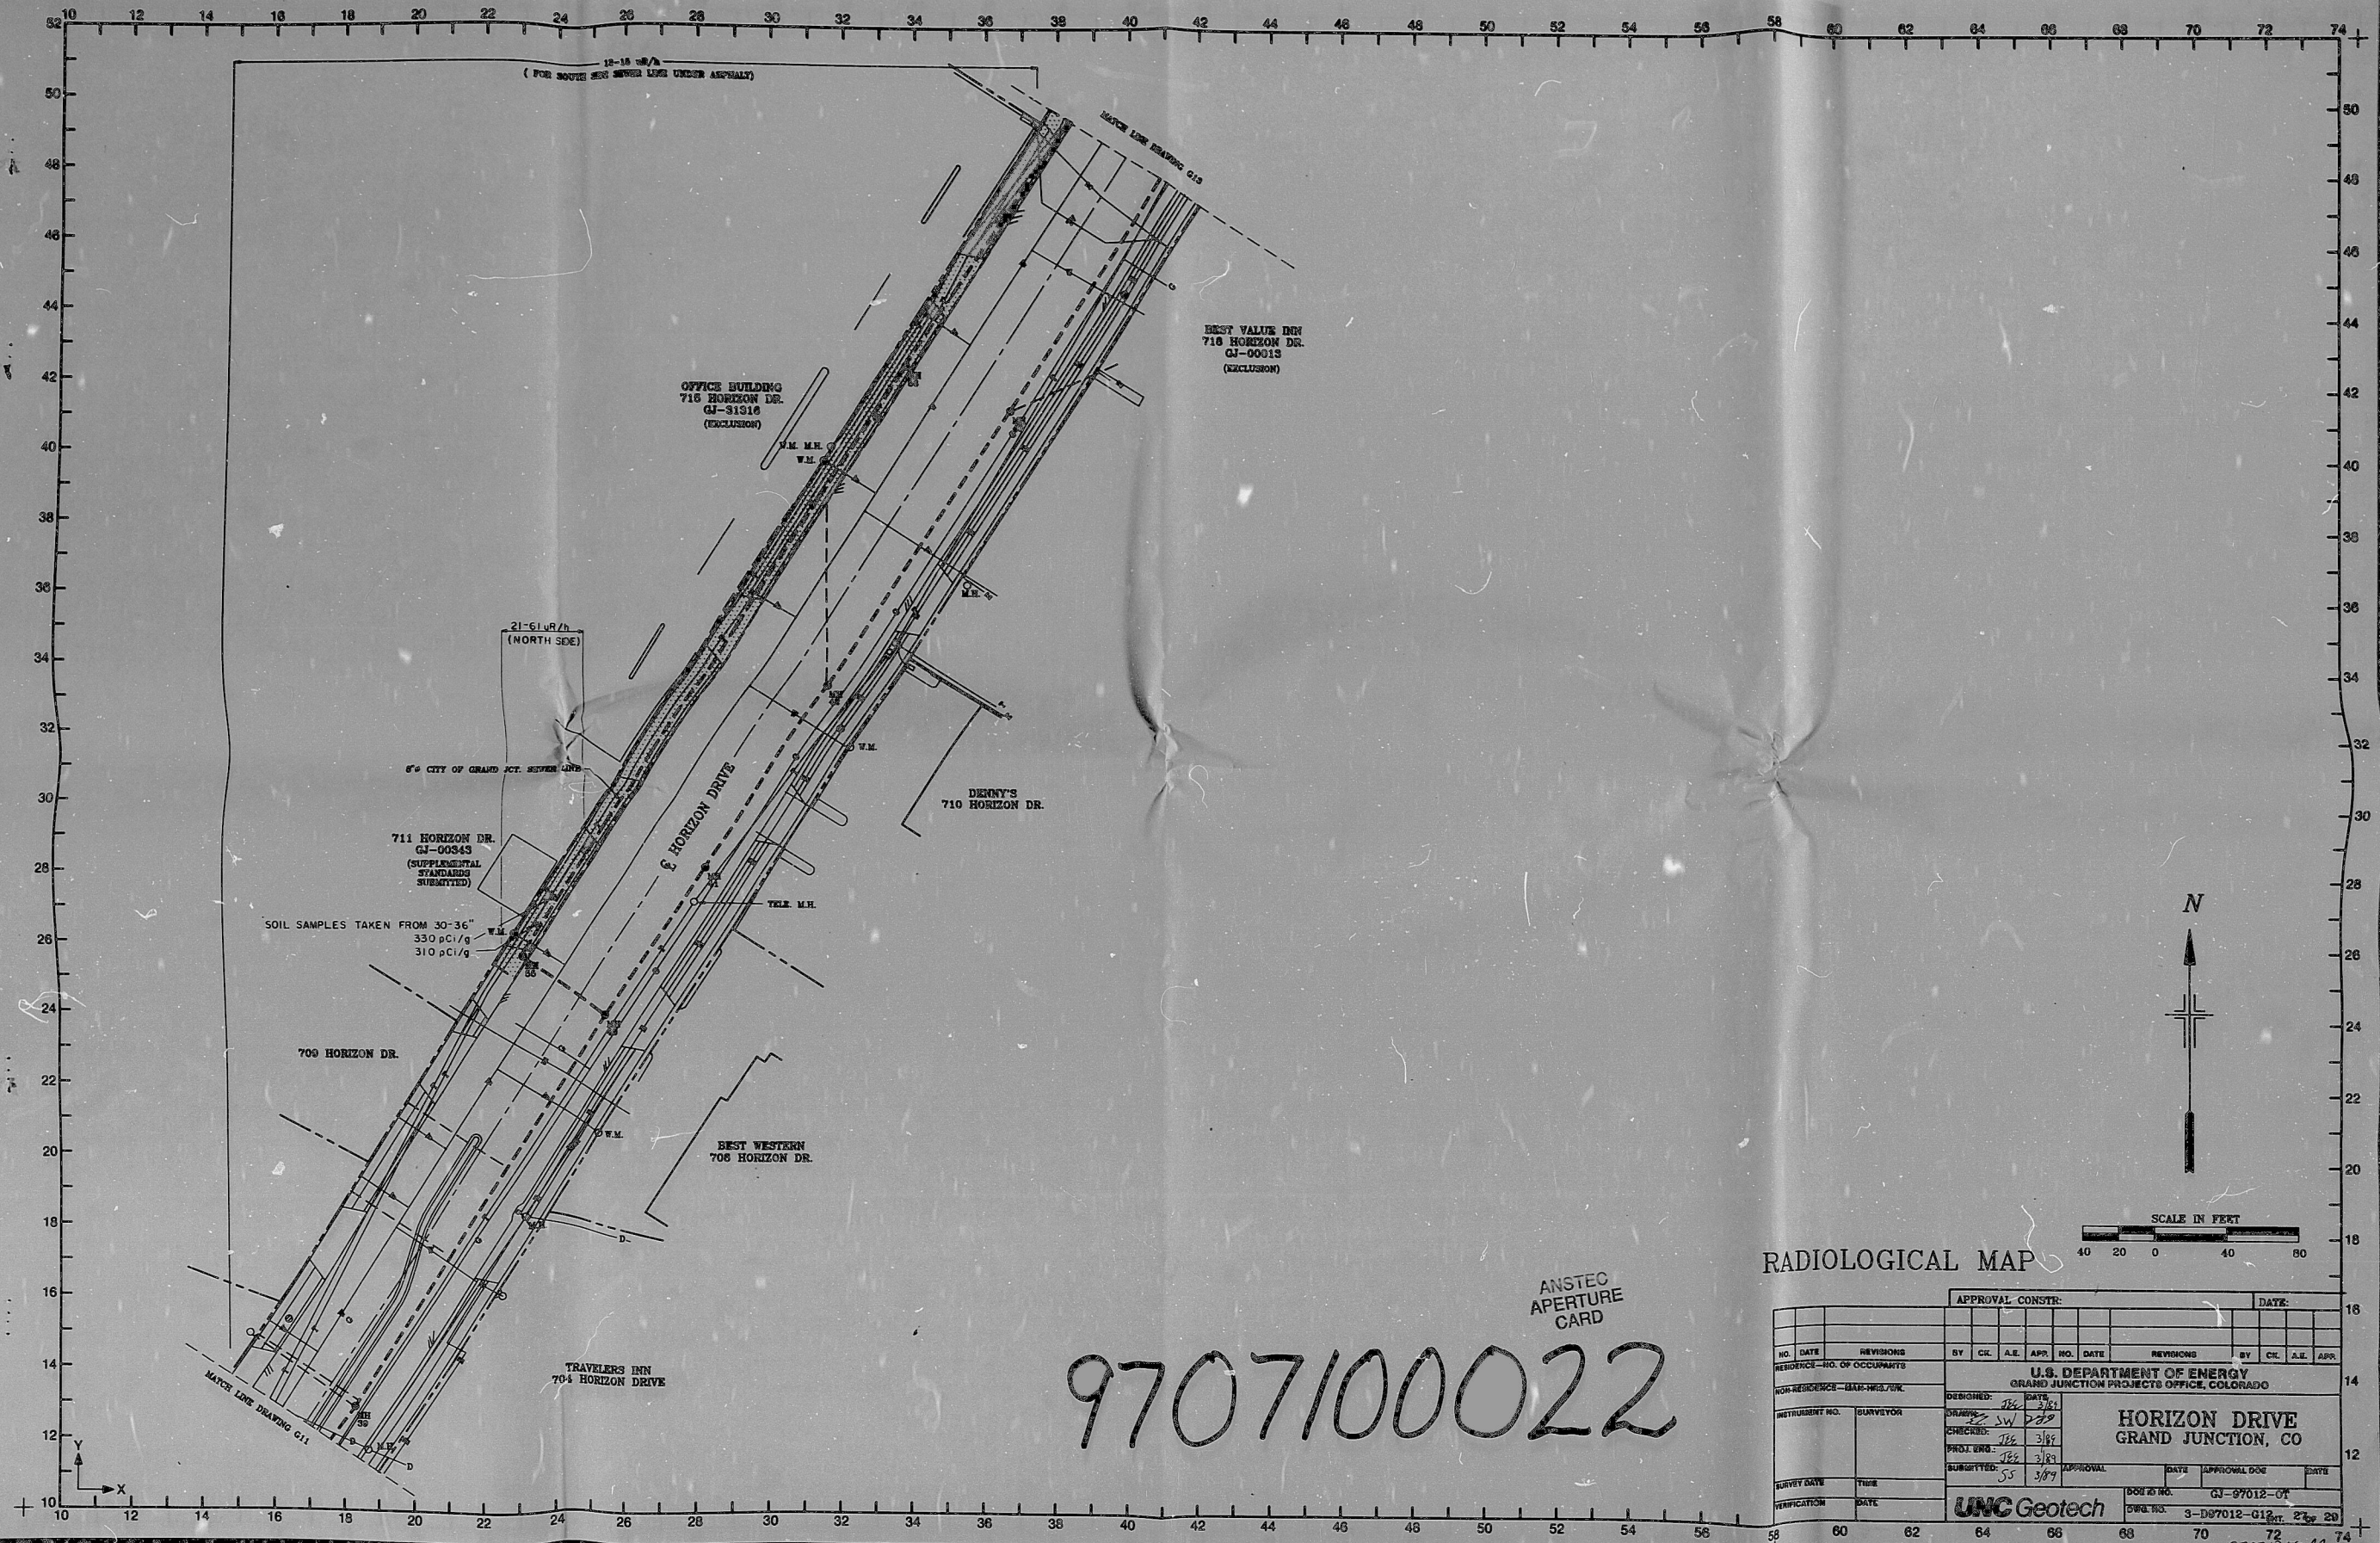

9707100022

ANSTEC
APERTURE
CARD

RADIOLOGICAL MAP

APPROVAL CONSTR.										DATE			
NO.	DATE	REVISIONS	BY	CHK.	A.E.	APP.	NO.	DATE	REVISIONS	BY	CHK.	A.E.	APP.
U.S. DEPARTMENT OF ENERGY GRAND JUNCTION PROJECTS OFFICE, COLORADO													
HORIZON DRIVE GRAND JUNCTION, CO													
UNC Geotech													
DOC NO. GJ-97012-01													

9707100022

PDR RIDS

9707100022

