


NI
NC

20258

BILL OF MATERIAL									
MATERIAL L.C.	QUANTITY	MATERIAL		SPECIFICATION	DESCRIPTION	CONST.	SIZE	SCH.	LOT NO.
		CLASS	TYPE						

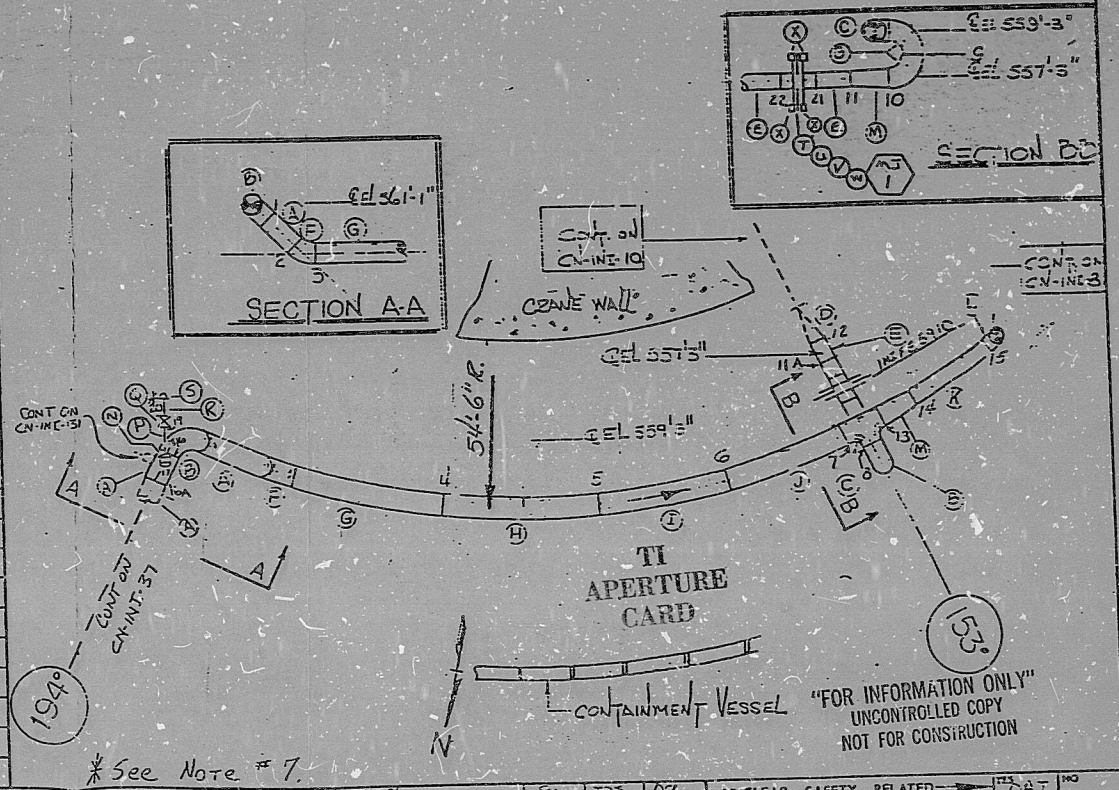

NOTES:
 ① ALL WELD NUMBERS SHALL BE PRECEDED BY INTI-
 ② LAST WELD NO. 20
 ③ REF. LAYOUT DWG. CN-1491-N1011/1/17,908
 ④ REF. FLOW DWG. CN-1562-13
 ⑤ ORIFICE PLATE BY INSTRUMENTATION.
 ⑥ All Asen. Long Nos Shall Be 100.0000 57.11.1
 ⑦ Weld N1-20 WAS DISCONTINUED FROM CLC TO
 CLC FR 1620-47. ALL REVISIONS IN PLANT SHOULD REFLECT THIS

REVISION			NUCLEAR SAFETY RELATED		

DUKE POWER COMPANY
 CATAWBA NUCLEAR STATION
 TITLE
 SAFETY INJECTION SYSTEM
 FROM RESIDUAL HEAT REMOVAL "X" 18"
 SYS. NT LINE NO. 12 DUKE CLASS 22
 PIPING SPEC. PS-2501.2
 LOCATION REACTOR (STU)
 DWG. NO. CN-1491-1
 REV. NO. 8

PDR RIDS

8808220094

