


AO  
 VERIFIED  
 SYS. 200-F3  
 200-F3, 200-F3

HIGH ENERGY

BILL OF MATERIAL						
LINE	QTY	DESCRIPTION	UNIT	SIZE	WGT	NOTES
A	2	ASS 3" PIPE	SMLS	6"	160	
B	2	ASS 3" 90° EL	DN SMLS	6"	160	
C	1	ASS 3" 45° EL	DN SMLS	6"	160	
D	0	ASS 3" RED. TEE	DN SMLS	6"	160	
E	0	ASS 3" PRESSURIZER	DN	6"	160	

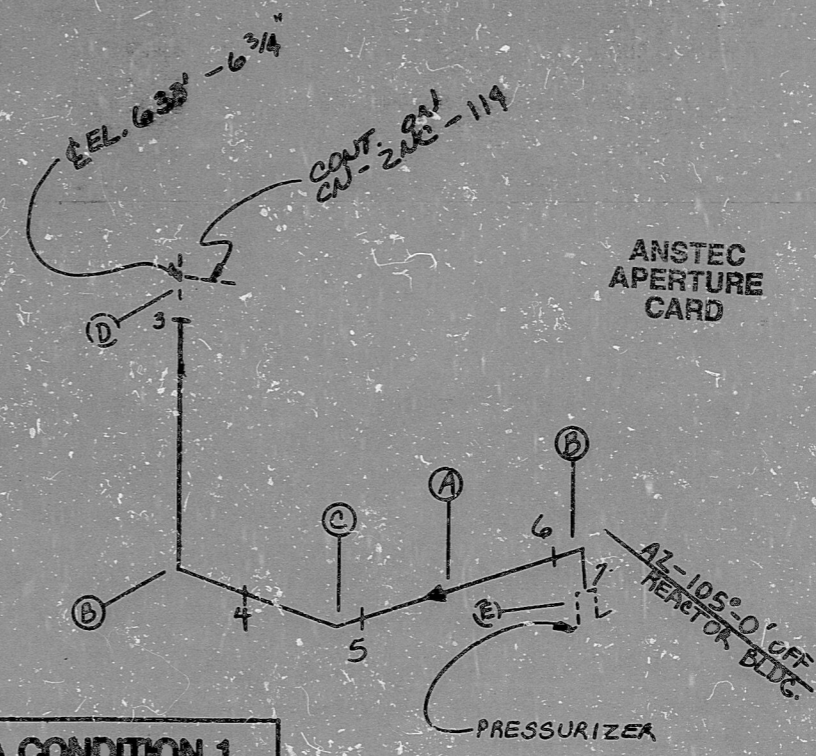

Q A CONDITION 1  
 NUCLEAR SAFETY RELATED

NOTES:  
 ① ALL WELD NUMBERS SHALL BE PRECEDED BY 200-117 -  
 ② LAST WELD NO. 7  
 ③ REF. LAYOUT DWG. CN-2391-NC100  
 ④ REF. FLOW DWG. CN-2553-11 (F-3,4)

FOR INFORMATION ONLY

NO.	REVISION
3	REV. ITEM C TO LOTS
2	REV. ITEM D
1	REV. WELDS 1 & 2
0	REL. FOR CONST.

Q A CONDITION I -  
 DUCHE POWER COMPANY  
 CLEMENS NUCLEAR DIVISION  
 TITLE REACTOR COOLANT SYS. ✓  
 PRESSURIZER - 2 DISCHARGE  
 SYS. NC - LINE NO. 07 - UNIT CLASS B  
 PIPING SPEC. P. 3-2501  
 LOCATION REACTOR BLDG. (AOP)  
 DWG. NO. CN-200-117



PDR RIDS

9403130229

