


9E-SP03.02

THIS DRAWING AND THE DESIGN IT COVERS ARE THE PROPERTY OF BECHTEL. THEY ARE LOANED TO YOU BY THE SIGNATURE OF BECHTEL. IT IS YOUR RESPONSIBILITY TO RETURN THEM TO BECHTEL. ANY REPRODUCTION OR USE OF THIS DRAWING WITHOUT THE WRITTEN PERMISSION OF BECHTEL IS PROHIBITED. ANY VIOLATION OF THIS NOTICE WILL BE CONSIDERED A VIOLATION OF THE PATENT RIGHTS OF BECHTEL.

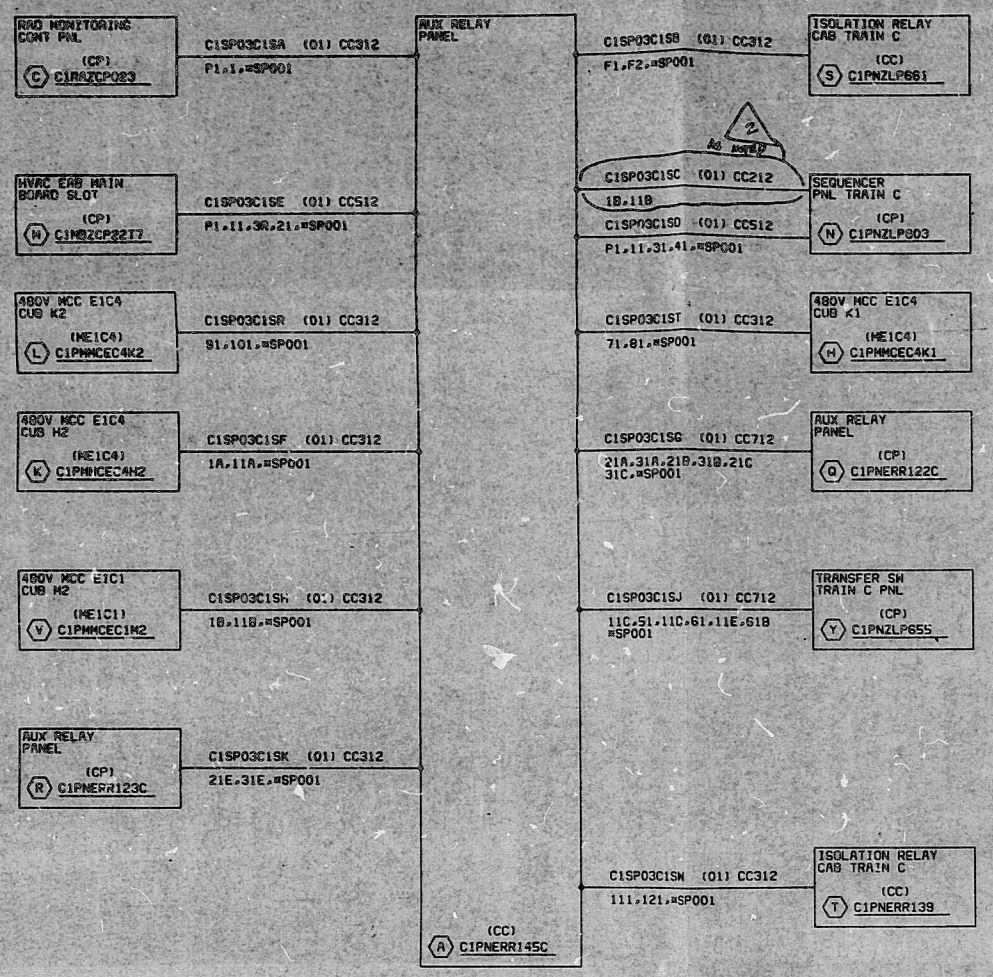

TI
APERTURE
CARD

NOTES:
1. SCHEMATIC, REF. DNG'S & NOTES SHOWN ON
DNG 9-E-SP03-01.

HOUSTON OFFICE ISSUED
INFORMATION ONLY
STP 14926

HOUSTON OFFICE ISSUED
INFORMATION ONLY
STP 14926

NUCLEAR SAFETY RELATED

ELEMENTARY DIAGRAM
CONTROL ROOM HVAC EMER OPERATION
TRAIN C

BECHTEL ENERGY CORPORATION
HOUSTON, TEXAS

HOUSTON LIGHTING & POWER CO.
SOUTH TEXAS PROJECT

SCALE: NONE
JOB NO: 14926
DRAWING NO: 9-E-SP03-02
REV: 2

NO	SIGNATURE	DWG NO	REFERENCE	DWG NO	REFERENCE	NO	DATE	REVISION	RE	CKR	CL	EGS	PE	NO	DATE	REVISION	RE	CKR	CL	EGS	PE
2	N/A													2	10/20/80	REVISED AS SHOWN	RJ	gpc	yo	no	WFF
1	N/A													1	10/20/80	INC. DCN 1. REMOVED					
0	N/A															HOLD AND REVISED AS					
																SHOWN. REF. DCAR 57.77					
																ISSUED FOR CONST					

FK 8701288525

PDR RIDS

8701280525

