


2117-05
 AO
 VERIFIED
 SYSTEM
 2117-05
 2117-05

CN-2492-106 7

BILL OF MATERIAL									
QTY	DESCRIPTION	CLASS	GRADE	SIZE	UNIT	QTY	UNIT	QTY	UNIT
A	16	1	SS	3/4"	PIPE	SMLS	4"	160	
B	22	0	SS	3/4"	PIPE	SMLS	5"	160	
C	2	0	SS	3/4"	WELD				
D	1	0	SS	3/4"	TEE	(BW)	4"	160	
E	1	0	SS	3/4"	TEE	(BW)	4"	160	
F	5	0	SS	3/4"	WELD				
G	2	0	SS	3/4"	WELD				
H	1	A	SS	3/4"	TEE	(BW)	4"	160	
J	1	A	SS	3/4"	TEE	(BW)	4"	160	
K	1	B	SS	3/4"	WELD				
L	1	A	SS	3/4"	WELD				
M	1	B	SS	3/4"	WELD				
N	1	B	SS	3/4"	WELD				

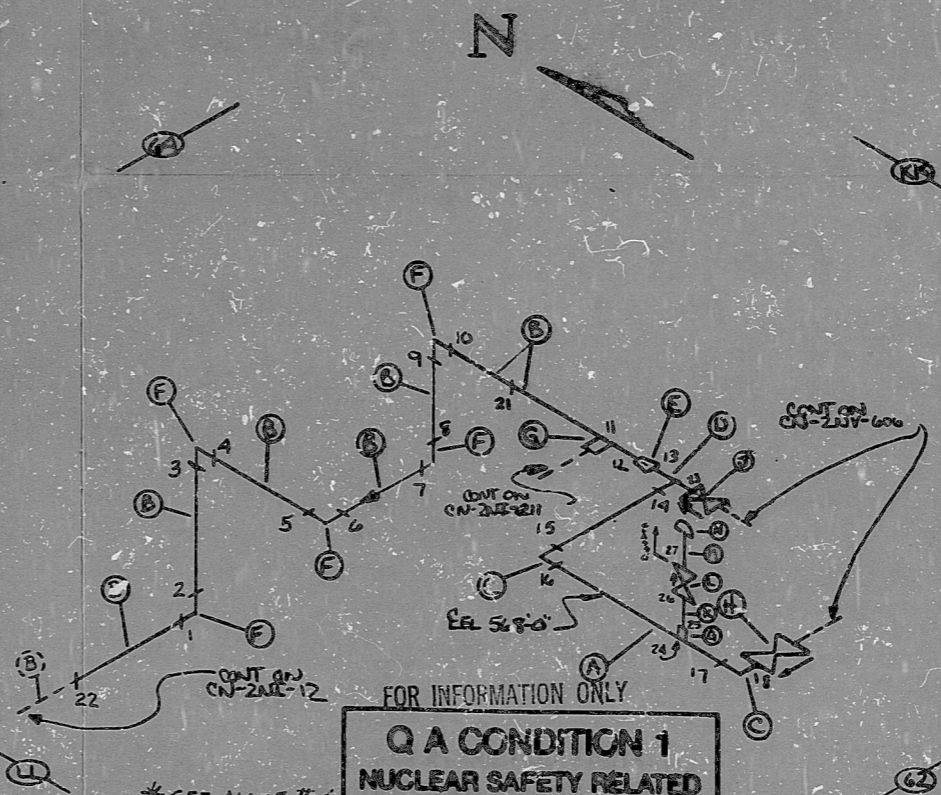

ANSTEC
 APERTURE
 CARD

NOTES:
 1 ALL WELD NUMBERS SHALL BE PRECEDED BY 2NI106-
 2 LAST WELD NO. 27
 3 REF. LAYOUT DWG CN-2492-N1009
 4 REF. FLOW DWG CN-2362-1.0 (EF-3,4)
 5 CHECK FOR INSUR. INSP. TEMP 300°F PRESS 2750 PSIA
 6 REINSTATE AND TRANSFER WELD 2NI103-17 TO 2NI106-23
 PER WELD TRANSFER RECORD # 245.
 7 WELD 17 IS CLASS 'G'

*SEE NOTE #6
 7 ADD WELDS 24, 25, 26, 100
 6 ADDED NOTE #6
 5 New Insur. & Insp. at 300 Inm
 4 ADDED WELD 17-22
 3 Add Weld 21. Add Cont.
 2 Add Weld From E
 1 Key Item A
 REL FOR CONSTR.

NO.	REVISION	DATE	BY	CHKD.
1				
2				
3				
4				
5				
6				
7				

NUCLEAR - SAFETY RELATED
 DUNE POWER COMPANY
 CAROLINA NUCLEAR STATION
 SAFETY INJECTION SYS.
 BORON INJECTION TANK 2 DISCHG
 SVE NI LINE NO. 02
 Piping SPEC. PS 2501.2
 LOCATION AUXILIARY BLDG (A-6)
 DWN. NO. CN-2NI-106
 REV. NO. 7

PDR RIDS

9603130240

