


AC  
VERIFIED  
SYS. 2NS17

CN-2NS-13 2

REV.	DATE	BY	DESCRIPTION	QTY.	REQ.	QTY.	REQ.
A	07	SS	ADD TO PIPE	5'	40		
B	08	SS	ADD TO PIPE (W)	5'	40		

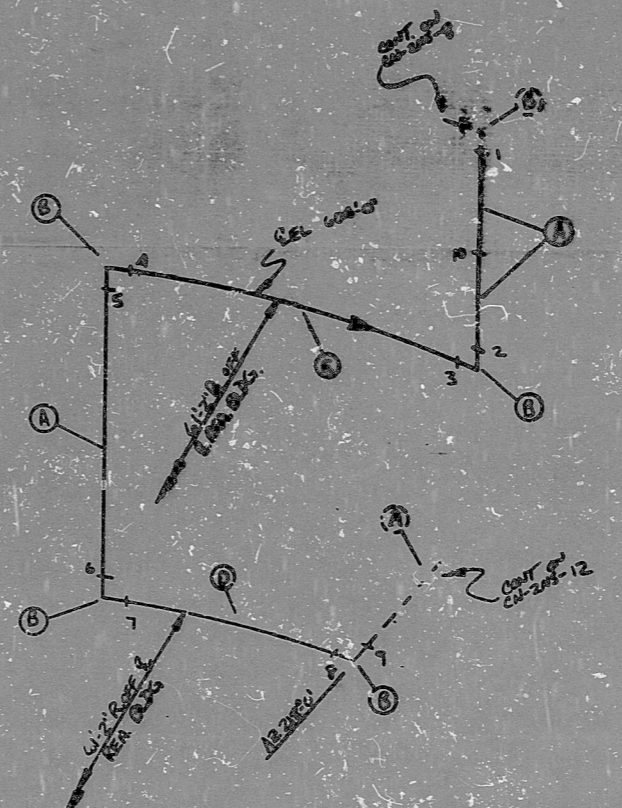

NOTES:  
 1. ALL WELD NUMBERS SHALL BE PRECEDED BY 2NS13-  
 2. LAST WELD NO. 10  
 3. REF. LAYOUT DWG. CN-2491-NS019  
 4. REF. FLOW DWG. CN-2503-1.0 (H3)  
 5. CHECK FOR INSP. INSP. 190PSIA @ 190°F

FOR INFORMATION ONLY

NO.	REVISION	DATE	BY	CHKD.	APP.
2	REV. MAP. I.D. AT CONT.				
1	REV. ITEM "A"				
0	REV. ITEM "B"				
	REL. FOR CONSTR.				

QA CONDITION	I
TITLE	CONTAINMENT SPRAY SYS.
	TO CONTAINMENT SPRAY NOZ. ZLES
SY. NS	LINE NO. 09
	DWG. CLASS. B
PIPING SPEC.	PS. 151.2
LOCATION	SEA BLDG. (RAN)
DWG. NO.	CN-2NS-13
REV. NO.	2

ANSTEC  
APERTURE  
CARD



PDR RIDS

9603140269

