


2PNTI, 2NBTI
AO
VERIFIED
SYS. F.W.N.B.
2N51, 2N52
2N53, 2N54

CN-2NS-32

ITEM NO.	QTY	UNIT	DESCRIPTION	CONTR.	SIZE	COL.	USE NO.

HM

SS

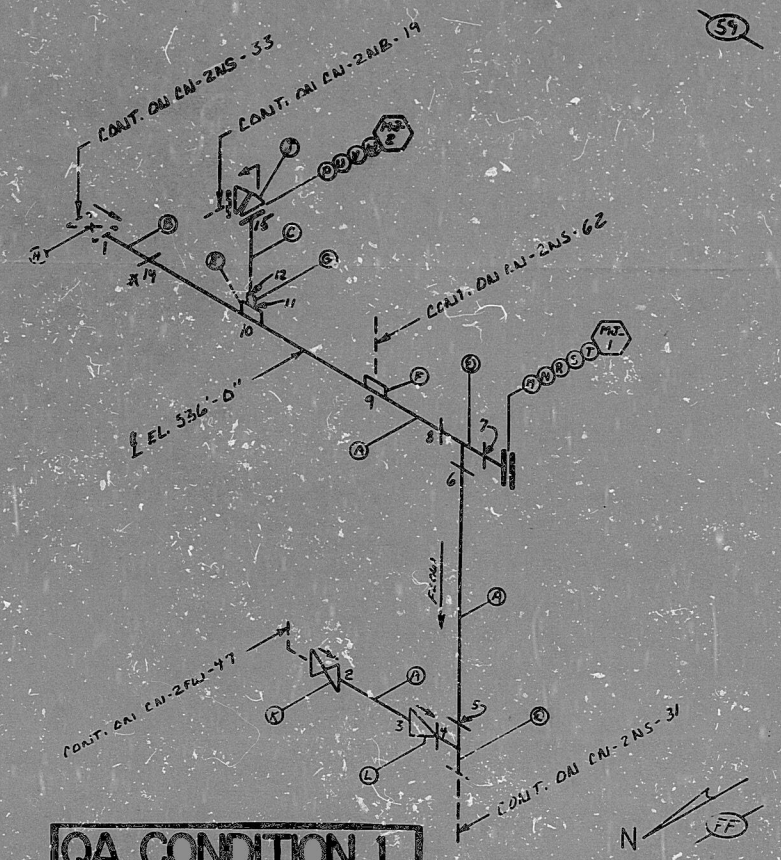

NOTES:
 1 ALL WELD NUMBERS SHALL BE PRECEDED BY _____
 2 LAST WELD NO. _____
 3 REV. LAYOUT DWG. CN-2NS-15006
 4 REF. FLOW DWG. CN-2NS-10 (SEE 510-1)
 5 CHECK FOR INTERFERENCE INSTALLED 225 DSA 190F
 6 ALL WELD JOINTS, NO. SMALL BE RELEVANT BY ENG'G
 7 TRANSITION 2-A-W-HD-E-11

FOR INFORMATION ONLY

QA CONDITION I

NO.	REVISION	DATE	BY	CHKD.
3	DEL. WELD TO AND WELD IN			
2	REV. ITEM 5 ITEM #			
1	Add Co. 1			
0	REL FOR CONST.			

ANSTEC APERTURE CARD

PDR RIDS

9603140336

