


AO
VERIFIED
SYS. (L. OF) (MMS)
T.M. 30 2017

CN-2NU-15

BILL OF MATERIALS									
MARK I.D.	CLASS	FORM	QTY	DESCRIPTION	CONTR.	SIZE	LEN	LOT NO.	REMARKS
A	11	B	55	SA 370 1/2" 904	PIPE	SMLS	4"	160	SA 370 1/2" 904
B	3	B	55	SA 405 1/2" 904	90° ELL (BW)	SMLS	4"	160	SA 405 1/2" 904
C	0	B	55	SA 405 1/2" 904	TEE (BW)	SMLS	4"	160	SA 405 1/2" 904
D	2	B	55	SA 182 1/2" 904	FLANGE (BW)	FOR	4"	160	SA 182 1/2" 904
E	1	A	55	SA 182 1/2" 904	GASKET (G-6)		4"		SA 182 1/2" 904
F	8	B	AS	SAMS 187	STUDS (B-5)		1/2"		SAMS 187
G	16	B	C3	SARY 2H	NUTS (B-5)		1/2"		SARY 2H
H	1	A	55		2NU495 (G7) (BW)		4"	160	2NU495 (G7) (BW)
J	1	A	55		2NU270 (C10) (BW)		4"	160	2NU270 (C10) (BW)

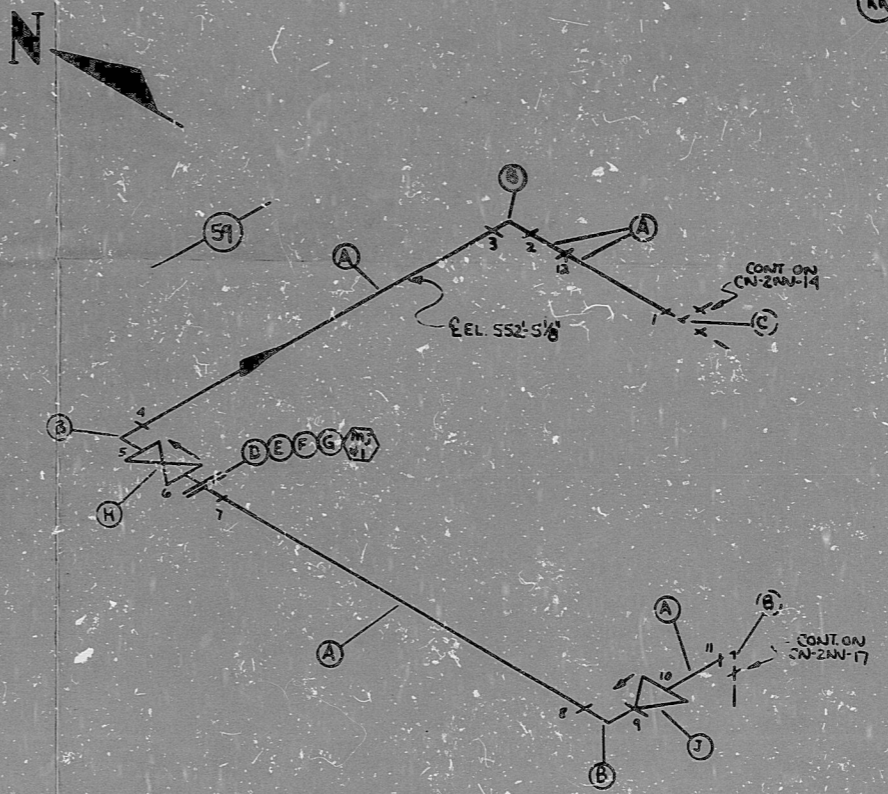

ANSTEC
APERTURE
CARD

NOTES:
 1. ALL WELD NUMBERS SHALL BE PRECEDED BY 2NU15-
 2. LAST WELD NO. 13
 3. REF. LAYOUT DWG. CN-2492-NV074 V.N.
 4. REF. FLOW DWG. CN-2554-17 (E-485)
 5. ALL MECH. PARTS SHALL BE PRECEDED BY 2NU15-
 6. CR. I. FOR INTRK TOSTI
 TEMP 250°F
 PRES 2750 PSIA

FOR INFORMATION ONLY

QA CONDITION 1

NO.	REVISION	DATE	BY
2	DELETED WELD #13		
1			
0	REL FOR CONSTR		

NUCLEAR SAFETY RELATED	YES
DUCS POWER COMPANY	
CRAZYBA NUCLEAR STATION	
TITLE	CHEMICAL AND VOLUME CONTROL SYS
	CENTRIFUGAL CHARGING PUMP 2A 2N. 41.105
SYS. NU	LINE NO. 26
	DWG. CLASS. B
PIPING SPEC.	F-2501.2
LOCATION	AUXILIARY BLDG (A-43)
DWG. NO.	CN-2NU-15
REV. NO.	2

PDR RIDS

9003140389

