


AO
VERIFIED

AO
VERIFIED
SYS 2007(09)
24107, 24108

ITEM NO.	DESCRIPTION	QTY	UNIT	REV.	REV. NO.
1	PIPE 1/2" SCH 40	10	FT		
2	PIPE 1/2" SCH 40	10	FT		
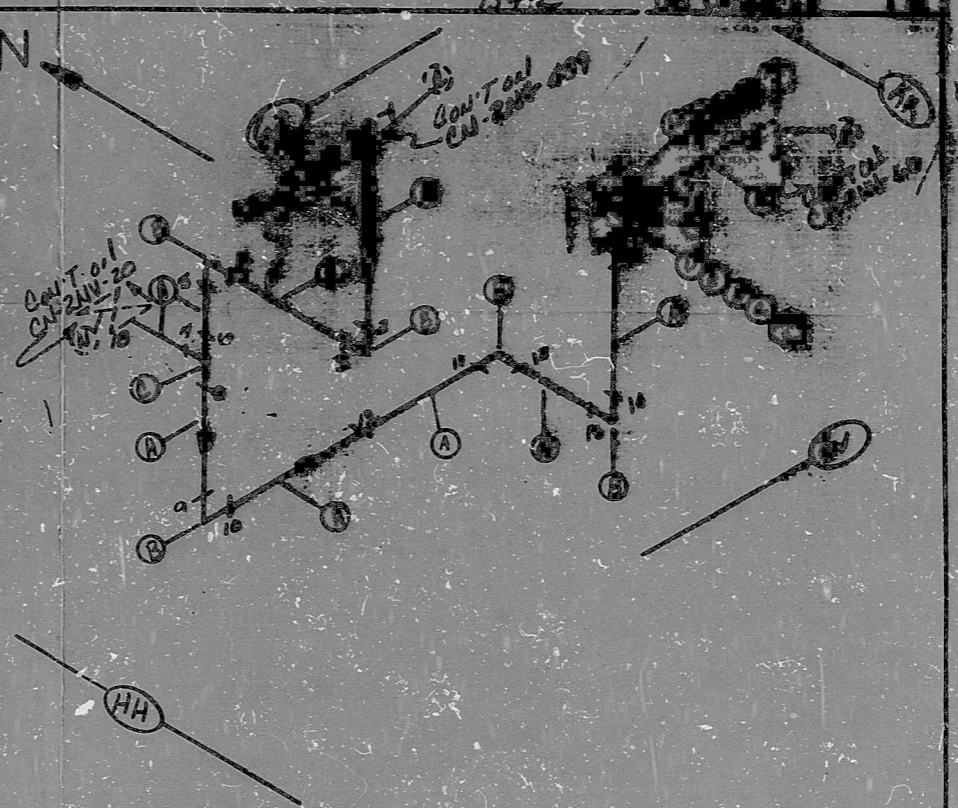

Q A CONDITION 1
NUCLEAR SAFETY RELATED

FOR INFORMATION ONLY

NOTES:
 1 ALL WELD DRAWINGS SHALL BE PRECEDED BY 241023-
 2 LAST WELD NO. 19
 3 DES. LAYOUT DWG. CN-2492-NV186 W/REV 3740
 4 DES. FLOW DWG. CN-2492-NV186 W/REV 3740
 5 CHECK FOR INSERVICE INSPECTION TEMP 250°
 6 ALL MECH. JT. NO'S SHALL BE PRECEDED BY 241023-



NUCLEAR SAFETY RELATED	
MECHANICAL AND VOLUME CONTROL SYS TO VOLUME CONTROL TANK	
SYS. NO. NV 186	LINE NO. 23
FORM SPEC. PS 151.2	DATE CLASS. B
LOCATION BULK BLDG	A-43
REV. NO. CN-2492-23	REV. DATE 11/19

ANSTEC
APERTURE
CARD

PDR RIDS

9603140396

