


AO  
VER: 3  
SYS: 24172

AO  
VERIFIED  
SYS: 24172  
24172, 30

REF. NO.	DATE	DESCRIPTION	BY	CHKD.	APP.
A	1/13	...	...	...	...
B	1/15	...	...	...	...
C	1/15	...	...	...	...
D	1/15	...	...	...	...
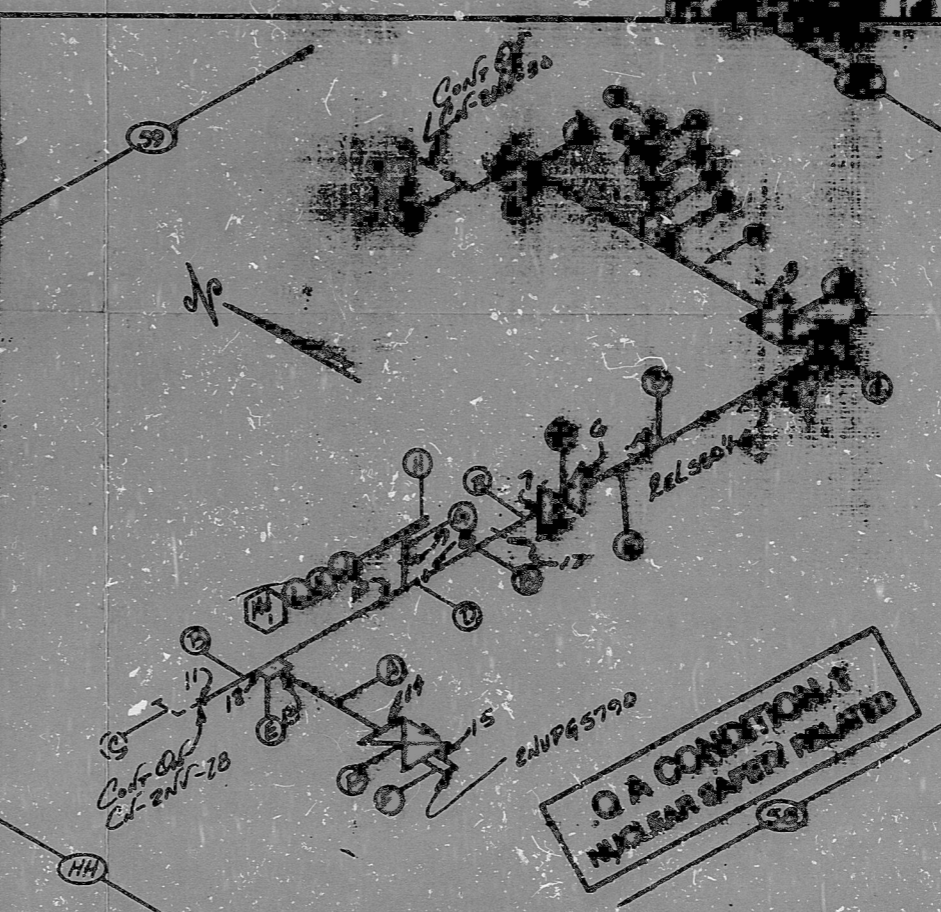

- NOTES:
- 1. ALL WELD NUMBERS SHALL BE PRECEDED BY 24172 -
  - 2. LAST WELD NO. 24
  - 3. WELD LAYOUT DWG. CT-2492-NR095 / NCT # 1132 / UNAPPROVED
  - 4. WELD LAYOUT DWG. CT-2554-17 (E-10 THRU 12)
  - 5. CHECK FOR INSURVICE INFORMATION. TEMP. 175°F. PARTS 235 PISA
  - 6. ALL MECH. JOINTS NO SHALL BE PRECEDED BY 24172 -

FOR INFORMATION ONLY

NO.	DESCRIPTION
6	...
5	...
4	...
3	...
2	...
1	...
0	...

NUCLEAR SAFETY RELATED	
DATE POWER COMPANY	...
CAMERA NUCLEAR SECTION	...
WELD QUANTAL AUTO VOLTAGE CONTROL SYSTEM - To Confirmed	...
STL NO. 13	...
DATE CLASS	...
ISSUED BY: P. J. 300	...
LOCATION: ...	...
...	...

ANSTEC  
APERTURE  
CARD

PDR RIDS

960314041e

