


848

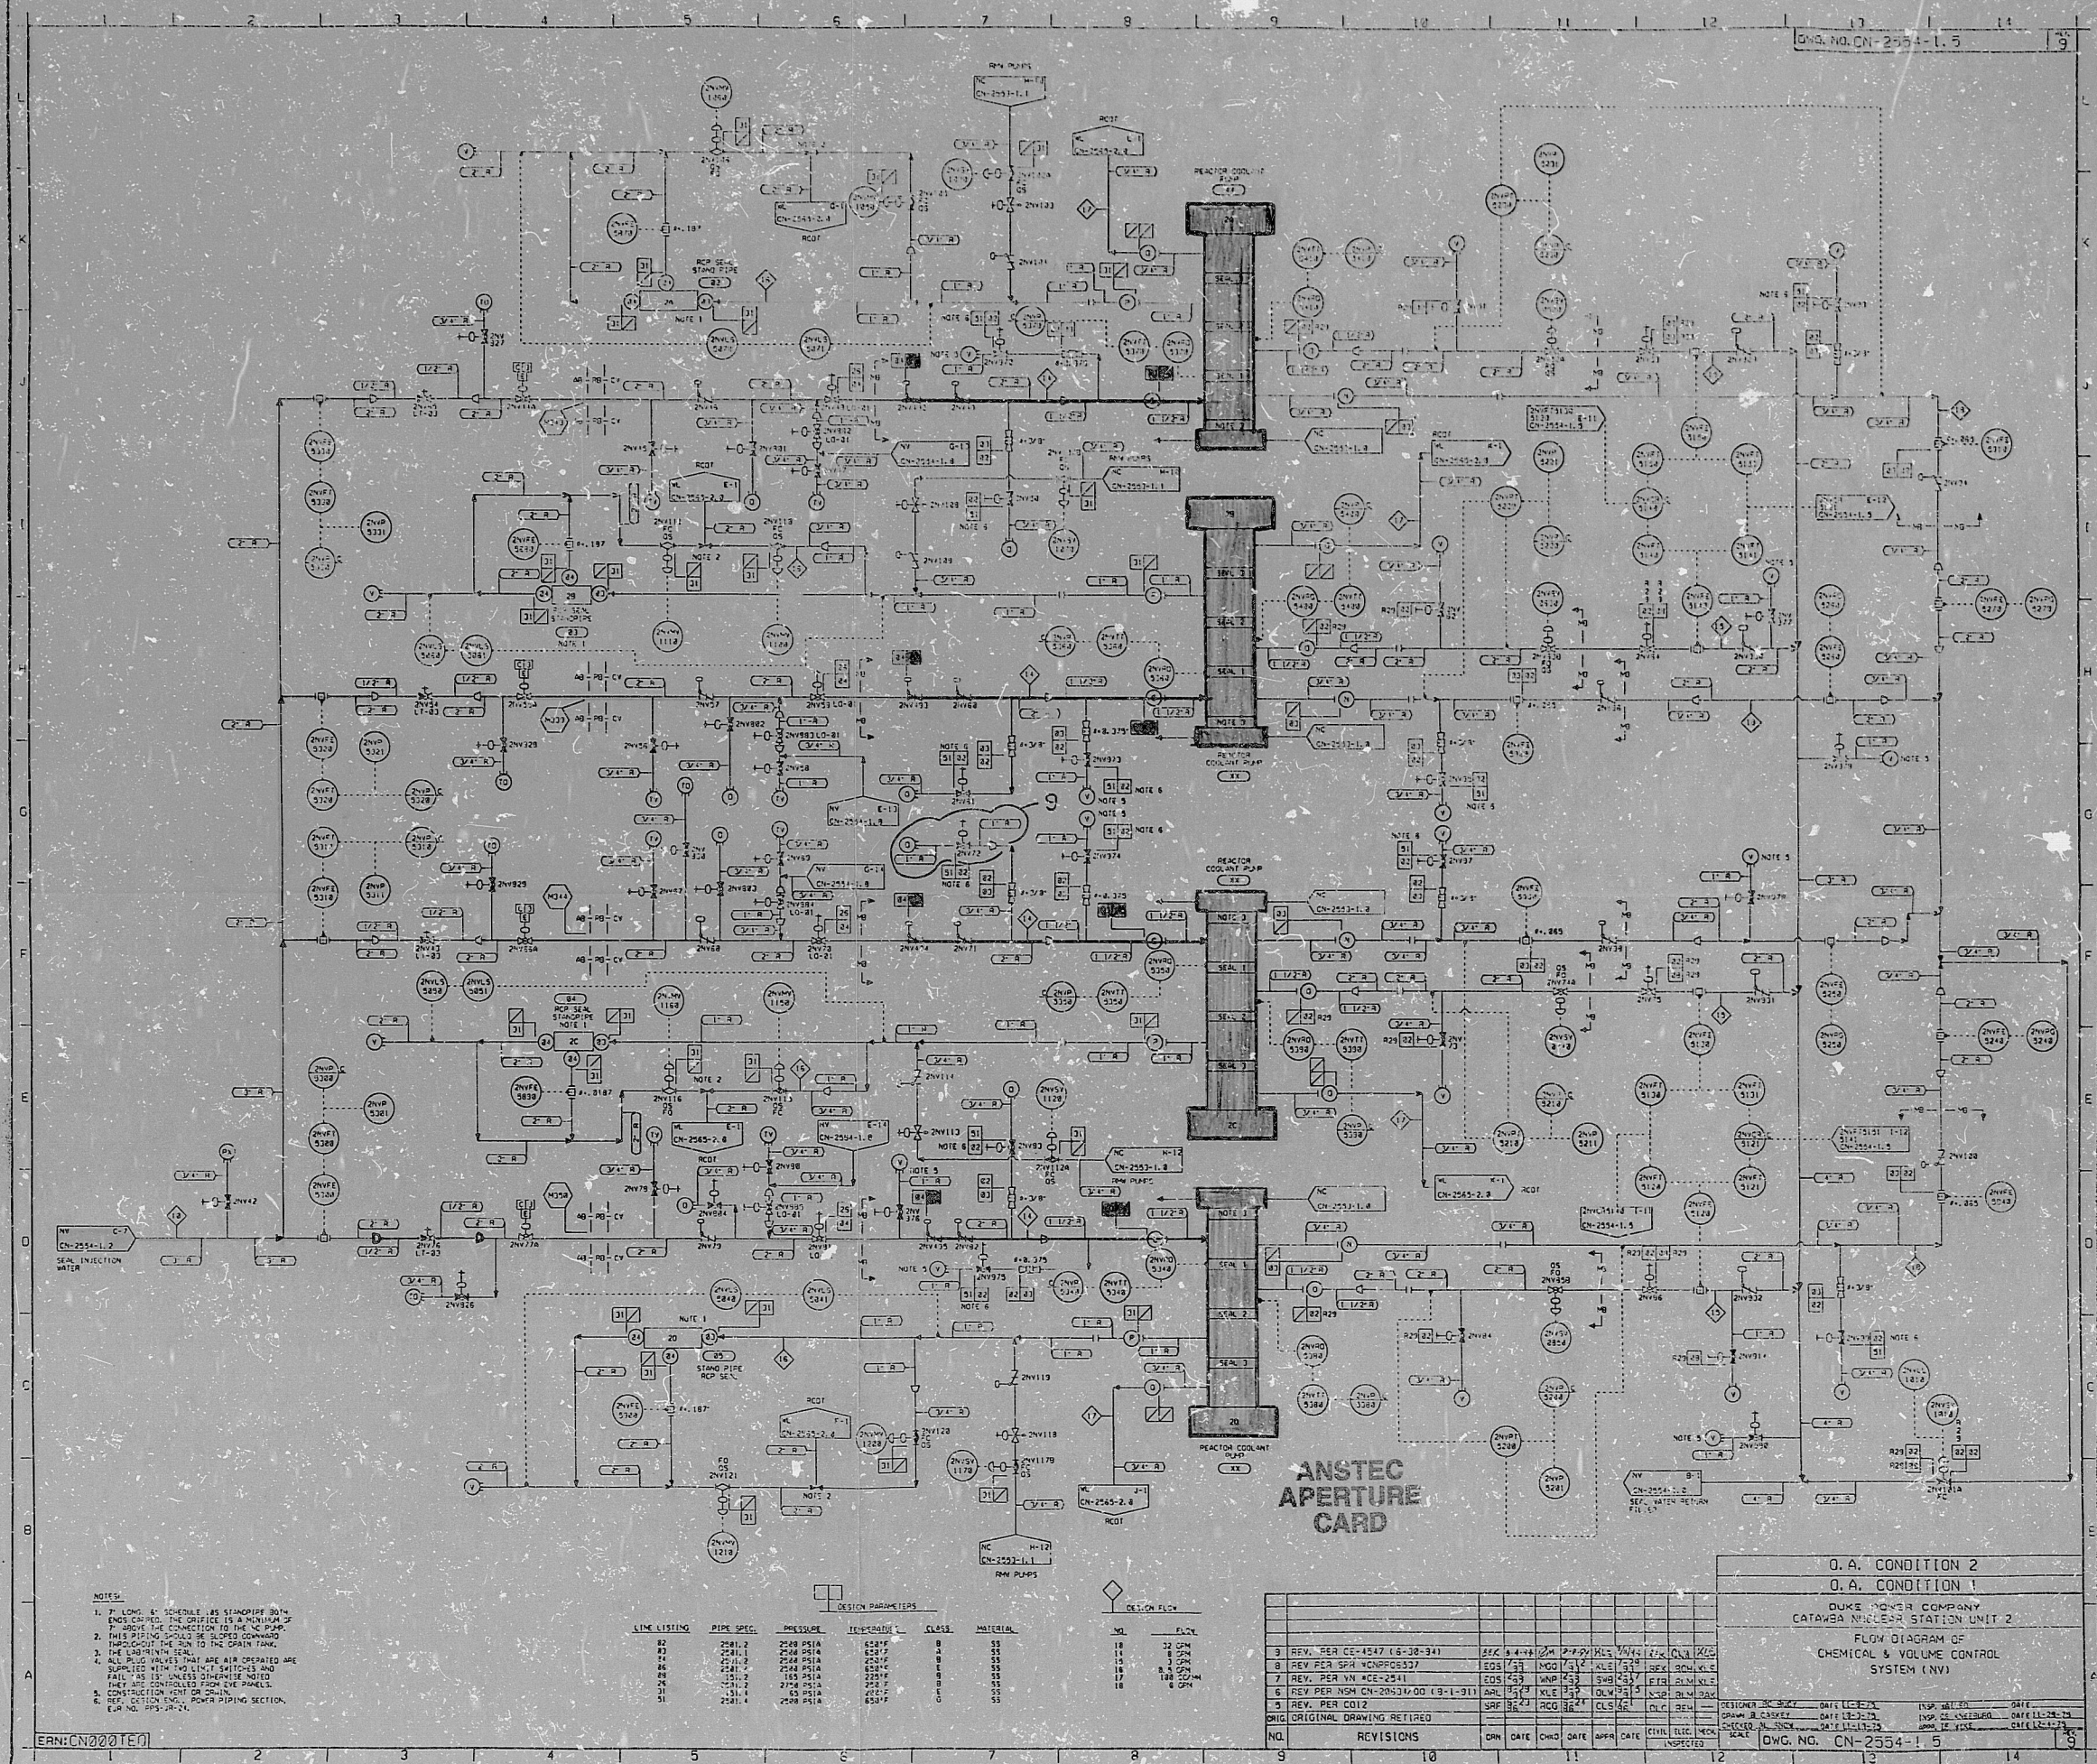

PDR RIDS

9603180013

