
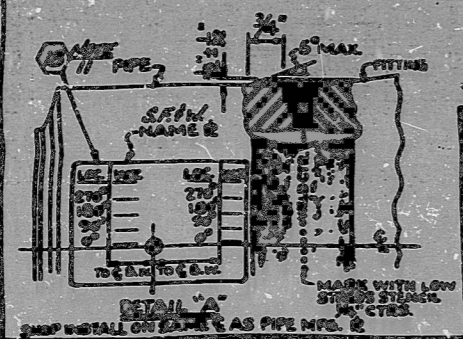


ANSTEC
APERTURE
CARD


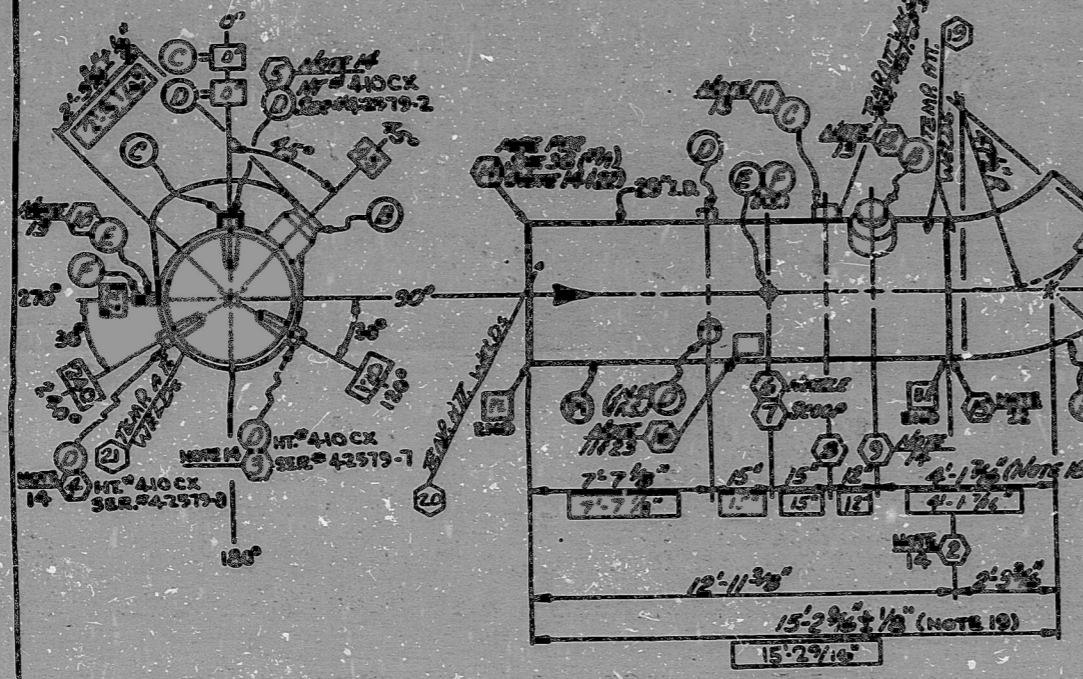

13934
 (Manufacturer's Serial No.)
 1979
 (Year Built)
 I-REQ'D MK:DDP-LOOP-2-A-1

- ASME III 1998 EDITION
 § CODE CASE 1423-2
FOR INFORMATION ONLY


NUCLEAR SAFETY RELATED
 CRW2: / 1
 49
 SAG-RVN-17078-BN
 DDP-DCP05B-01

NO.	REVISION	DATE
1	ADDED AS BUILT DATA	Jm 92579
2	RELEASED ITEM B,C,D,E,F	18 820
3	ORIGINAL ISSUE	18 420
4		
5		

PDR BIDS

9603180089

