
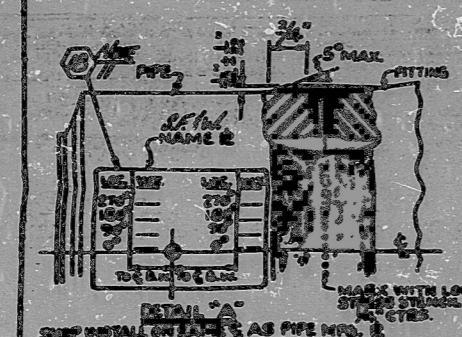


ANSTEC
APERTURE
CARD

FIELD END DIMENSIONAL CHECK	


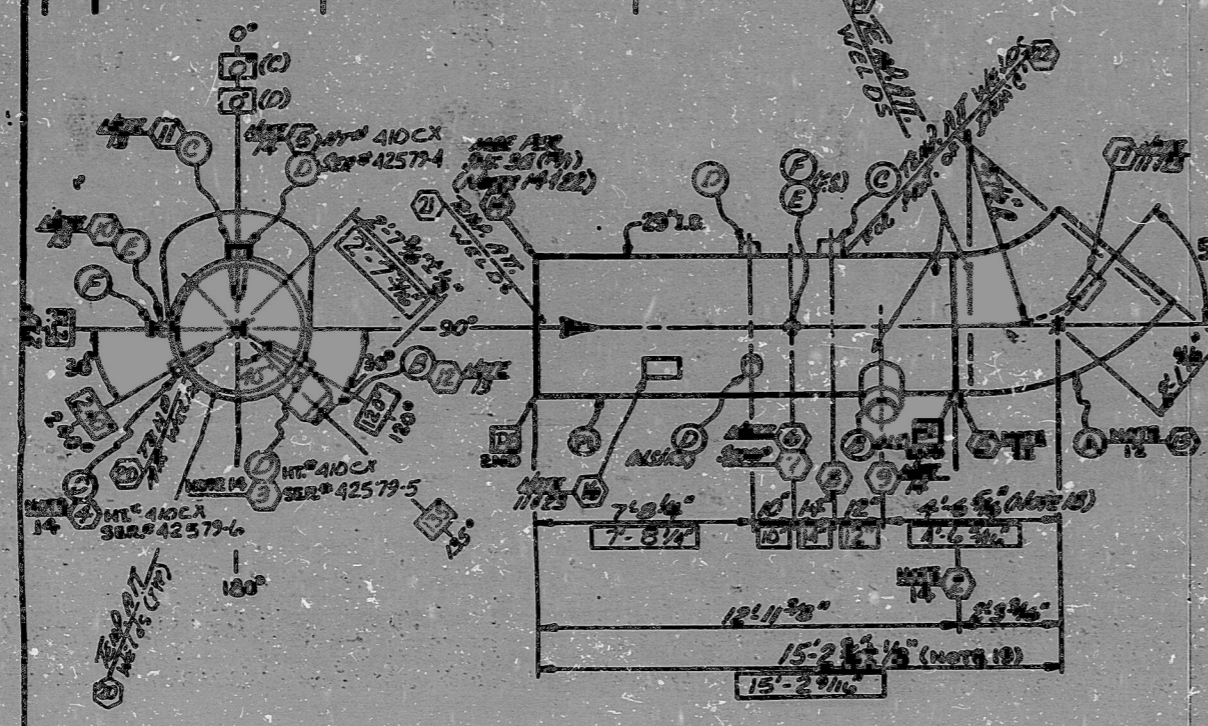

NOTE 1
SOUTHWEST FABRICATING
LOS ANGELES CO.
(Name of Manufacturer)
.....18992.....
(Manufacturer's Serial No.)
.....1979.....
(Year Built)

1-REQD MK:DDP-100P-2-C-1

- ANSI Z39.18-1968
CODE CASE 1423-2

FOR INFORMATION ONLY
346 CVR-174713-BN NUCLEAR SAFETY RELATED
DDP-ROCFB-07

ADDRESS BUILT DATA	NO.	DATE
RELEASED ITEM O.C.D.E.F	15	8-2-73
ORIGINAL ISSUE	15	8-2-73
REVISION	CHKD	DATE

PDR RIDS

9403180115

