
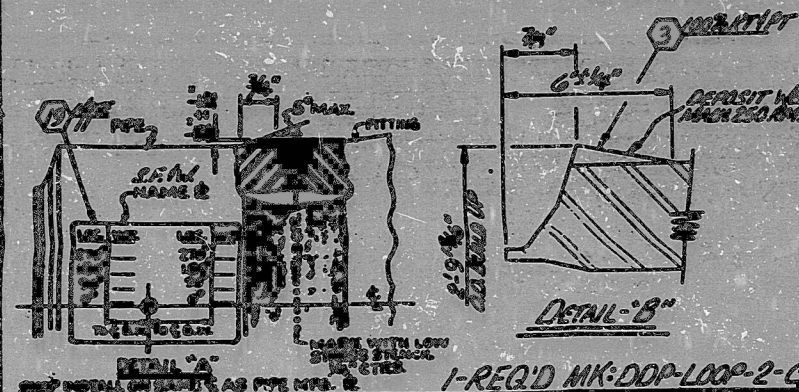


ANSTEC
APERTURE
CARD


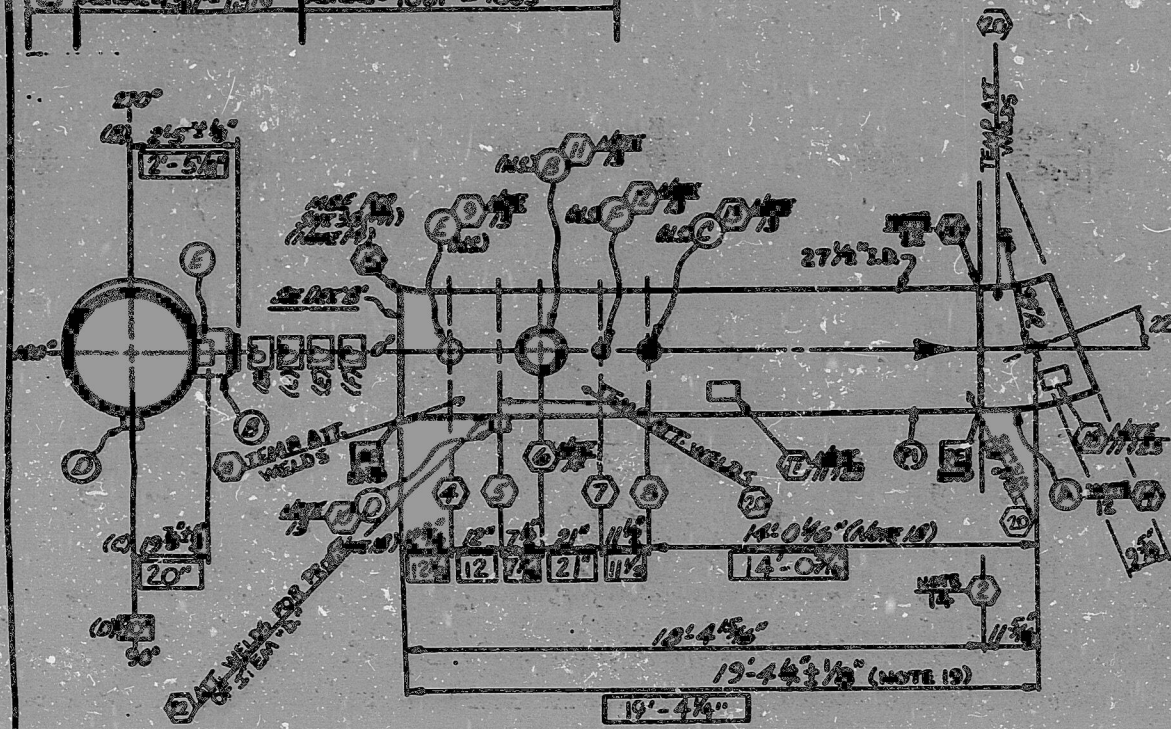

NOTE: 1-1/2"
SOUTHWEST FABRICATORS
AND WELDING CO.
(Name of Manufacturer)
18995
(Manufacturer's Serial No.)
1919
(Year Built)

1-REQ'D MK:DDP-LOOP-2-C-5

- NOTE: SEE 18995 SERIAL NO. 18995 & CODE CASE 1428-2
NO.	DESCRIPTION	DATE	BY	CHKD.	APP'D.
1					
2					
FOR INFORMATION ONLY

NUCLEAR SAFETY RELATED
54G-CVH 174-18-EM
DDP-RPCFB-09

52

NO.	DESCRIPTION	DATE	BY	CHKD.	APP'D.
1	ADDED AS BUILT DATA	1-2-79
2	REPLINER C.D. REAF	1-2-79
3	ORIGINAL ISSUE	1-2-79
4	REVISION

PDR RIDS

9603180120

