
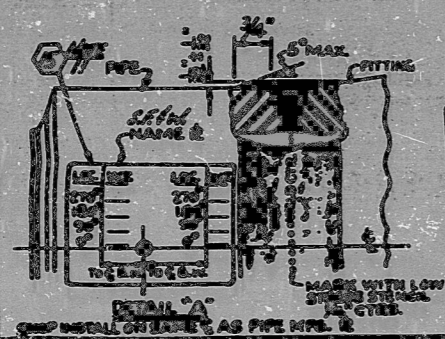


ANSTEC
APERTURE
CARD

WELD END DIMENSIONAL CHECKS		WALL THICKNESS AND WELD JOINT LOCATION	

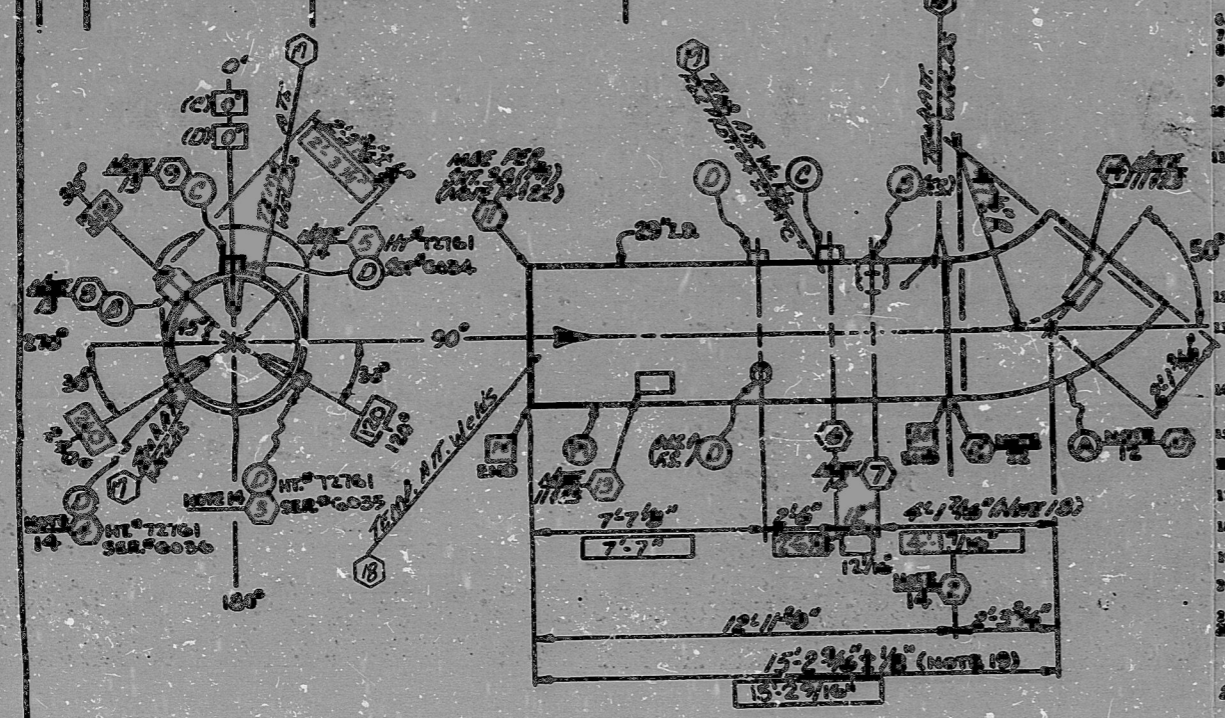

NOTE ①
N
PT
1
12826
(Manufacturer's Serial No.)
1979
(Year Built)
1-REQ'D MK: DDP-LOOP-2-D-1

- USE OF 1/2" DIA. ANSTEC 44
6000 CASE 1473-2
1			
2			
NUCLEAR SAFETY RELATED

44

FOR INFORMATION ONLY

ADDED AS BUILT DATA	7/1 01-79
RELEASED ITEM B.C.A.D	8-2-79
ORIGINAL ISSUE	4-28-78
NO.	REVISION

60-100

ANSTEC 44





PDR RID'S

9603180121

