


THIS DRAWING AND THE DESIGN IT COVERS ARE THE PROPERTY OF BECHTEL. THEY ARE HEREBY LOANED AND ON THE LOANER'S BEHALF EXPRESSLY WARRANTED THAT THEY WILL NOT BE REPRODUCED, COPIED, LOANED, EXHIBITED, OR USED EXCEPT IN THE MANNER AND FOR THE PURPOSES FOR WHICH THEY WERE LOANED. ANY AND ALL RIGHTS ARE RESERVED BY BECHTEL. ANY VIOLATION OF THESE TERMS SHALL BE CONSIDERED A BREACH OF CONTRACT AND WILL BE SUBJECT TO THE FULL AND COMPLETE REMEDY OF BECHTEL.

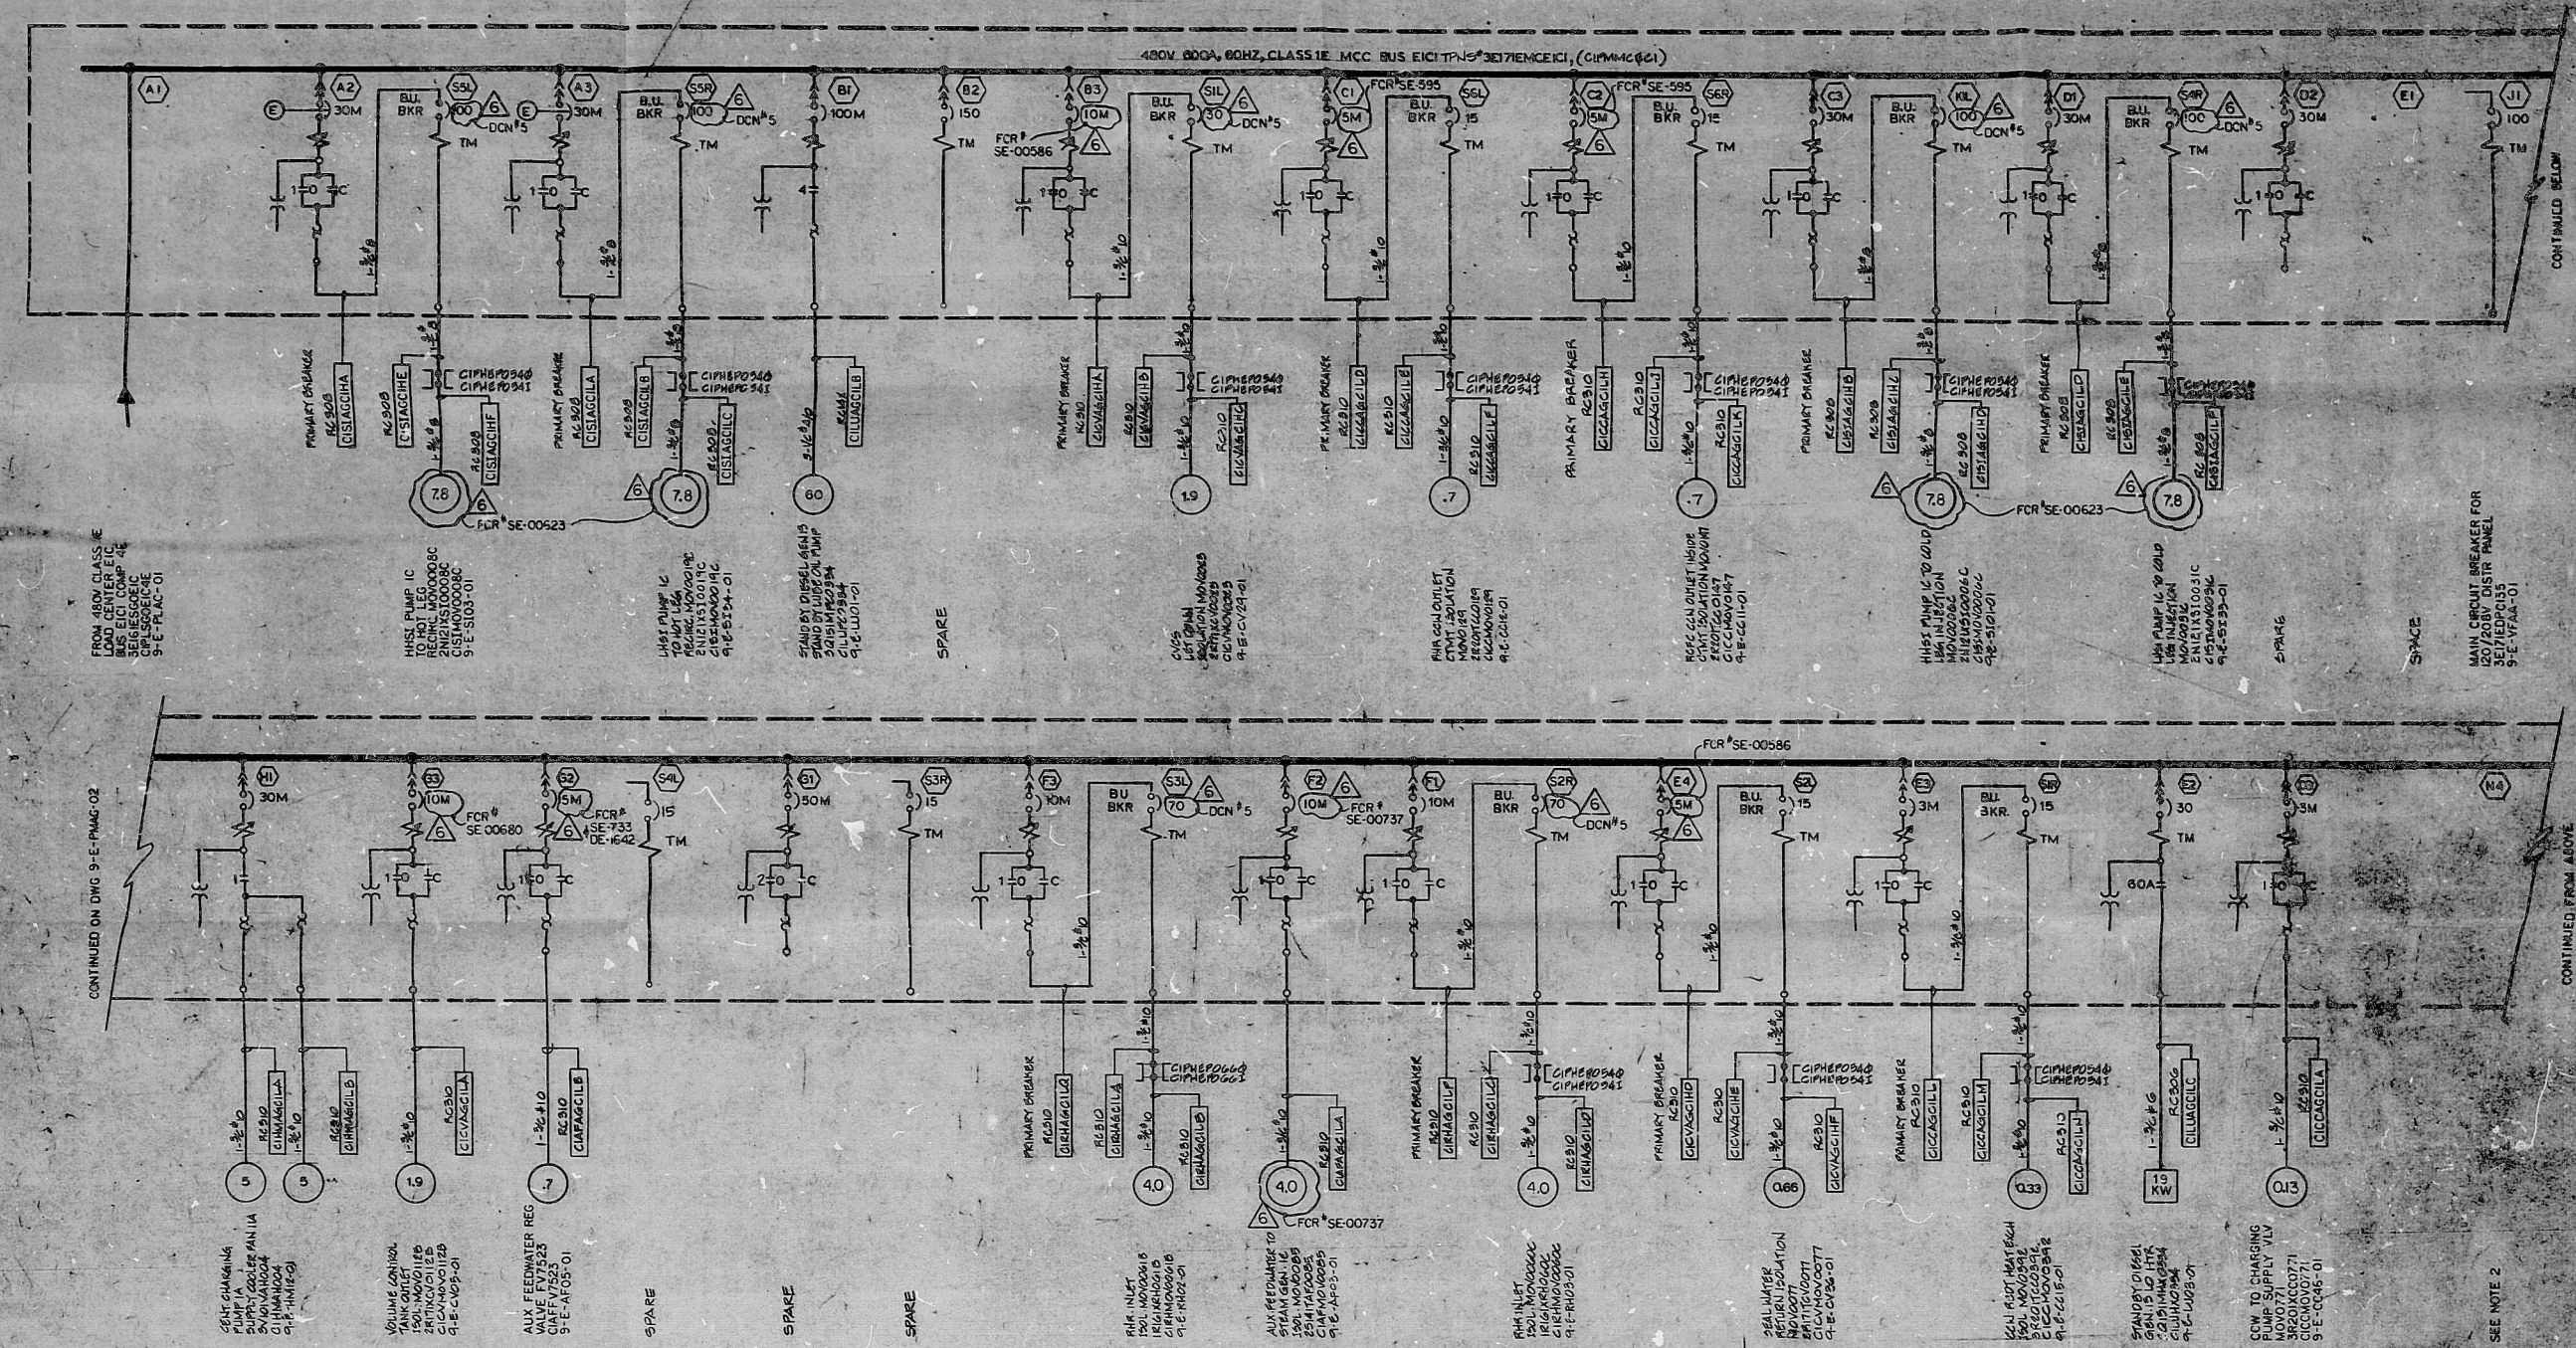

- NOTES:
1. FOR LEGEND & SYMBOLS REFER TO DWGS. 9-E-N201-01 & 02.
 2. SPACE HEATER POWER DIST. PANEL 120/208V, 300KT 3E17EDPC135 IS LOCATED IN COMPT (N) REF. DWG. 9-E-VFAA-01.
 3. THIS DWG. SUPERSEDES 8 & 9 DWG. 9-E-51-1-E-1235.

TI
APERTURE
CARD

HOUSTON OFFICE ISSUED
INFORMATION ONLY
STP 14020

REV	DATE	BY	CHKD	APPD	DESCRIPTION
HOUSTON LIGHTING & POWER CO.
SOUTH TEXAS PROJECT

NUCLEAR POWER PLANT
SINGLE LINE DIAGRAM
480V CLASS 1E MOTOR CONTROL CENTER

PDR RIDS

8701290489

