


TABLE ONE

CUBICLE NO. INDICATED ON ONE LINE DWG	CORRESPONDING CUBICLE NO. INDICATED ON EQUIPMENT	LOCATION NO. INDICATED ON CUBICLE'S NAMEPLATE
1	1B	DIDJPL03781
2	1A	DIDJPL03781A
3	2A	DIDJPL03782
4	3A	DIDJPL03783
5	3B	DIDJPL03784
6	4B	DIDJPL03785
7	5C	DIDJPL03786
8	6B	DIDJPL03787
9	6A	DIDJPL03788
10	2B	DIDJPL03789

THIS DRAWING AND THE DESIGN IT COVERS ARE THE PROPERTY OF BECHTEL. THEY ARE MERELY LOANED AND ON THE BORROWER'S EXPRESS AGREEMENT THAT THEY WILL NOT BE REPRODUCED, COPIED, LOANED, EXHIBITED, OR USED EXCEPT IN THE LIMITED WAY AND PRIVATE USE PERMITTED BY THE LENDER TO THE BORROWER.

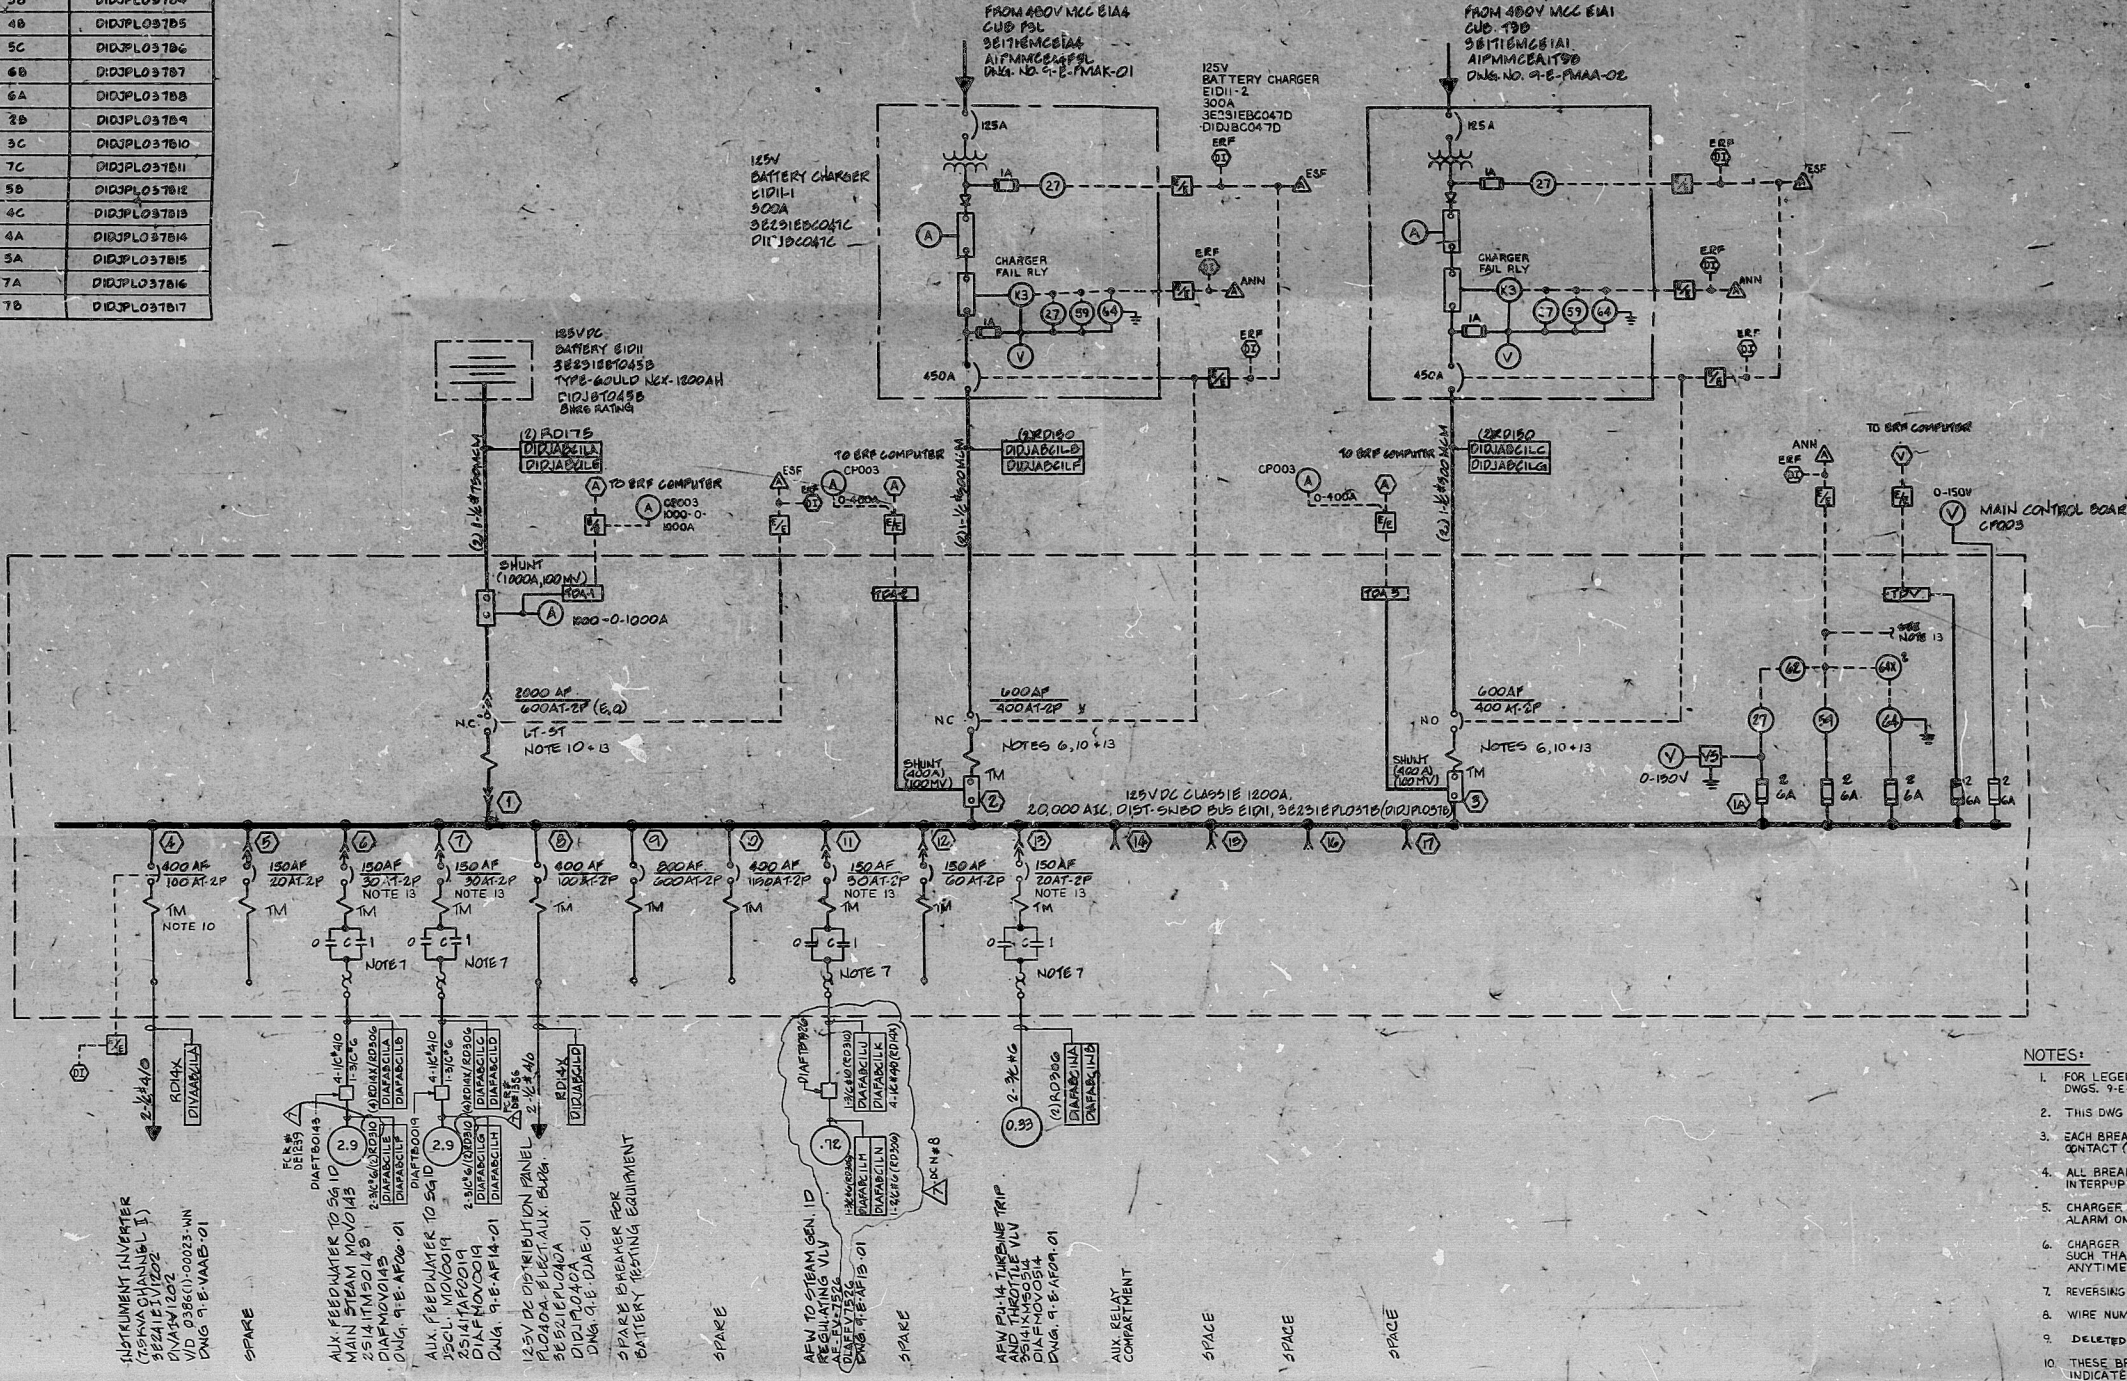

- NOTES:
- FOR LEGEND AND SYMBOLS REFER TO DWGS. 9-E-N201-01 AND 9-E-N201-02.
 - THIS DWG SUPERSEDES B+ DWG 4-E-521-E-1411.
 - EACH BREAKER HAS AN OVERLOAD BELL ALARM CONTACT (OPEN TO ALARM).
 - ALL BREAKERS SHALL HAVE AT LEAST 20,000 AMP INTERRUPTING CAPACITY AT 250VDC.
 - CHARGER DC OUTPUT BREAKER SHALL PROVIDE ALARM ON OPENING.
 - CHARGER BREAKERS ARE MECHANICALLY INTERLOCKED SUCH THAT ONLY ONE BREAKER IS CLOSED AT ANYTIME.
 - REVERSING FULL VOLTAGE DC COMBINATION STARTER.
 - WIRE NUMBERS FOR 125V DC FEEDS ARE P AND N.
 - DELETED
 - THESE BREAKERS HAVE AUXILIARY CONTACT TO INDICATE BKR POSITION, WHICH ARE WIRED SEPARATELY TO ERF COMPUTER.
 - ANNUNCIATOR WINDOWS AND COMPUTER POINTS FOR BUS STATUS MONITORING, SEE MBD DWG. 9-E-DJ10-02.
 - OUTPUT OF TRANSDUCERS ARE 4-20MA EXCEPT FOR TDA-1 WHICH HAS 4-12-20MA OUTPUT.
 - "SWD PROBLE" ALARM INPUT CONSISTS OF SERIES CONNECTED N.C. CONTACTS OF DEV. 59, 64XP, 64XN, 62 AND BELL ALARM SWITCH CONTACTS OF THE FOLLOWING CIRCUIT BREAKERS, BKR #1, 2, 3, 6, 7, 11 + 13.
 - THE FIFTH CHARACTER OF THE TPN NUMBER AND THE SECOND CHARACTER OF THE ESB LOCATION AND CIRCULAR NUMBER WILL BE DESIGNATED "1" FOR UNIT 1. OTHERWISE, "2" DESIGNATES UNIT 2 UNLESS OTHERWISE SHOWN IN BRACKETS. "1" IN WHICH CASE, IT WOULD INDICATE UNKNOWN UNIT 2 INFORMATION ONLY.

HOUSTON OFFICE ISSUED
INFORMATION C-1-Y
SIP 14928

REV	DATE	BY	CHKD	DESCRIPTION
1				
2				
BECHTEL ENERGY CORPORATION
HOUSTON, TEXAS
HOUSTON LIGHTING & POWER CO.
SOUTH TEXAS PROJECT

SINGLE LINE DIAGRAM
125V DC CLASS 1E DIST. SWITCHBOARD
(EAB)
14928 9-E-DJAB-01

PDR RIDS

8701300022

