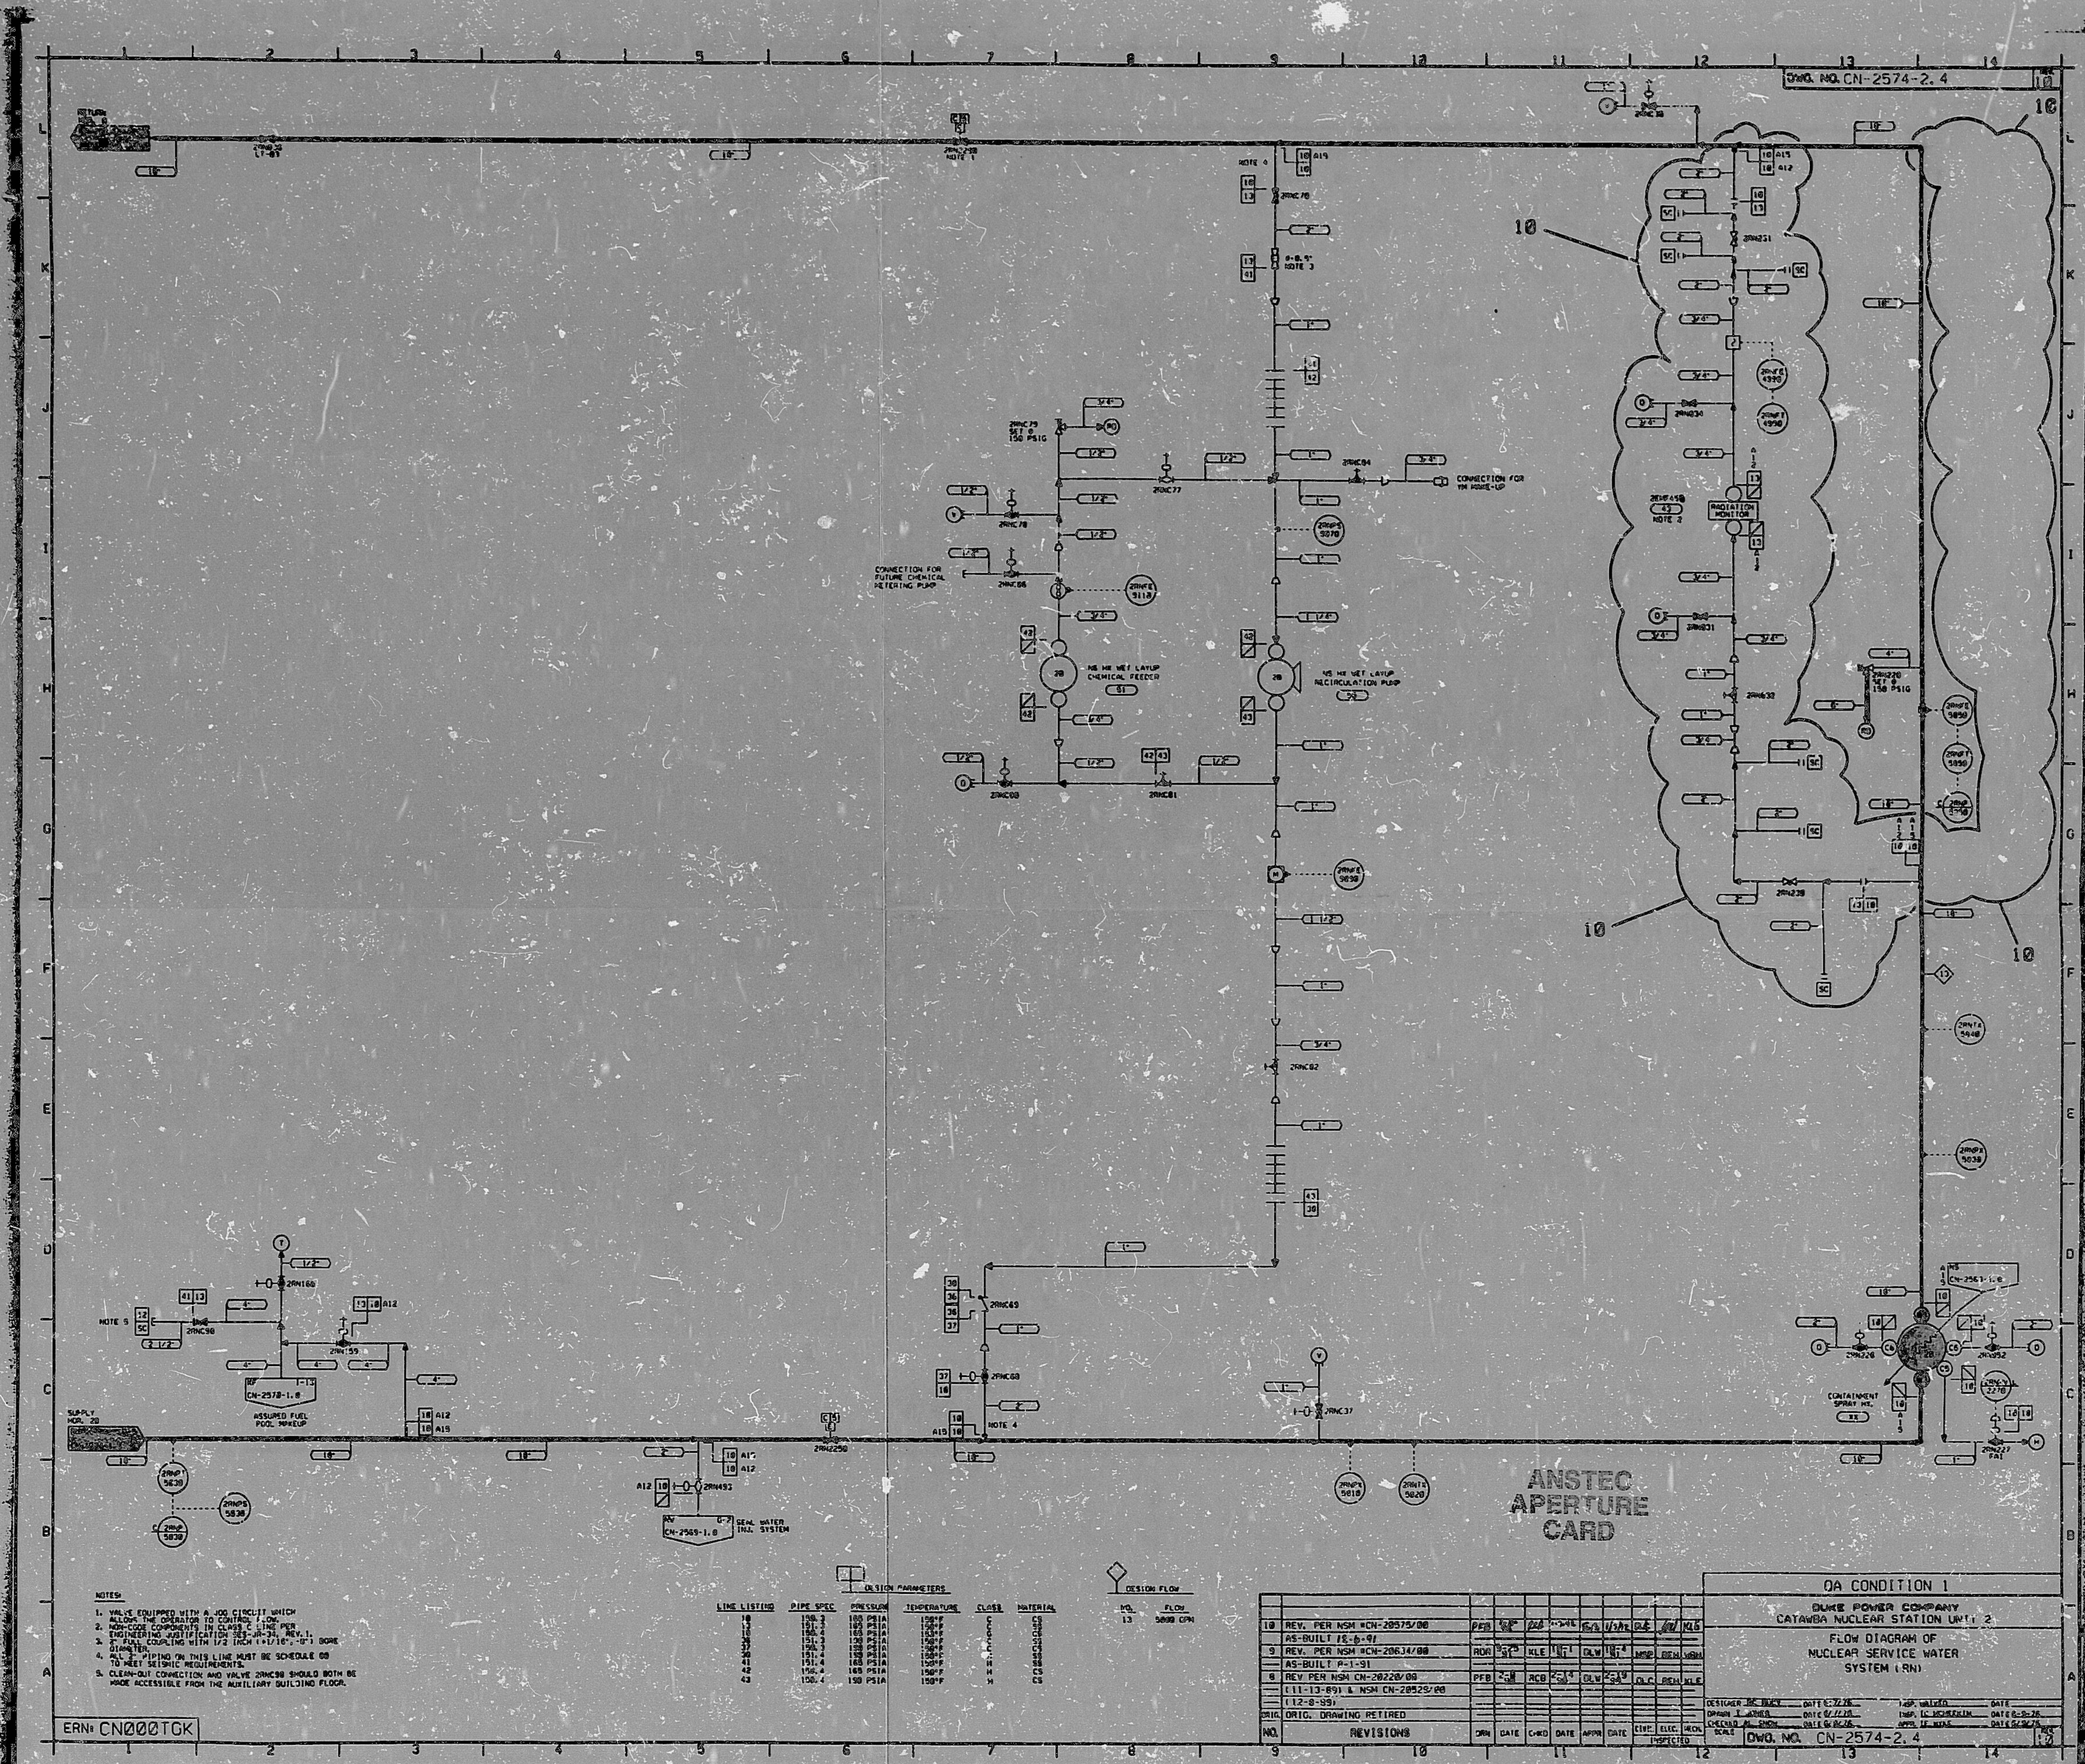
DWG. NO. CN-2574-2.4
NOTES:
1. VALVE EQUIPPED WITH A JOG CIRCUIT WHICH ALLOWS THE OPERATOR TO CONTROL FLOW.
2. NON-CODE COMPONENTS IN CLASS C LINE PER ENGINEERING JUSTIFICATION SES-JR-34, REV. 1.
3. 2" FULL COUPLING WITH 1/2 INCH (+1/16", -0") BORE DIAMETER.
4. ALL 2" PIPING ON THIS LINE MUST BE SCHEDULE 80 TO MEET SEISMIC REQUIREMENTS.
5. CLEAN-OUT CONNECTION AND VALVE 2RNC98 SHOULD BOTH BE MADE ACCESSIBLE FROM THE AUXILIARY BUILDING FLOOR.
DESIGN PARAMETERS
LINE LISTING
PIPE SPEC
PRESSURE
TEMPERATURE
CLASS
MATERIAL
DESIGN FLOW
ERN: CN000TGK
SEAL WATER INJ. SYSTEM
CN-2569-1.0
ASSURED FUEL POOL MAKEUP
CN-2578-1.0
RADIATION MONITOR
CONNECTION FOR FUTURE CHEMICAL METERING PUMP
CONTAINMENT SPRAY HX.
ANSTEC APERTURE CARD
QA CONDITION 1
DUKE POWER COMPANY
CATAWBA NUCLEAR STATION UNIT 2
FLOW DIAGRAM OF NUCLEAR SERVICE WATER SYSTEM (RN)
10 REV. PER NSM #CN-20575/00
AS-BUILT 12-6-91
9 REV. PER NSM #CN-20634/00
AS-BUILT 8-1-91
8 REV PER NSM CN-20220/00
(11-13-89) & NSM CN-20529/00
(12-8-89)
ORIG. ORIG. DRAWING RETIRED
NO. REVISIONS
DRN DATE CHKD DATE APPR DATE
CIVIL ELEC. MECH.
INSPECTED
DESIGNER
DRAWN
CHECKED
SCALE
DATE
DWG. NO. CN-2574-2.4

PDR RIDS

9603190039